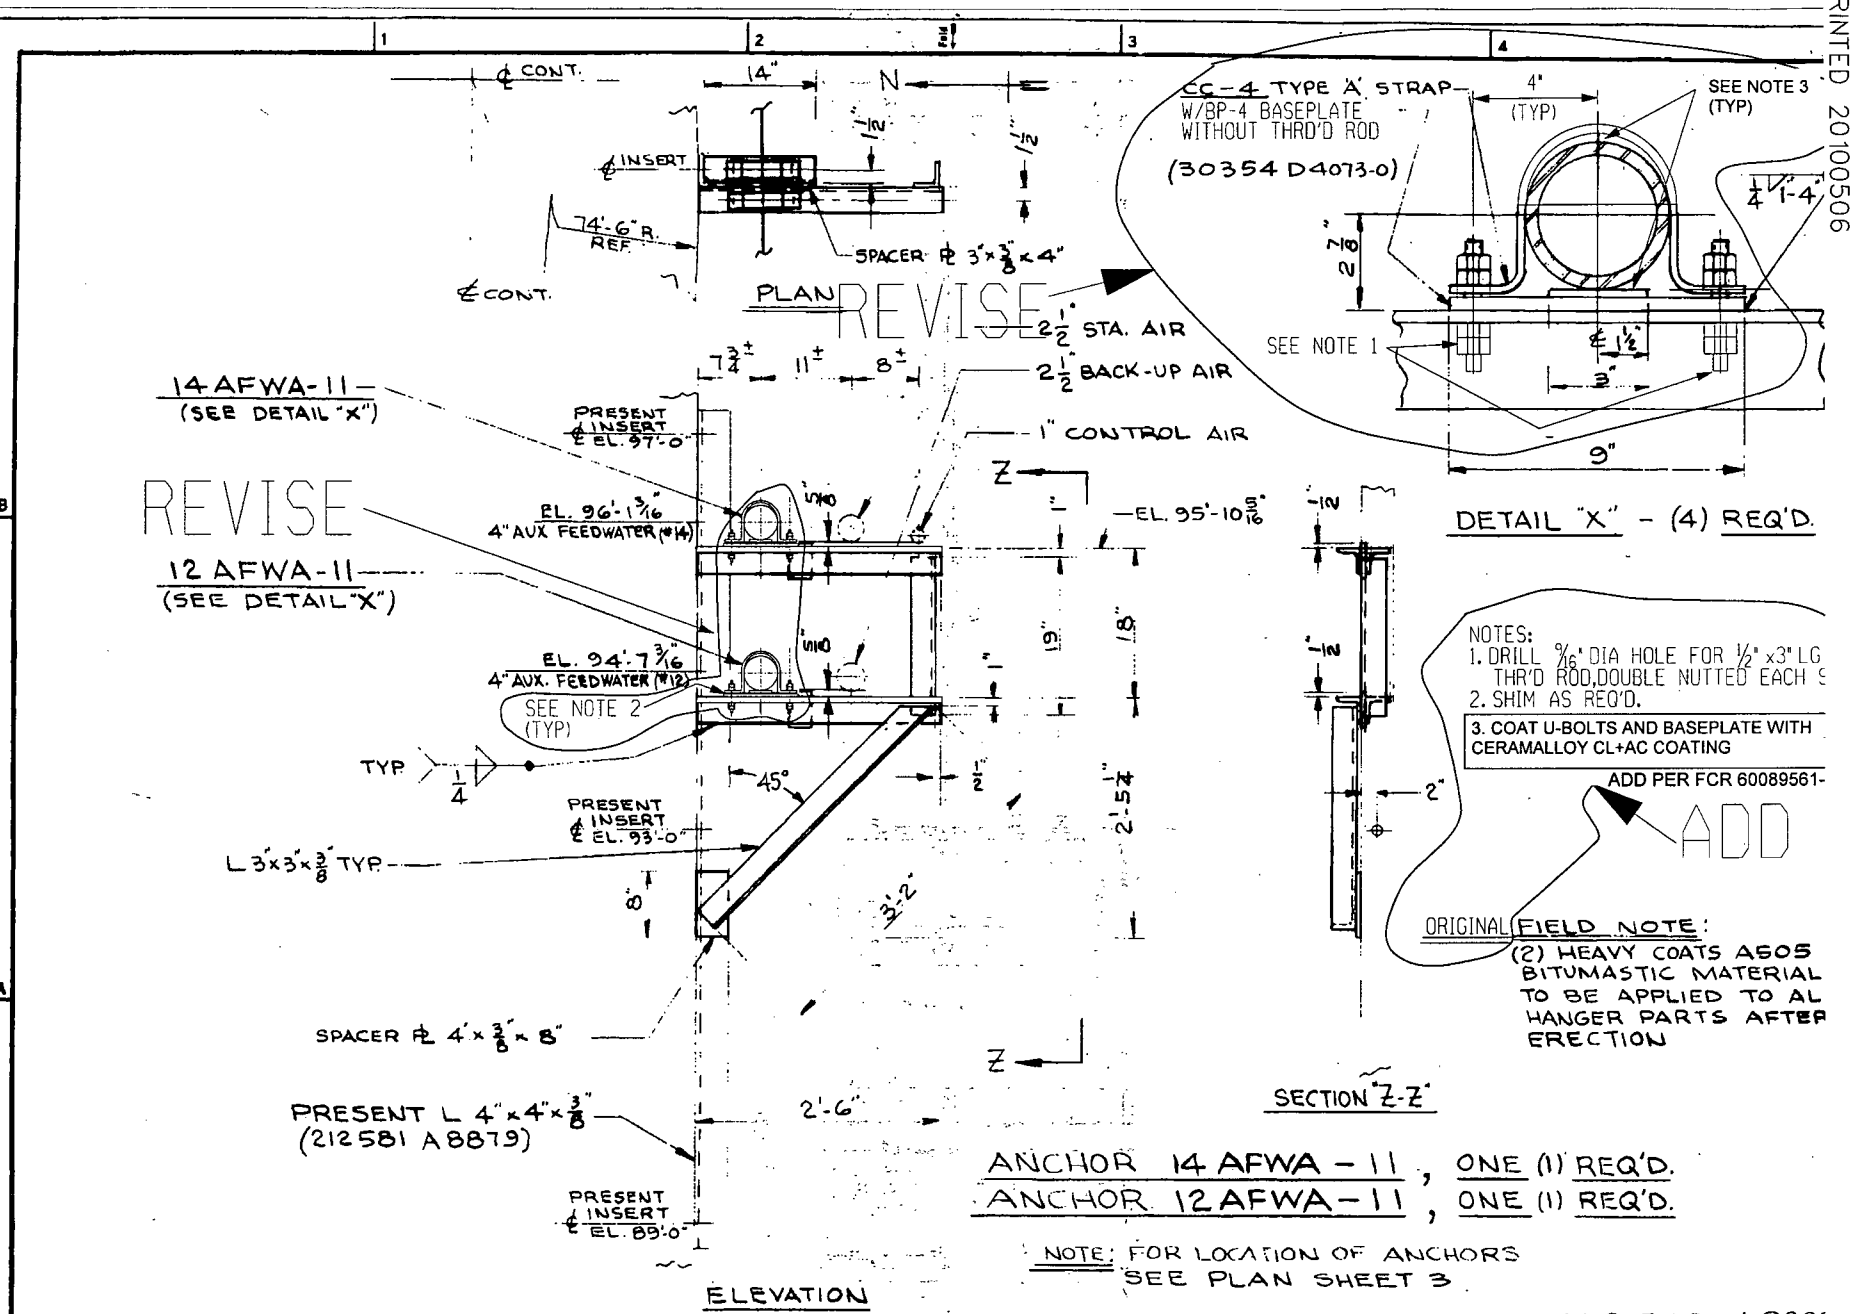

INSTALLED CHANGE DOCUMENT
PRINTED 20100506

REVISION			
3		6	
2		5	
1		4	

80101381R0
H02R1
REVISE PER FCR 60089561-1110

PUBLIC SERVICE ELECTRIC AND GAS COMPANY
ELECTRIC ENGINEERING DEPARTMENT
NEWARK, NEW JERSEY

DATE 12-8-71 DRAWN LR CHECKED A.M.F. EXAMINED

Salem Nuclear Generating Station
No. 1 Unit - Reactor Containment
Auxiliary Feedwater
El. 78'0" & El. 100'0"
Hangers Mechanical

226129D41

SHEET 5 OF 2

5	4	3	2	1	0
ARCH. CK. / ELEC. CK. / MECH. CK. / STRU. CK.	ARCH. CK. / ELEC. CK. / MECH. CK. / STRU. CK.	ARCH. CK. / ELEC. CK. / MECH. CK. / STRU. CK.	ARCH. CK. / ELEC. CK. / MECH. CK. / STRU. CK.	ARCH. CK. / ELEC. CK. / MECH. CK. / STRU. CK.	ARCH. CK. / ELEC. CK. / MECH. CK. / STRU. CK.

INSTALLED CHANGE DOCUMENT
PRINTED 20100506

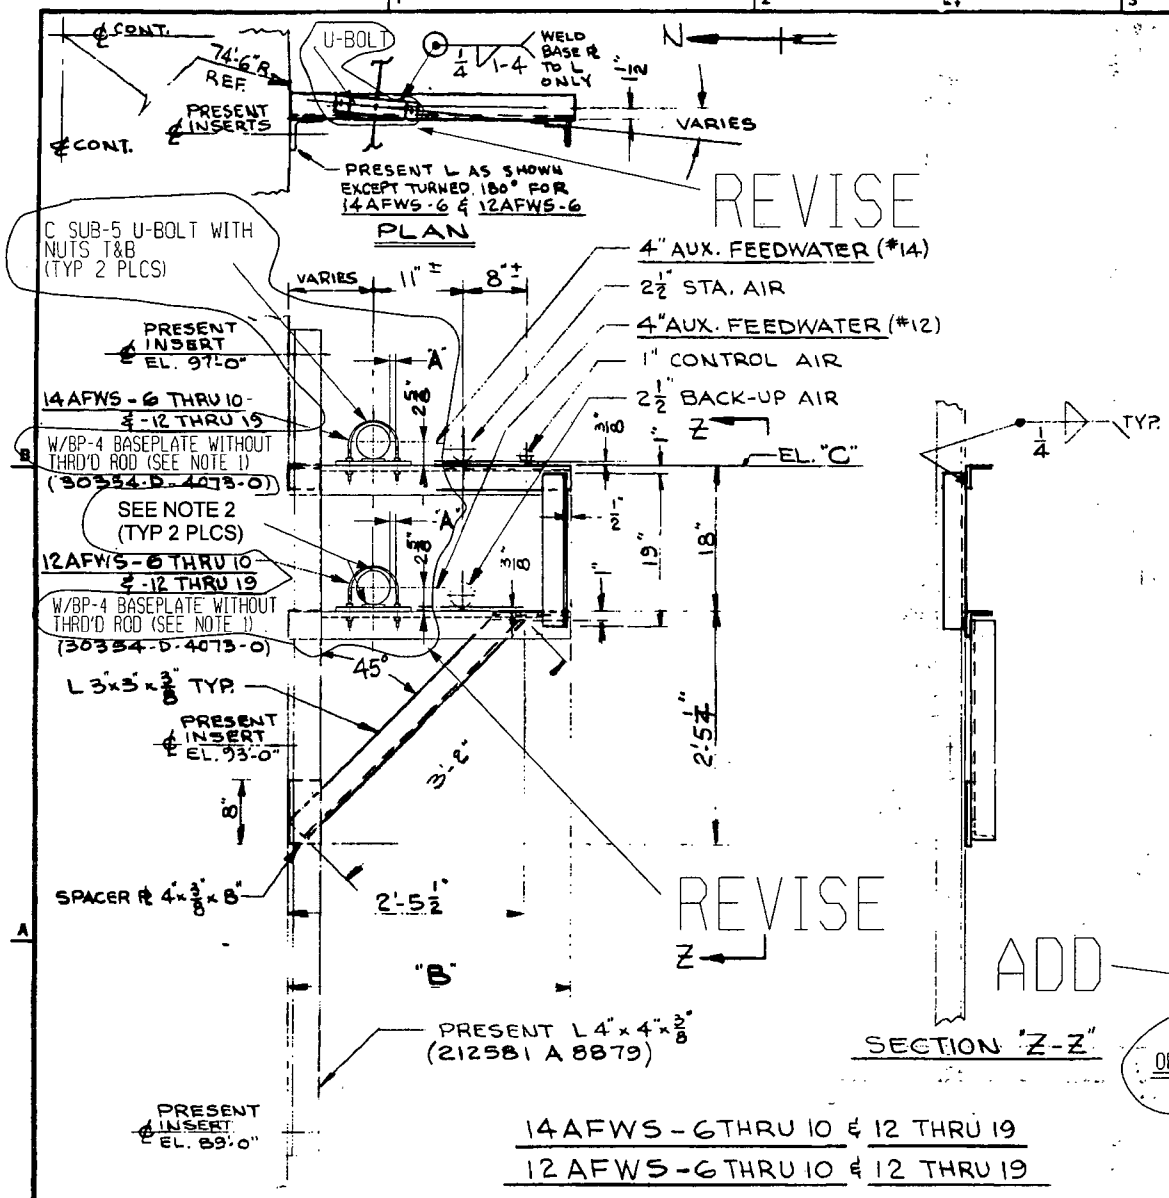

SUPPORT MARK NO.	NO. OF SUPPORTS REQ'D.	NO. OF FRAMES REQ'D.	"A"	"B"	EL. "C"
14AFWS-6	1	1	3/8" MIN.	5'-0"	95'-11 5/16"
12AFWS-6	1				
14AFWS-7	1	1		3'-0"	95'-11 3/16"
12AFWS-7	1				
14AFWS-8	1	1		2'-9"	95'-11 1/16"
12AFWS-8	1				
14AFWS-9	1	1		2'-11"	95'-10 7/8"
12AFWS-9	1				
14AFWS-10	1	1		2'-9"	95'-10 3/4"
12AFWS-10	1				
14AFWS-12	1	1		2'-11"	95'-10 3/8"
12AFWS-12	1				
14AFWS-13	1	1		2'-11"	95'-10 1/4"
12AFWS-13	1				
14AFWS-14	1	1		2'-7"	95'-10 1/8"
12AFWS-14	1				
14AFWS-15	1	1		2'-9"	95'-9 15/16"
12AFWS-15	1				
14AFWS-16	1	1		3'-1"	95'-9 13/16"
12AFWS-16	1				
14AFWS-17	1	1		3'-5"	95'-9 5/8"
12AFWS-17	1				
14AFWS-18	1	1		4'-3"	95'-9 7/16"
12AFWS-18	1				
14AFWS-19	1	1		4'-6"	95'-9 3/8"
12AFWS-19	1				

REVISE

NOTES:
1. DRILL 9/16" DIA HOLE FOR ½" U-BOLTS (TYP)
2. COAT U-BOLTS AND BASEPLATE WITH CERAMALLOY CL+AC COATING

ADD PER FCR 60089561-1110

ORIGINAL FIELD NOTE:
(2) HEAVY COATS A505 BITUMASTIC MATERIAL TO BE APPLIED TO ALL HANGER PARTS AFTER ERECTION

14AFWS-6 THRU 10 & 12 THRU 19
12AFWS-6 THRU 10 & 12 THRU 19

NOTE: FOR LOCATION OF SUPPORTS SEE PLAN SHEET 3

REF: 207483 A 8923

No	DESCRIPTION	DATE	DWN	CKD	EXD.
2	REVISED "B" DIM. FOR 14AFWS-6 & 12AFWS-6 PER AS BUILT DWGS.	11-8-94	RC	TWC	
REVISION					

80101381R0
H01R1
REVISE PER FCR 60089561-1110

Salem Nuclear Generating Station
No. 1 Unit - Reactor Containment
Auxiliary Feedwater
El. 78'0" & El. 100'0"
Hangers — Mechanical

226129D4

SHEET 4 OF 24

5 ARCH. CK. ELEC. CK. MECH. CK. STRU. CK. | 4 ARCH. CK. ELEC. CK. MECH. CK. STRU. CK. | 3 ARCH. CK. ELEC. CK. MECH. CK. STRU. CK. | 2 ARCH. CK. ELEC. CK. MECH. CK. STRU. CK. | 1 ARCH. CK. ELEC. CK. MECH. CK. STRU. CK. | 0 ARCH. CK. ELEC. CK. MECH. CK. STRU. CK.