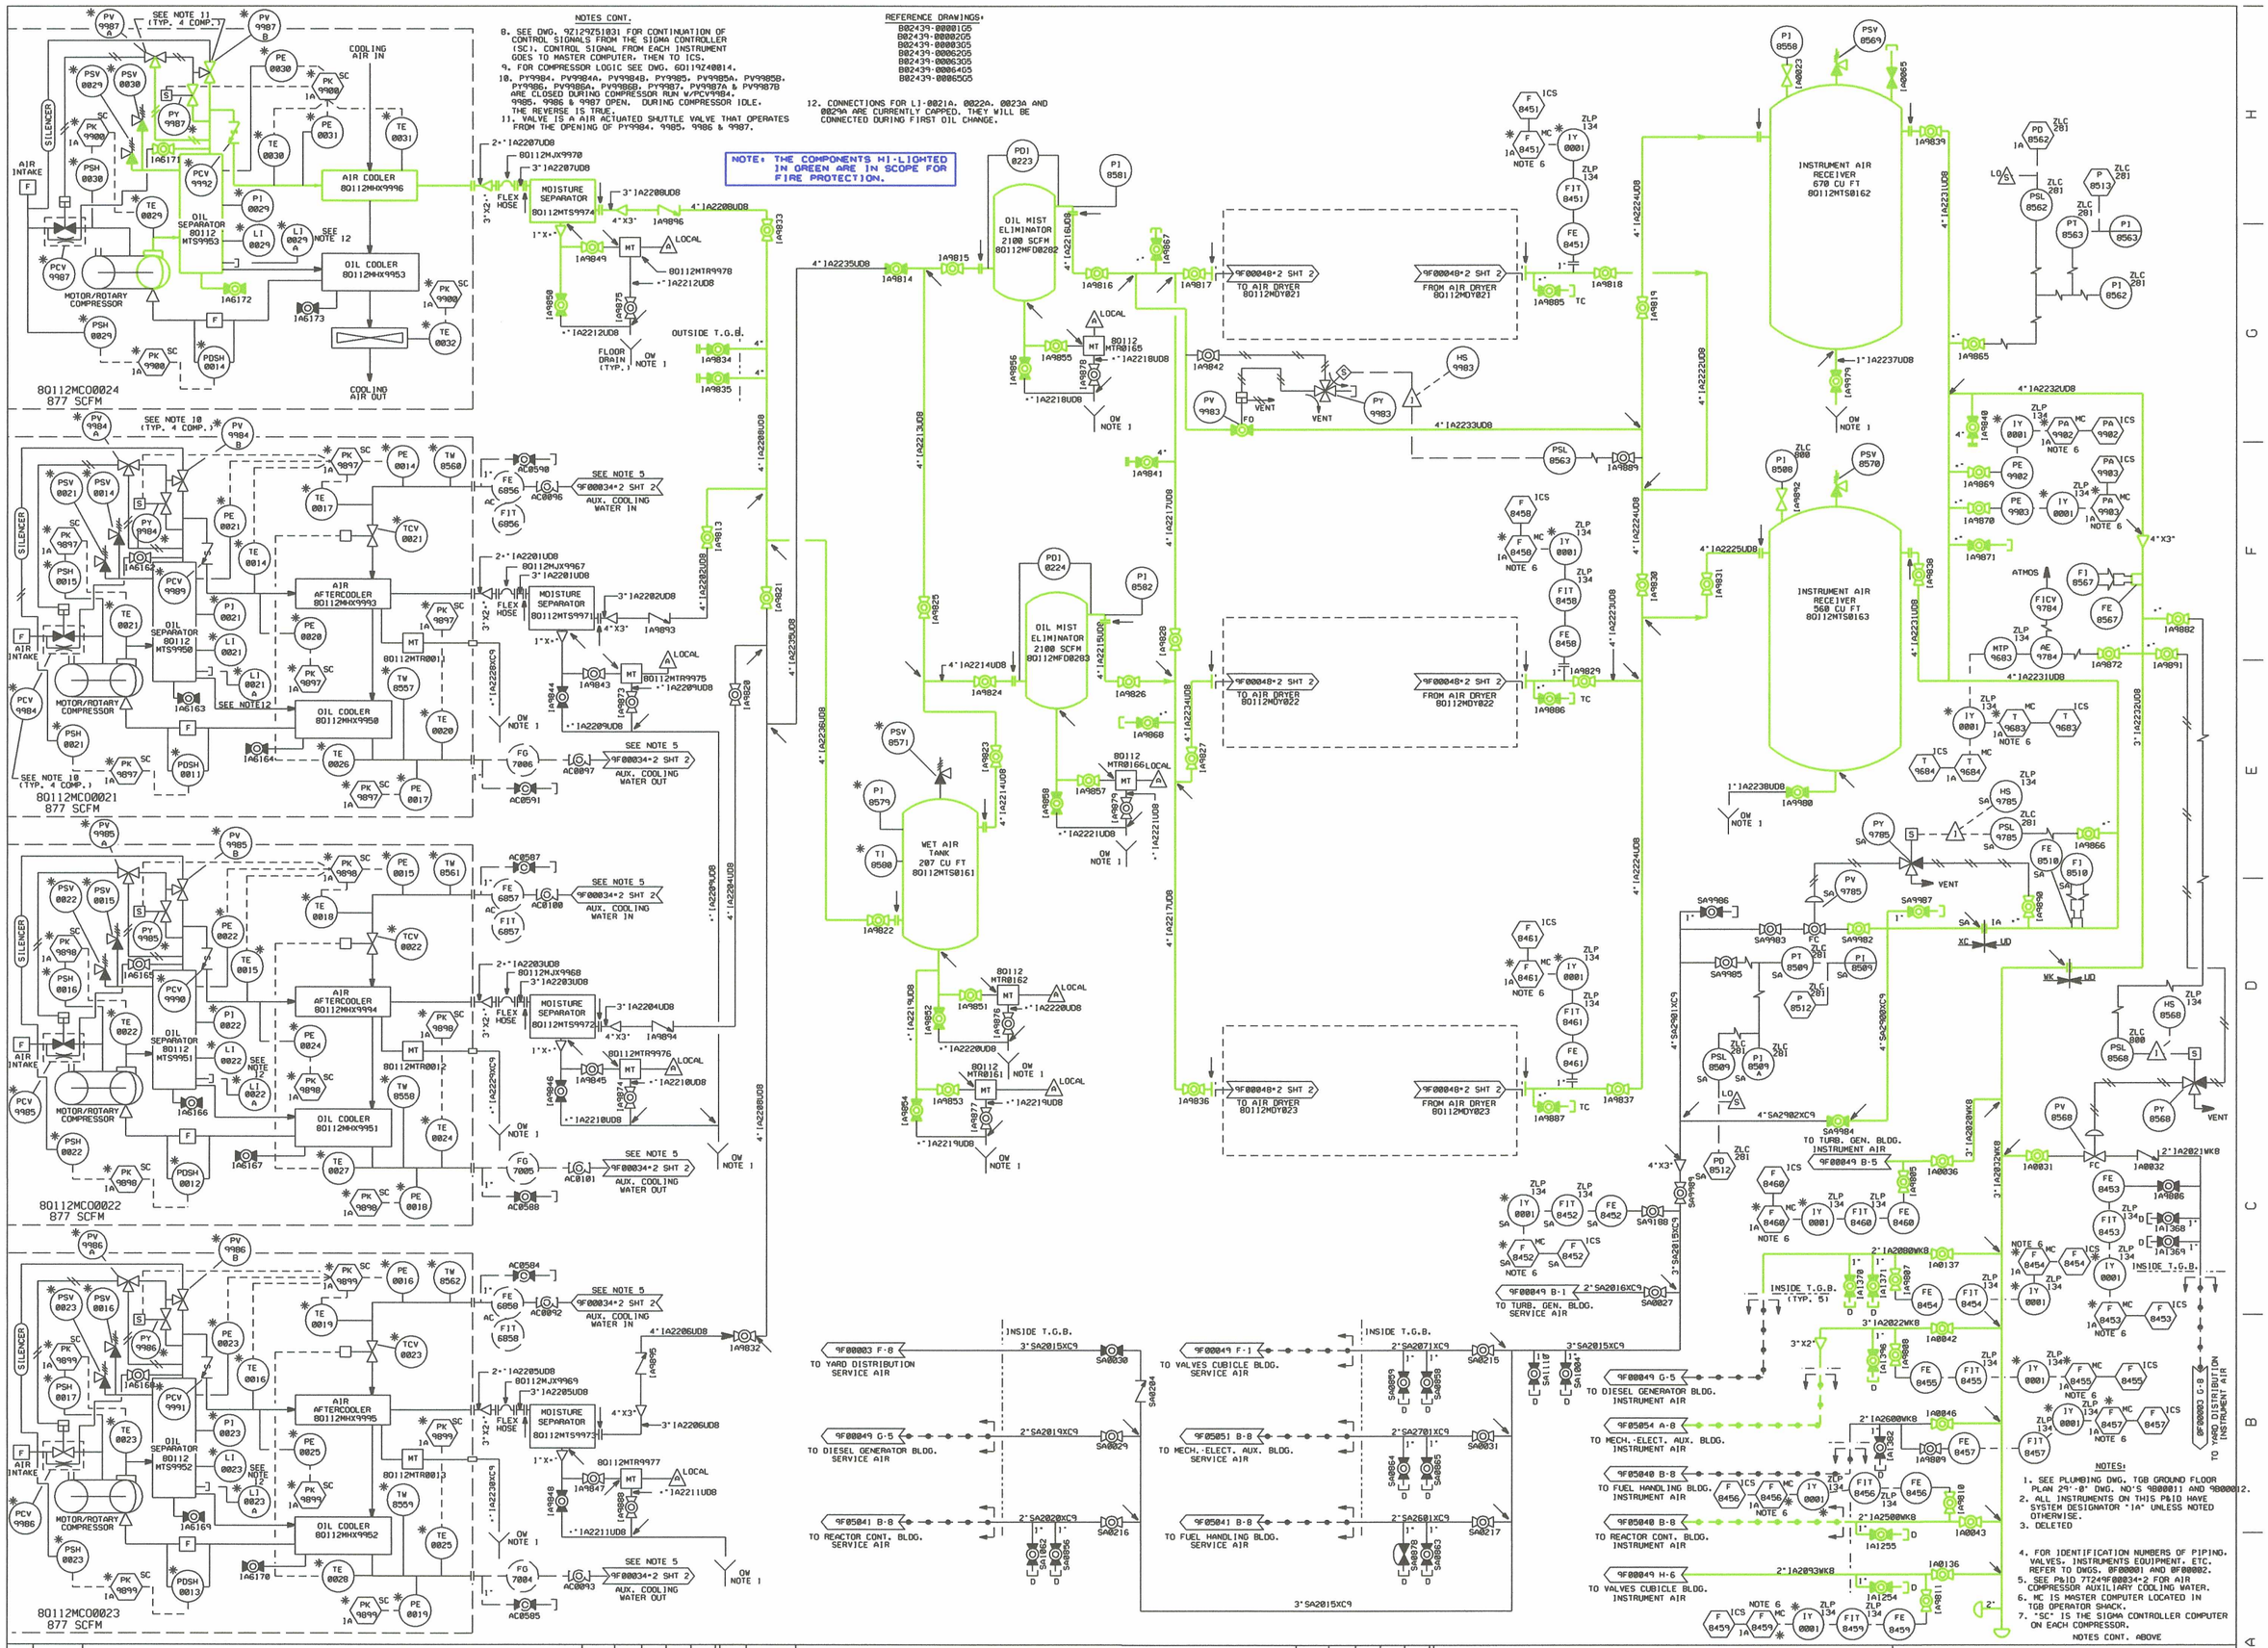

NO.	ISSUE DATE	REVISION	ORIG	CKR	RE	DV	SE
11		REVISED PER DCP 00-81-12 SUPP. 3	KS				
10		REVISED PER AS-BUILT CHANGES & ISSUED PER DCP 00-81-12 SUPP. 2	JSH	ON FILE			
9	7-17-03	REVISED AND ISSUED PER DCP 00-81-12	KS	ON FILE			
0-8	7-22-96	ISSUED FOR CONSTRUCTION.	SIGNATURES ON FILE				

ESEED_DGN

NO.	ISSUE DATE	REVISION	ORIG	CKR	RE	DV	SE

SOUTH TEXAS PROJECT
NUCLEAR OPERATING COMPANY

PIPING & INSTRUMENTATION DIAGRAM
INSTRUMENT AIR/SERVICE AIR
COMPRESSORS & DISTRIBUTION

PRIORITY	CADD FILE NO.	FSUG. NO.	STI. NO.	SCALE	DWG. NO.	SHT.	REV.
1	F0210.111	D070928		NONE	8Q119F00048*2	1	11

LR BOUNDARY DRAWING NO.	REV.
LR-STP-IA-8Q119F00048#2-1	0A

D-205