NOTES:
1. FOR GENERAL NOTES AND REFERENCE DRAWINGS SEE 5RW1925-NC-01.

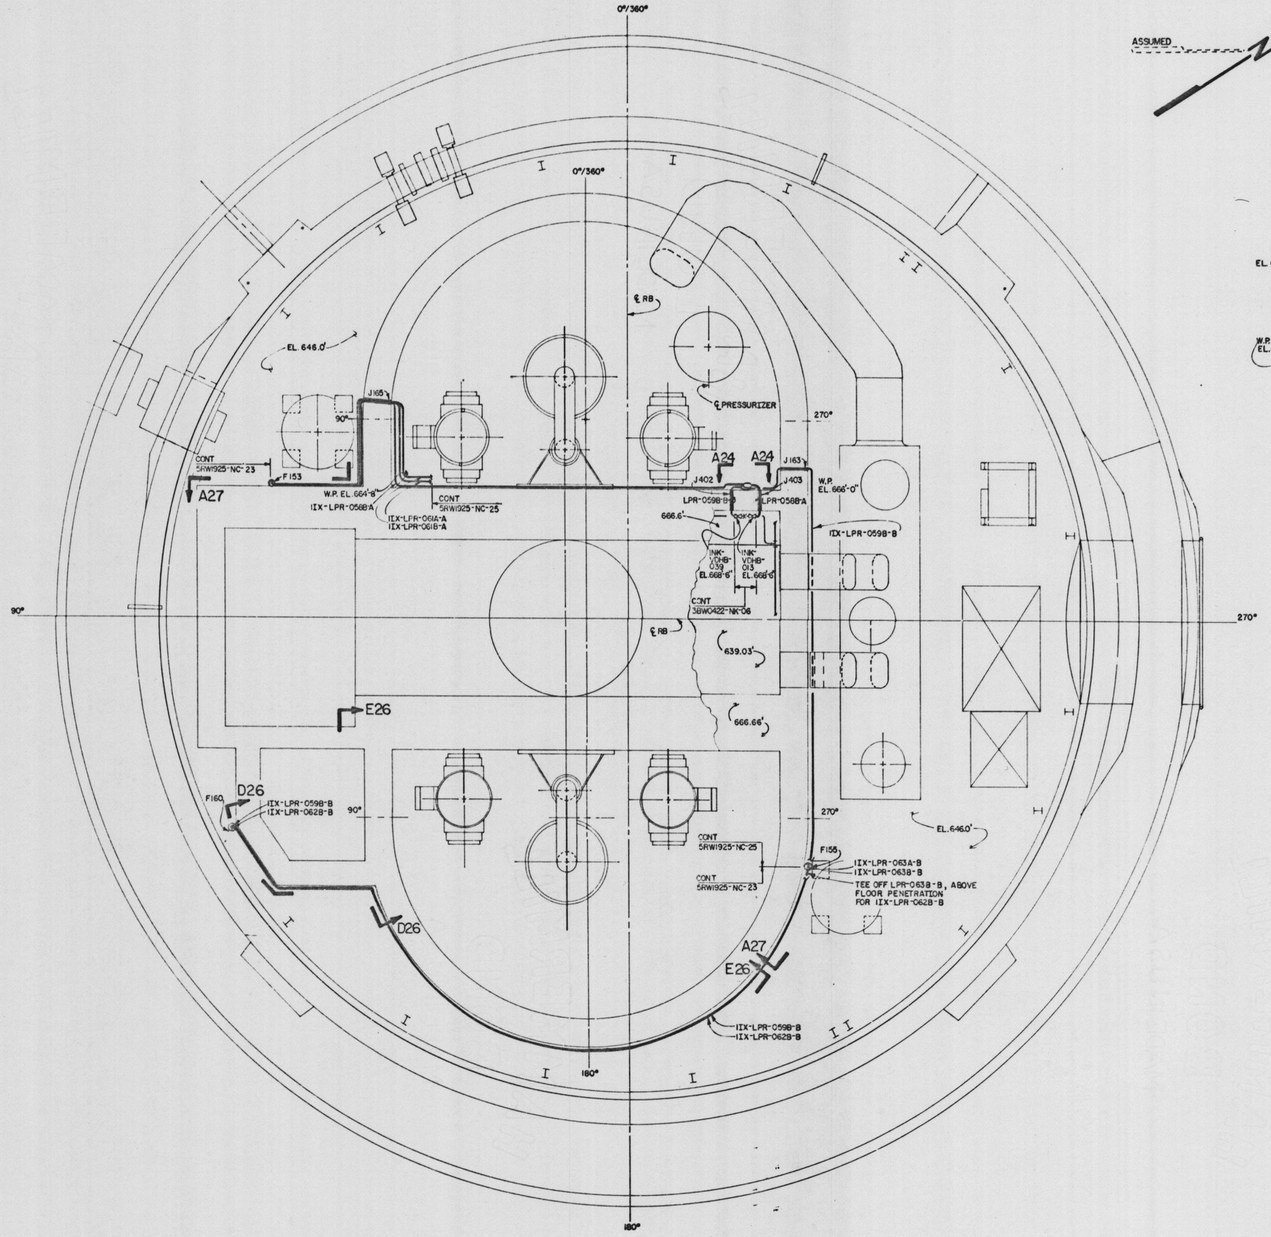

PLAN EL.646.0'

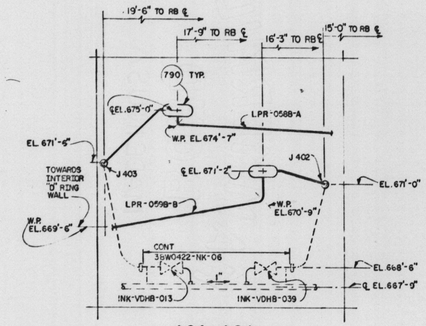

A24 - A24
CONDENSATE POT SCHEMATIC
NTS

PRC APERTURE CARD
Docket #50-438/439
Control #8301060310
Date 12/23/82 of Document
REGULATORY DOCKET FILE

8301060351

RO ISSUED PER ECN 891

REV NO	ECN NO.	DATE	DSGN	DRWN	CHKD	SUPV	ENGR	INSP	SUBM	RECM	APPD

DSGN T.E. Snyder
DRWN F.H. Bruce
CHKD T.F. Bruce
SUPV E.G. Brantley
INSP
ENGINEER Charles D. Winters

SCALE: 1/8"=1'-0" EXCEPT AS NOTED

REACTOR BLDG
UNIT 1

INSTRUMENTS & CONTROLS
LCL PNLS IIX-ILPR -058-A, -059-B, -060-A, -061-A, -062-B & -063-B
INSTALLATION EL.646.0'

BELLEFONTE NUCLEAR PLANT
TENNESSEE VALLEY AUTHORITY
DIVISION OF ENGINEERING DESIGN
Q

SUBMITTED	RECOMMENDED	APPROVED
D. Winters	J. L. Spencer	R. M. Hodges

FURTHER REVIEW
CEB R.O. Barnett
EEB N/A
MEB N/A
NEB John A. Ralston

INSPECTED AND APPROVED FOR ISSUE

KNOXVILLE	12-8-81	88	E	5RW1925-NC-24	RO

RECORD DRAWING AS CONSTRUCTED

PRINT H
SIZE F