88 E 5RW1925-NC-25

NOTES:

1. FOR GENERAL NOTES AND REFERENCE DRAWINGS SEE 5RW1925-NC-01.

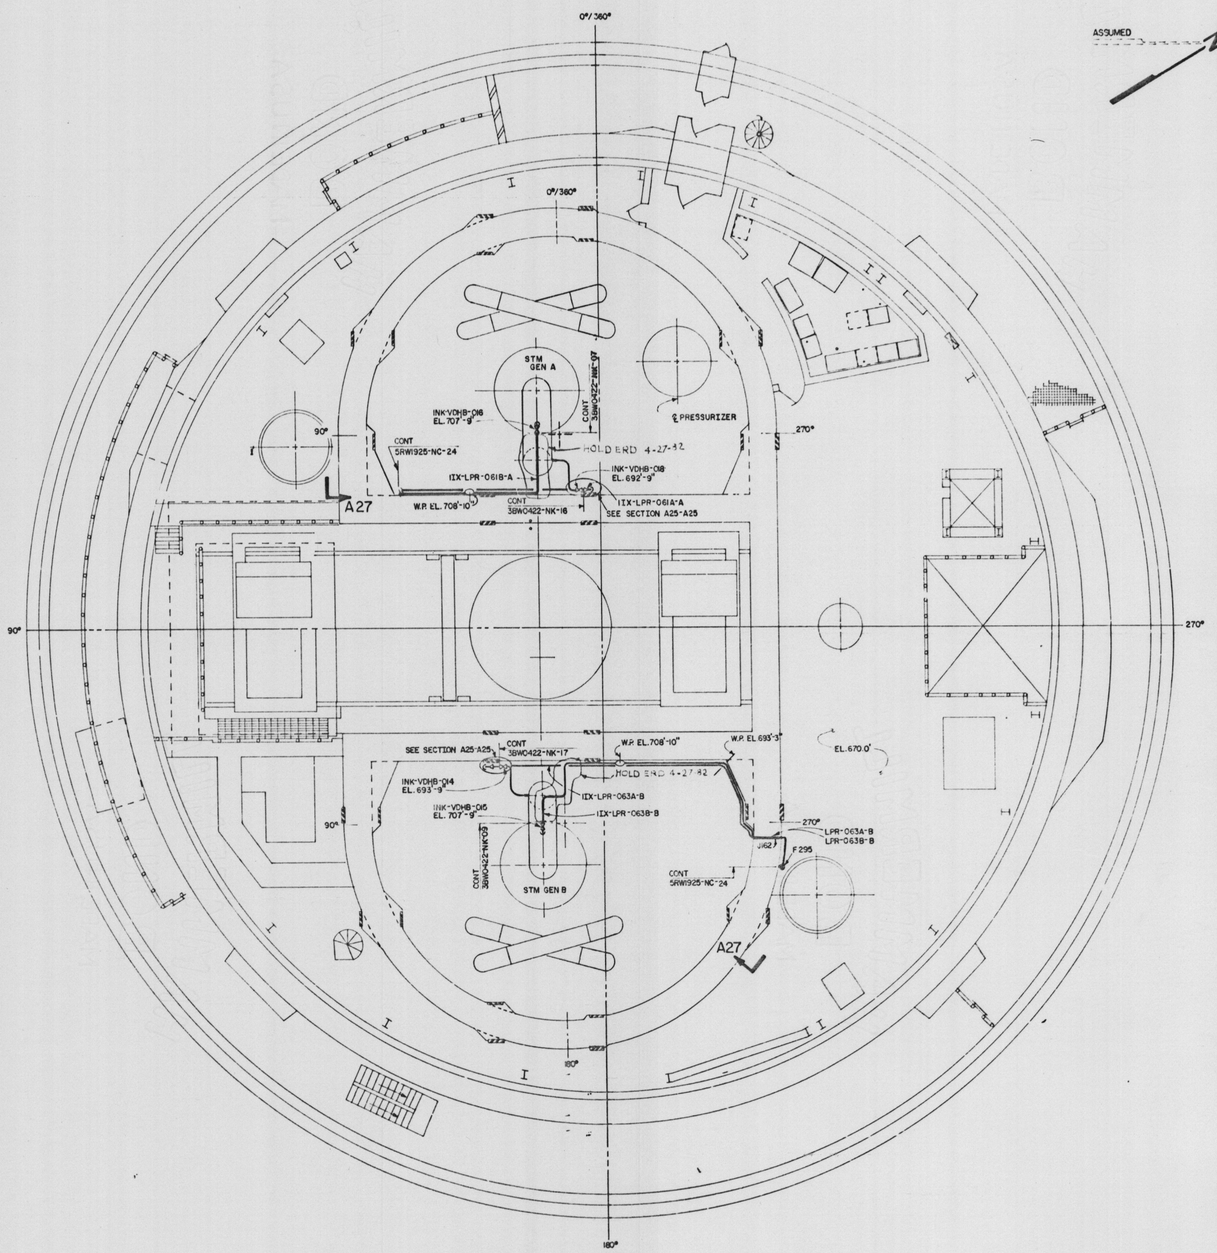

PLAN EL.670.0'

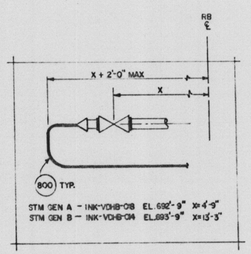

A25-A25
NTS

PRC APERTURE CARD

Docket #50-438/439
Control #8301060310
Date 12/23/82 of Document
REGULATORY DOCKET FILE

8301060357

RO ISSUED PER ECN 891

REV NO	ECN NO.	DATE	DSGN	DRWN	CHKD	SUPV	CHKR	INSP	SUBM	RECM	APPD

DSGN T.C. Snyder
DRWN E.A. Cook
CHKD T.C. Ray
SUPV R.B. Bennett
INSP
ENGINEER Charles A. Dutton

SCALE: 1/8" = 1'-0" EXCEPT AS NOTED

REACTOR BUILDING
UNIT 1

INSTRUMENTS & CONTROLS
LCL PNLS 1IX-1LPR-058-A, -059-B, -060-A, -061-A, -062-B, & -063-B
INSTALLATION EL. 670.0'

BELLEFONTE NUCLEAR PLANT
TENNESSEE VALLEY AUTHORITY
DIVISION OF ENGINEERING DESIGN

Q

SUBMITTED	RECOMMENDED	APPROVED
C.A. Dutton	R.L. Spencer	R.M. Godwin

KNOXVILLE 12-3-81 88 E 5RW1925-NC-25 RO

RECORD DRAWING AS CONSTRUCTED

FURTHER REVIEW
CEB R.O. Burnette
EEB N/A
MEB N/A
NEB John A. Ramlston /gdc

INSPECTED AND APPROVED FOR ISSUE

PRINT