88 | E | 5RW1925-NC-27

NOTES:
1. FOR GENERAL NOTES AND REFERENCE DRAWINGS SEE 5RW1925-NC-01.

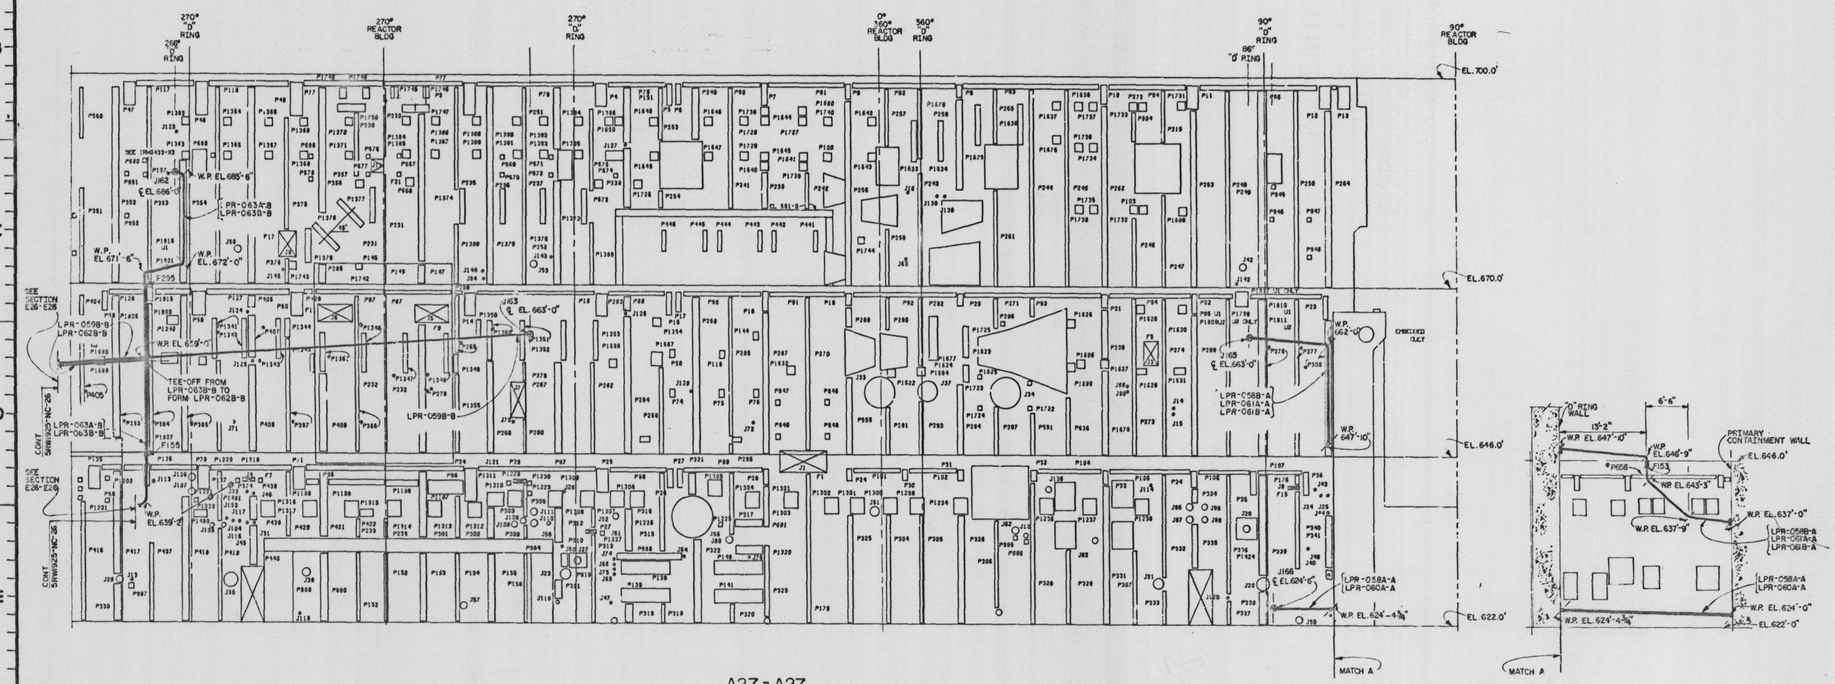

A27 - A27
SHEETS 23, 24 & 25

PRC APERTURE CARD

8301060366

RO ISSUED PER ECN 891

Docket #50-439/440
Control #8301060310
Date 12/23/82 of Document
REGULATORY DOCKET FILE

REV NO	ECN NO	DATE	DSGN	DRWN	CHKD	SUPV	ENGR	INSP	CLSR	TECH	APPR

DSGN - T.C. Snyder
DRWN - T.A. Cook
CHKD - T.E. Cook
SUPV - C.S. Crawford
INSP
ENGINEER - C.A. Lentsch

SCALE: 1/8"=1'-0" EXCEPT AS NOTED

REACTOR BUILDING
UNIT 1

INSTRUMENTS & CONTROLS
LCL PNLS 1IX-1LPR -058-A, -059-B, -060-A, -061-A, -062-B & -063-B
INSTALLATION EL. 622.0' TO 700.0'

BELLEFONTE NUCLEAR PLANT
TENNESSEE VALLEY AUTHORITY
DIVISION OF ENGINEERING DESIGN
Q

SUBMITTED	RECOMMENDED	APPROVED
C.A. Lentsch	R.L. Spencer	R.M. Gridley

KNOXVILLE | 12-3-81 | 88 | E | 5RW1925-NC-27 | RO
RECORD DRAWING AS CONSTRUCTED

FURTHER REVIEW
CEB - R.L. Spencer
EEB - N/A
MEB - N/A
NEB - John A. Rankin Jr.

INSPECTED AND APPROVED FOR ISSUE

PRINT