NOTES:

1. FOR GENERAL NOTES AND REFERENCE DRAWINGS SEE 5RWI925-NC-01.

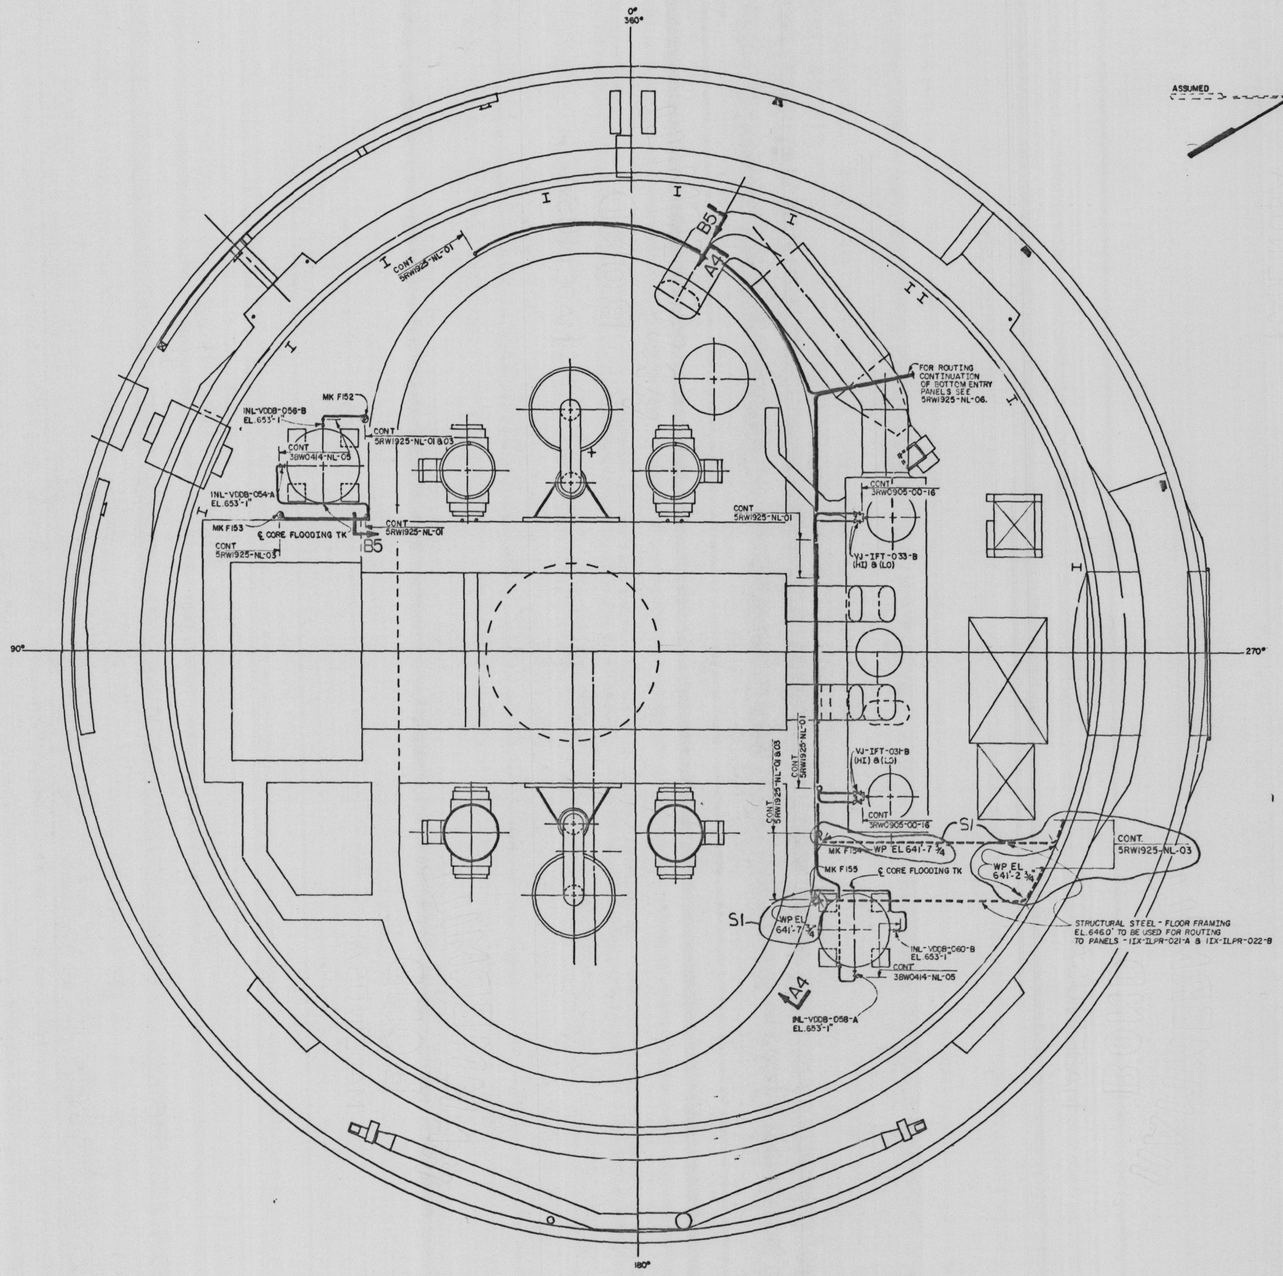

PLAN EL. 646.0'

Docket #50-438/439
Control #8301060310
Date 12/23/82 of Document
REGULATORY DOCKET FILE

8301060371

PRC APERTURE CARD

REV NO	ECN NO.	DATE	DSGN	DRWN	CHKD	SUPV	ENGR	INSP	SUBM	RECM	APPD
1	S1	7-28-82	CS	JB	WCT	CSB	-	CS	JLS	DWB	RCS	JWP	N/A	N/A

MINOR REVISIONS

DSGN T.A. Dietz
DRWN T.A. Dietz
CHKD Jones & Hughes
SUPV C.S. Bennett Jr.

INSP
ENGINEER C.M. Masterson

SCALE: 1/8" = 1'-0" EXCEPT AS NOTED

REACTOR BLDG
UNIT 1

INSTRUMENTS & CONTROLS
LOCAL PNLS 1IX-ILPR-002-A,-005-B,-019-A, -020-B,-021-A & -022-B
INSTALLATION EL. 646.0'

BELLEFONTE NUCLEAR PLANT
TENNESSEE VALLEY AUTHORITY
DIVISION OF ENGINEERING DESIGN

Q

SUBMITTED	RECOMMENDED	APPROVED
C.M. Masterson	T.L. Spencer	E.M. Jackson

KNOXVILLE | 10-10-80 | 88 | E | 5RWI925-NL-02 R1

RECORD DRAWING AS CONSTRUCTED

FURTHER REVIEW
CEB C.E. Bennett
EEB N/A
MEB N/A
NEB Design Td Dilworth Jr. Lee
INSPECTED AND APPROVED FOR ISSUE