NOTES:

1. FOR GENERAL NOTES AND REFERENCE DRAWINGS SEE 5RW1925-NC-01.

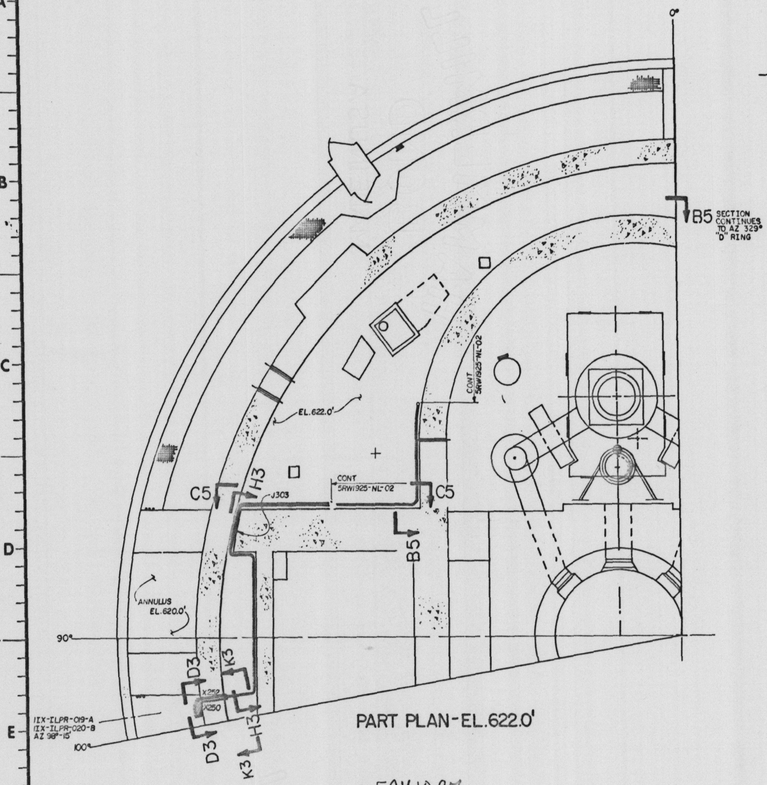

PART PLAN-EL.622.0'

PART PLAN-EL.622.0'

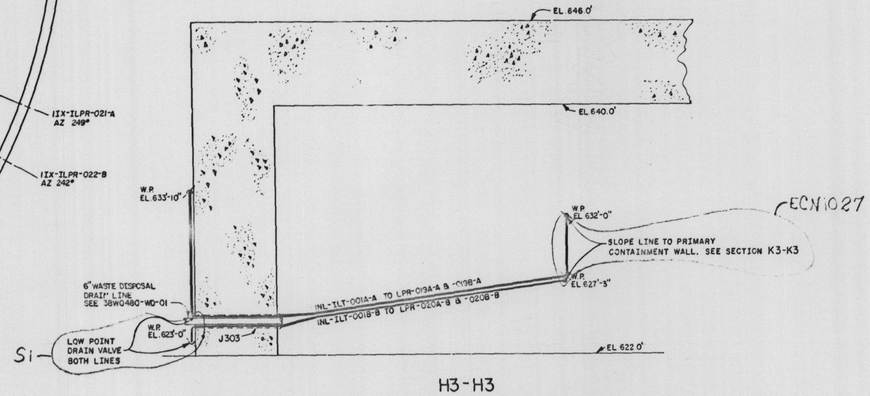

H3-H3

SCALE: 1/4" = 1'-0"

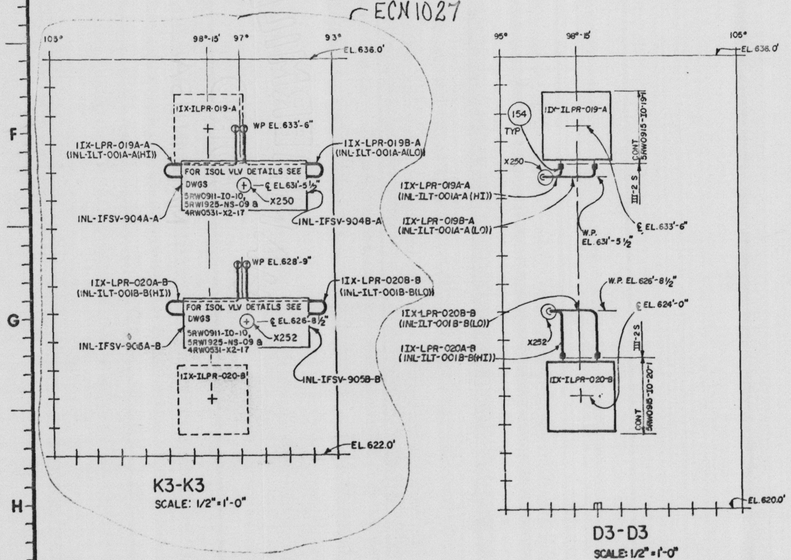

ECN1027

PRC APERTURE CARD

Docket #50-438/439
Control #8301060310
Date 12/23/83 of Document
REGULATORY DOCKET FILE

8301060376

REV NO	ECN NO.	DATE	DSGN	DRWN	CHKD	SUPV	ENGR	INSP	SUBM	RECM	APPD
1	1027, S1	7-27-82	CE	JB	TM	SB	MB	-	JLS	JMS	CE	DJ	N/A	N/A

INCORPORATED ECN1027 & MINOR REVISIONS

DSGN - SA Watts
DRWN - TJB Dobbs
CHKD - Tyrone E. Smith
SUPV - J.D. Cornett

INSP
ENGINEER - Charles Doctorey

SCALE: 1/8" = 1'-0" EXCEPT AS NOTED

REACTOR BUILDING
UNIT 1

INSTRUMENTS & CONTROLS LCL PNLS IIX-ILPR-019-A,020-B,021-A & 022-B INSTALLATION EL.622.0'

BELLEFONTE NUCLEAR PLANT
TENNESSEE VALLEY AUTHORITY
DIVISION OF ENGINEERING DESIGN

Q

SUBMITTED	RECOMMENDED	APPROVED
C.E. Doctorey	A.L. Sommer	R.M. Rodger

FURTHER REVIEW
CEB K.D. Barrett
EEB N/A
MEB N/A
NEB George F. Dilworth for

INSPECTED AND APPROVED FOR ISSUE

KNOXVILLE	10-10-80	88	E	5RW1925-NL-03	R1

RECORD DRAWING AS CONSTRUCTED