88 E 5RW1925-NL-04

NOTES:

1. FOR GENERAL NOTES AND REFERENCE DRAWINGS SEE 5RW1925-NC-01.

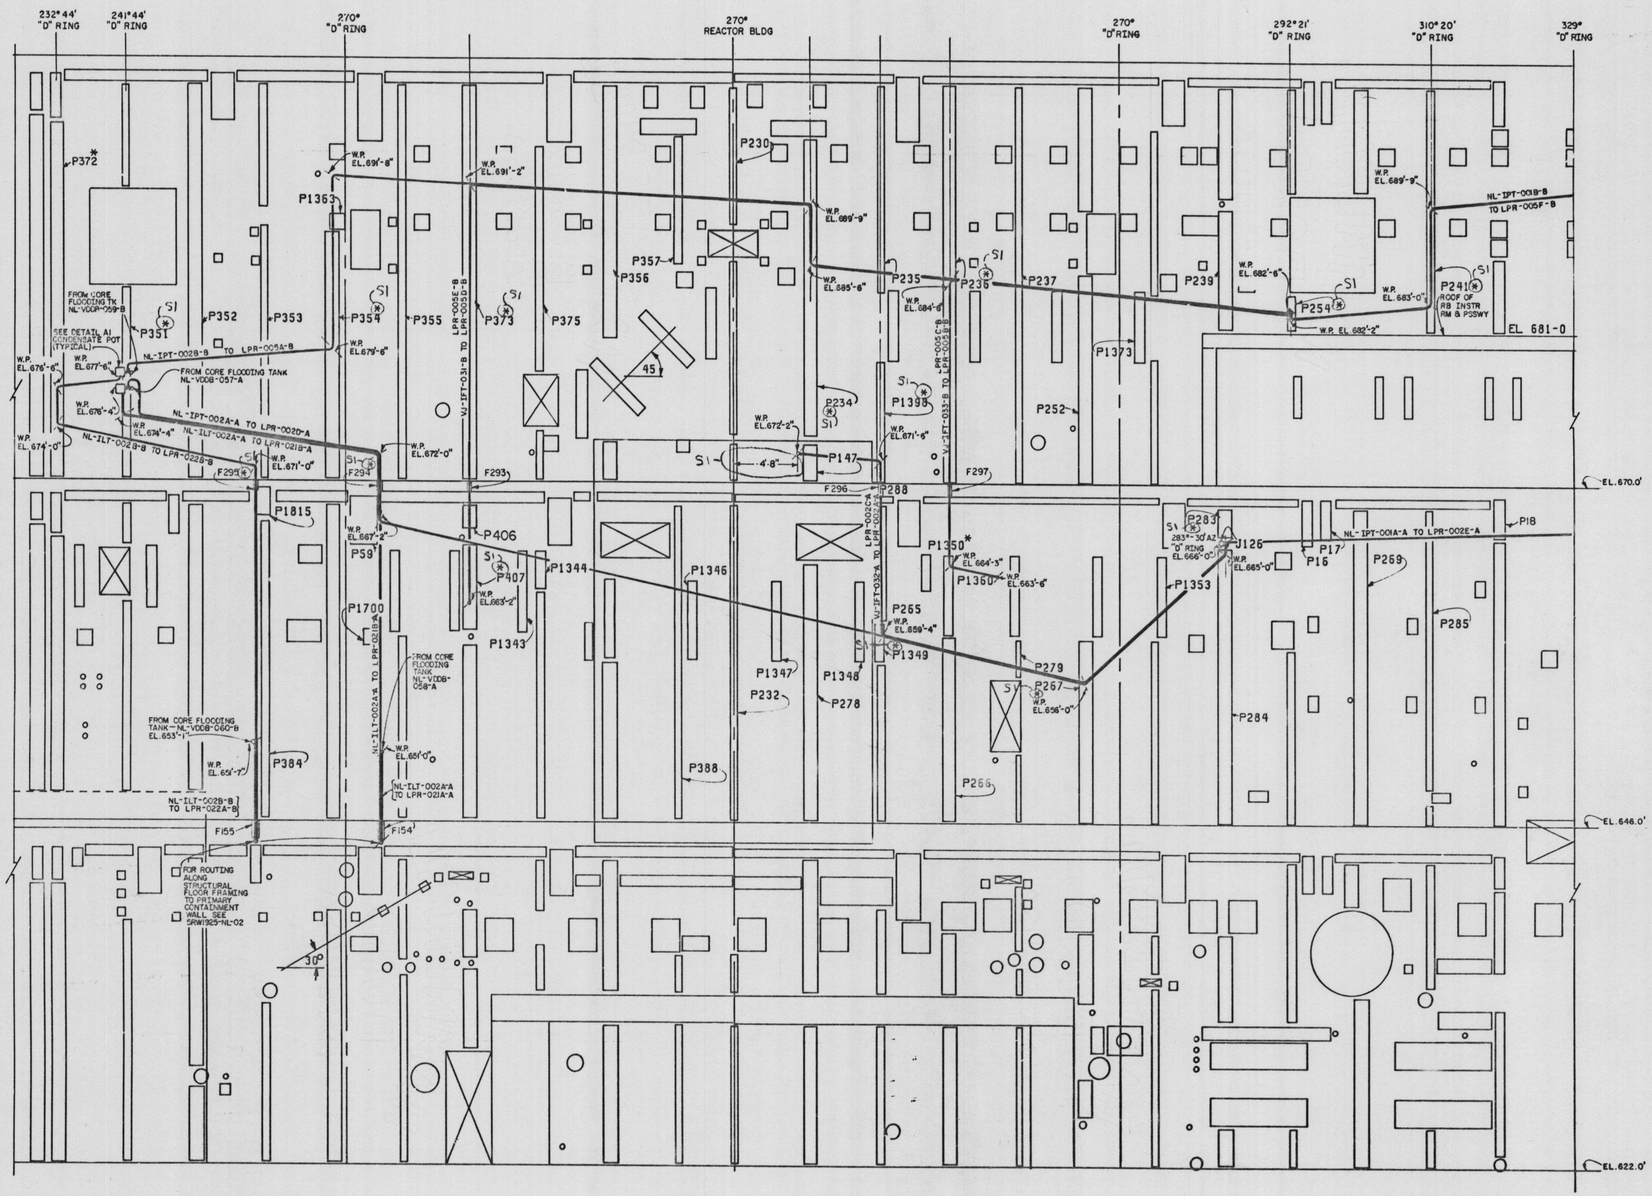

A4-A4

DEVELOPED EXTERIOR ELEVATION
SECONDARY SHIELD WALL

PRC APERTURE CARD

Docket #50-438/439
Control #8301060310
Date 12/23/82 of Document
REGULATORY DOCKET FILE

8301060381

REV NO	ECN NO.	DATE	DSGN	DRWN	CHKD	SUPV	ENGR	INSP	SUBM	RECM	APPD
1	S1	7 27 72									

ADDED WORK POINT DIMENSIONS

DSGN S.A. White
DRWN T.A. Dewey
CHKD Thomas E. Snyder
SUPV E.B. Bennett Jr.
INSP
ENGINEER Charles D. Antuney

SCALE: 1/4" = 1'-0" EXCEPT AS NOTED

REACTOR BLDG
UNIT 1

INSTRUMENTS & CONTROLS
LCL PNLS IIX-ILPR-002-A, -005-B, -019-A, -C20-B, -021-A, & 022-B
INSTALLATION EL. 622.0' TO 700.0'

BELLEFONTE NUCLEAR PLANT
TENNESSEE VALLEY AUTHORITY
DIVISION OF ENGINEERING DESIGN

Q

SUBMITTED C.D. Antuney
RECOMMENDED J.L. Spencer
APPROVED R.M. Hodges

KNOXVILLE 10-10-80 88 E 5RW1925-NL-04 R1

RECORD DRAWING AS CONSTRUCTED

FURTHER REVIEW
CEB R.D. Barnett
EEB N/A
MEB N/A
NEB George F. Dilworth /82
INSPECTED AND APPROVED FOR ISSUE