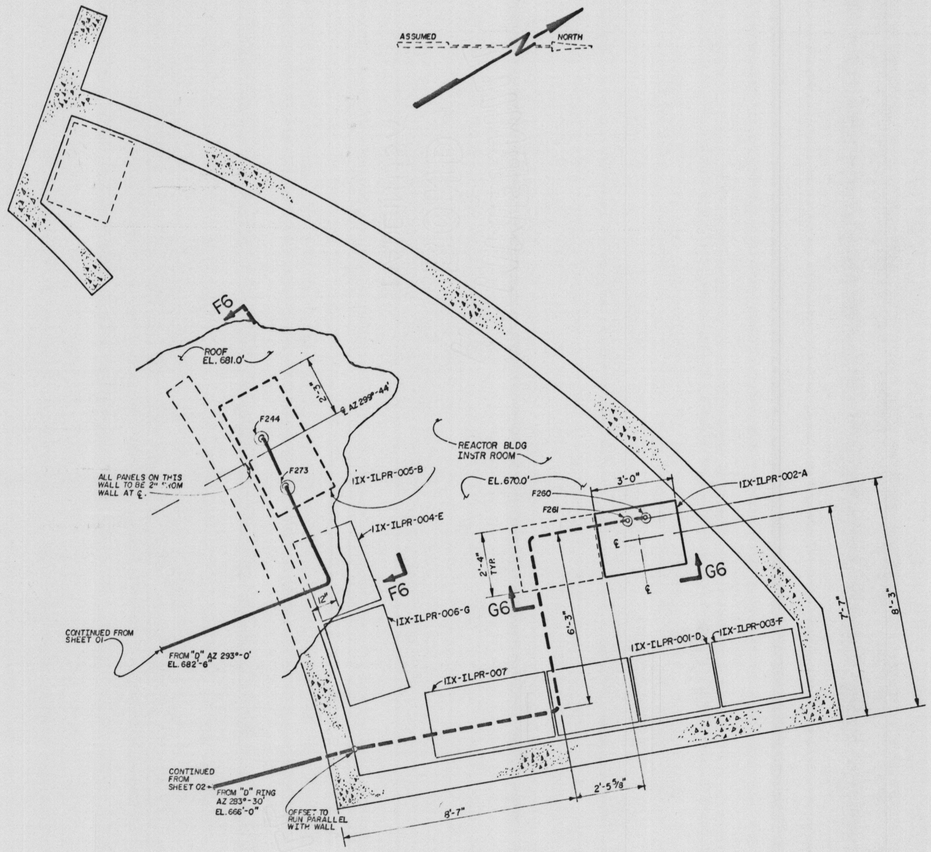

PART PLAN - EL. 670.0'
REACTOR BUILDING INSTRUMENT ROOM

PANEL UNID	DRAIN LOCATION (AZIMUTH)
IIX-ILPR-002-A	318°-20'
IIX-ILPR-005-B	323°-13'
IIX-ILPR-019-A	99°
IIX-ILPR-020-B	99°
IIX-ILPR-021-A	248°
IIX-ILPR-022-B	240°

* FOR DRAIN CONNECTION DETAILS, SEE SAWDSII-10-21.

TABLE H6

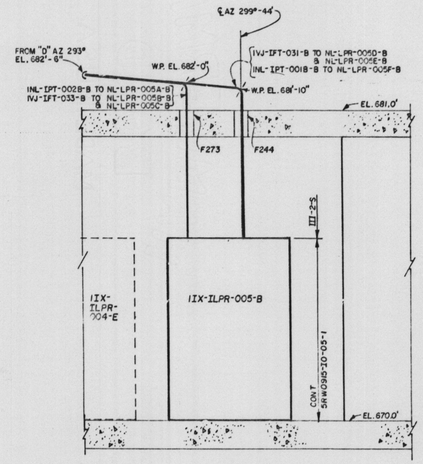

F6-F6

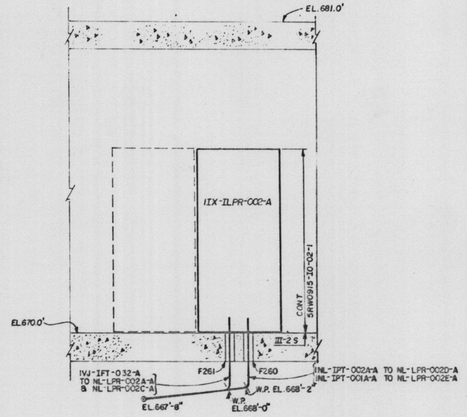

G6-G6

NOTES:
1. FOR GENERAL NOTES AND REFERENCE DRAWINGS SEE 5RW1925-NC-01.

PRC APERTURE CARD
Docket # 50-438/439
Control # 8301060310
Date 12/23/83 of Document
REGULATORY DOCKET FILE
8301060386

REV NO	ECN NO.	DATE	DSGN	DRWN	CHKD	SUPV	ENGR	MGR	QUAL	REGR	APPR
DSGN	T.A. Webb										
DRWN	T.A. Webb										
CHKD	Thomas A. Webb										
SUPV	C.O. Bennett, Jr.										

MGR Chuck D'Antonio
ENGINEER Chuck D'Antonio

SCALE: 1/2" = 1'-0" EXCEPT AS NOTED

REACTOR BLDG
UNIT 1

INSTRUMENTS & CONTROLS LOCAL PNLS IIX-ILPR-002-A & 005-B INSTALLATION EL. 670.0'

FURTHER REVIEW
LEB L.E. Barrett
EEB N/A
MEB N/A
NEB George F. Dilworth
INSPECTED AND APPROVED FOR ISSUE

BELLEFONTE NUCLEAR PLANT
TENNESSEE VALLEY AUTHORITY
DIVISION OF ENGINEERING DESIGN
Q

SUBMITTED	RECOMMENDED	APPROVED
C.D'Antonio	L.E.Barrett	R.M.Hodges

KNOXVILLE | 10-10-80 | 88 | E | 5RW1925-NL-06 | R0

RECORD DRAWING AS CONSTRUCTED

PRINT H
SIZE F