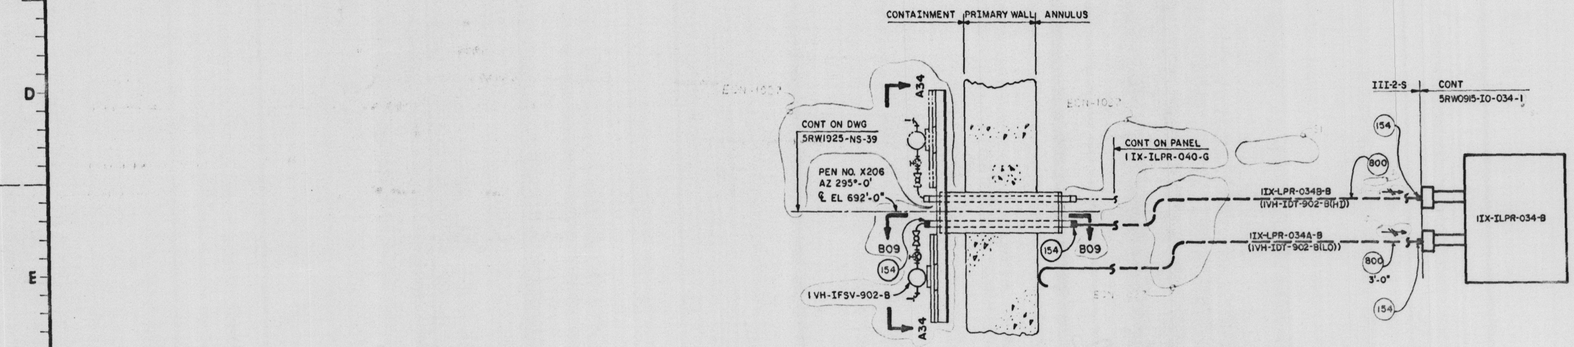

SCHEMATIC 034-B
TUBE ROUTING FOR PRIMARY CONTAINMENT & ANNULUS PRESSURE
FOR SECTION B09-B09, SEE 5RW1925-NS-09

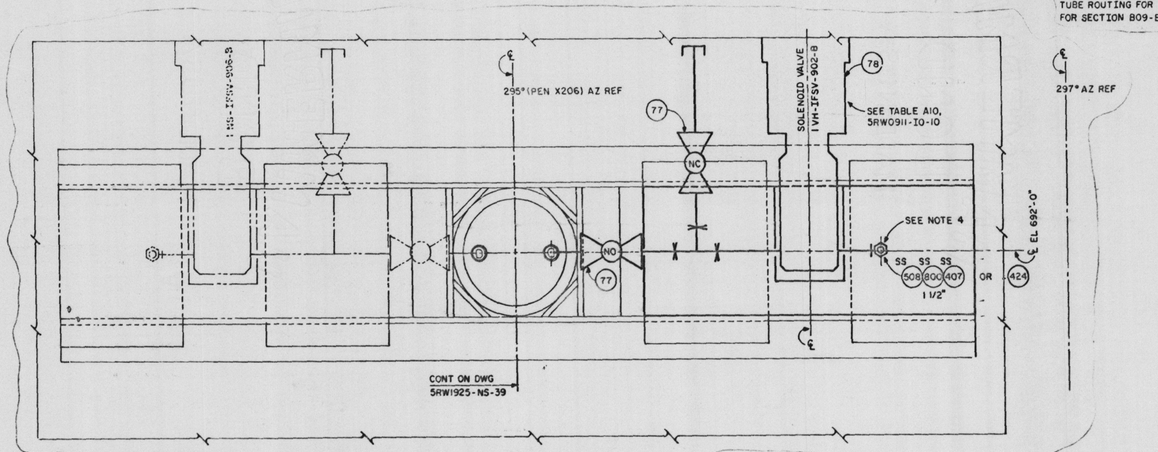

A34 - A34
FRONT ELEVATION, CONTAINMENT SIDE;
FOR DIMENSIONS, SEE SECTION A09-A09
ON DRAWING 5RW1925-NS-09

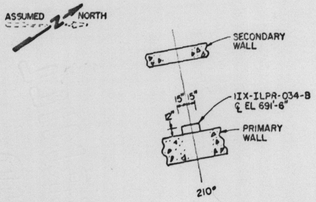

KEY PLAN
REACTOR BLDG
UNIT 1 EL 686'-0"
SCALE: 1/8"=1'-0"

NOTES:
1. FOR GENERAL NOTES AND REFERENCE DRAWINGS SEE 5RW1925-NC-1
2. INSTRUMENT PANEL TO BE MOUNTED 4'-0" OFF FLOOR TO BOTTOM OF PANEL
3. SEE NOTE 2, DRAWING 5RW1925-NS-09.
4. FOR SOLENOID VALVE STATION CONFIGURATION AND ADDITIONAL FITTINGS, SEE 5RW0911-IO-10.

REFERENCE DRAWING:
3RW0641-00-1,-2 ---------- DESIGN CRITERIA
2RW0900-VH-SERIES ---------- FOLD
5RW0915-IO-34 ---------- LOCAL PNL DWG
3RW0905-00-05 ---------- MECH-VENTILATION, PURGE & COOLING SYSTEM
5RW0911-IO-01 ---------- I&C PLANS
5RW1925-NS-09 ---------- SEE, FOR OTHER REFERENCE DRAWINGS.
5RW1925-NS-39 ---------- I&C LOCAL PANEL INSTALLATION DRAWING
5RW0911-IO-10 ---------- I&C ISOL SOL VALVE MTG PLATE DETAILS.

PRC APERTURE CARD
8301060399

Docket # 50-438/439
Control # 8301060310
Date 12/23/83 of Document
REGULATORY DOCKET FILE

FURTHER REVIEW	
CEB	N/A
EEB	N/A
MEB	N/A
NEB	N/A

INSPECTED AND APPROVED FOR ISSUE

REV NO.	ECN NO.	DATE	DSGN	DRWN	CHKD	SUPV	ENGR	MGR	BLDG	PROJ	APPR
1	S1,1027	5-25-83	1/8	3/16	1/16	1/8	3/8	1/8	ULS	1"	N/A	N/A	N/A	N/A

ECN-1027 INCORPORATED, SI MINOR CHANGES.

DSGN T.V. MOLL
DRWN L. BEASLEY
CHKD
SUPV E.B. Brewer

ENGINEER Charles N. Dunlap

SCALE NONE — EXCEPT AS NOTED

REACTOR BUILDING
UNIT 1

INSTRUMENTS & CONTROLS
LOCAL PNL IIX-ILPR-034-B
INSTALLATION EL. 686.0'

BELLEFONTE NUCLEAR PLANT
TENNESSEE VALLEY AUTHORITY
DIVISION OF ENGINEERING DESIGN

Q

SUBMITTED	RECOMMENDED	APPROVED
E.B. Brewer	L.L. Spencer	R.M. Parker

KNOXVILLE | 6-19-79 | 88 | E | 5RW1925-VH-34 R1

RECORD DRAWING AS CONSTRUCTED