PRC APERTURE CARD

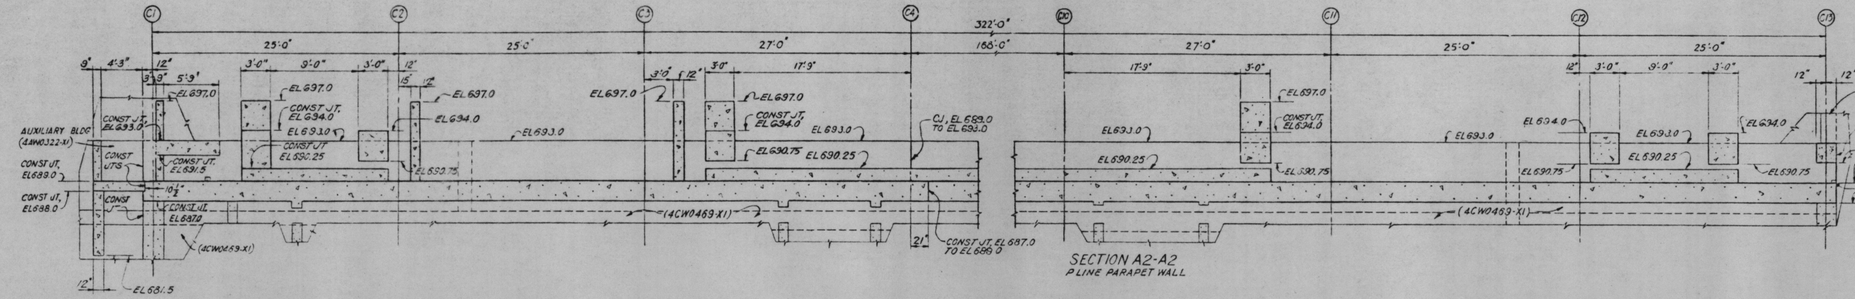

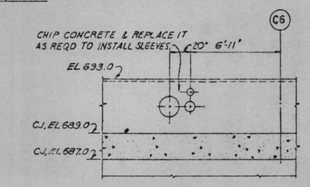

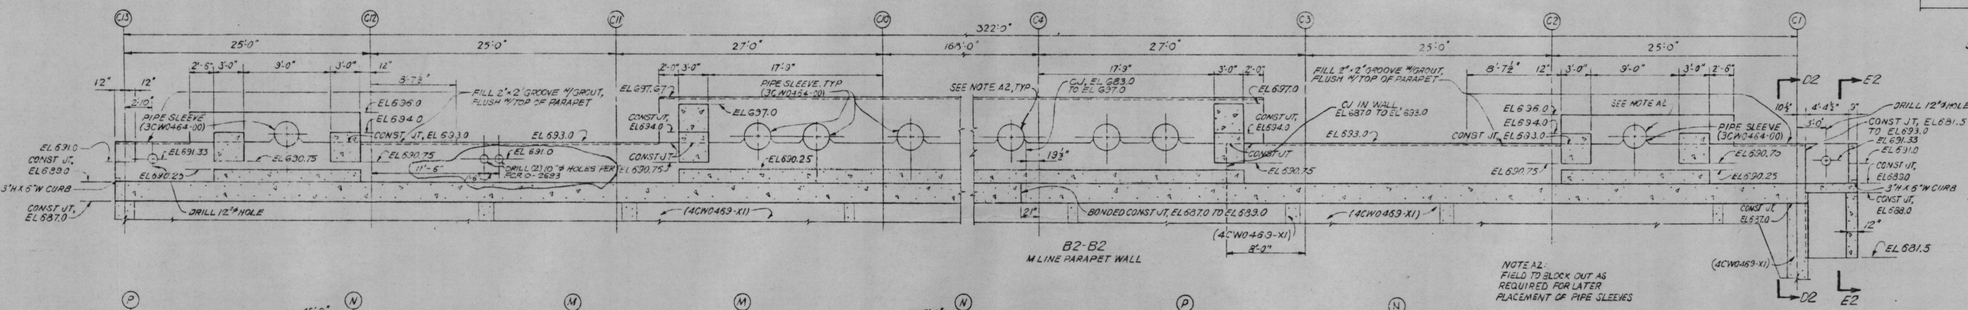

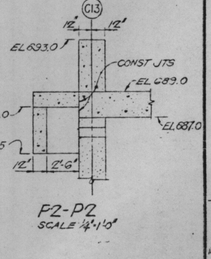

NOTE A2:
FIELD TO BLOCK OUT AS REQUIRED FOR LATER PLACEMENT OF PIPE SLEEVES

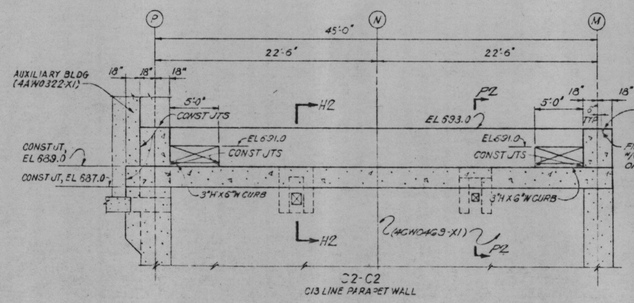

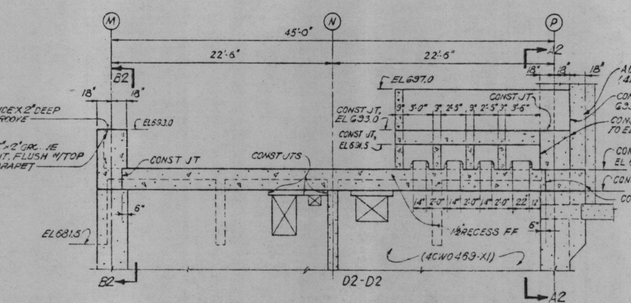

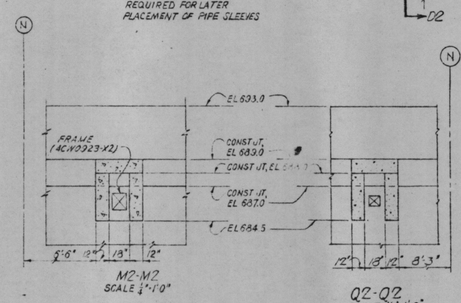

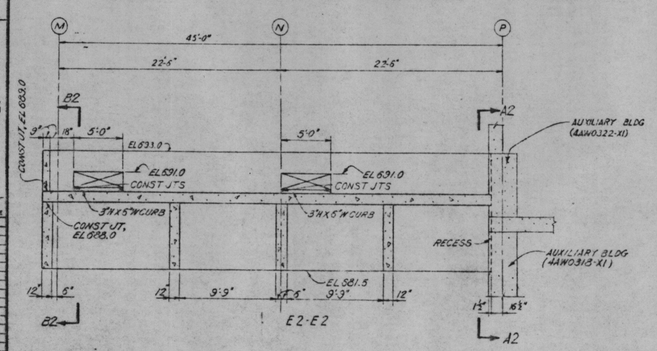

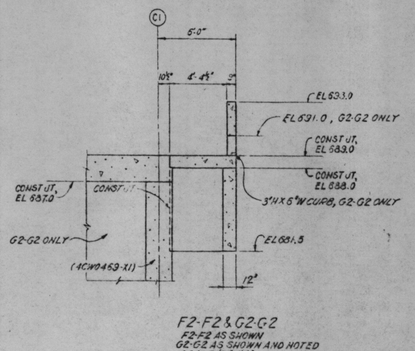

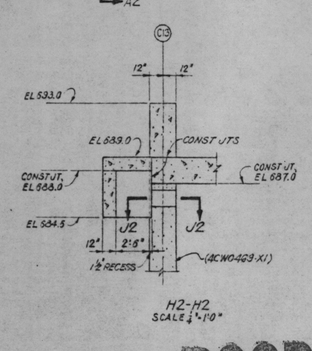

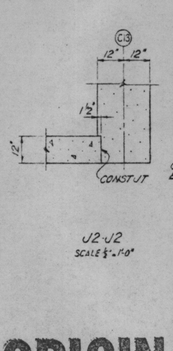

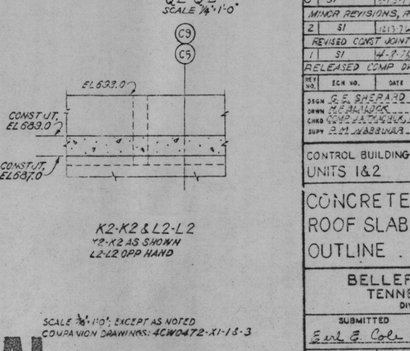

SCALE ⅛"=1'-0", EXCEPT AS NOTED
COMPANION DRAWINGS: 4CW0472-X1-1 & -3

NOTES:
FOR LIST OF NOTES SEE 4CW0472-X1-1.

Docket # 50-438/439
Control # 8209080020
Date 8/23/82 of Document
REGULATORY DOCKET FILE

REV	ECN NO.	DATE	DSGN	DRWN	CHKD	SUPV	ENGR	TASK	SUBM	ECN APPR
a	S1	10-19-81	PB	EGH	DLA	JWA	EJC			
5	ADDED SECTIONS A2-P2 & Q2-Q2, REV C2-L2	11-5-81	PB	EGH	DLA	JWA	EJC			
4	S1	11-5-81	PB	EGH	DLA	JWA	EJC			
REVISED SECTIONS B2-B2, C2-C2 & D2-D2, ADDED SECTIONS N2-N2										
3	S1	2-1-81	PB	EGH	DLA	JWA	EJC			
MINOR REVISIONS, REVISED WALL ELEVATIONS & ADDED NAILS										
2	S1	12-11-79	KEH	[illegible]						
REVISED CONST JOINTS, PERS 2-151, 0-135, 0-220 & 0-223										
1	S1	10-8-79	LAT	HAPLES	WEEKLEY					
RELEASED COMP DWG, MINOR REVISIONS, ADDED CONST JT										

DSGN G. E. SHEPARD
DRWN R. C. BALLARD
CHKD [illegible]
SUPV J. W. ABBANAT

INTG
ENGINEER Earl E. Cole

CONTROL BUILDING
UNITS 1&2

CONCRETE
ROOF SLAB EL 689.0
OUTLINE

BELLEFONTE NUCLEAR PLANT
TENNESSEE VALLEY AUTHORITY
DIVISION OF ENGINEERING DESIGN

SUBMITTED	RECOMMENDED	APPROVED
Earl E. Cole	C. Patterson	R. M. Hadlow

KNOXVILLE | 12-10-73 | 88 | C | 4CW0472-X1-2 R6

RECORD DRAWING AS CONSTRUCTED

PRINTS REQD—
BR [illegible]
PROJ

DWG SIZE	P
ME	
EE	
CE	
AD	
CO	
ED	
MD	
BY	
SW	
BL	
PA	

POOR ORIGINAL

8209080020