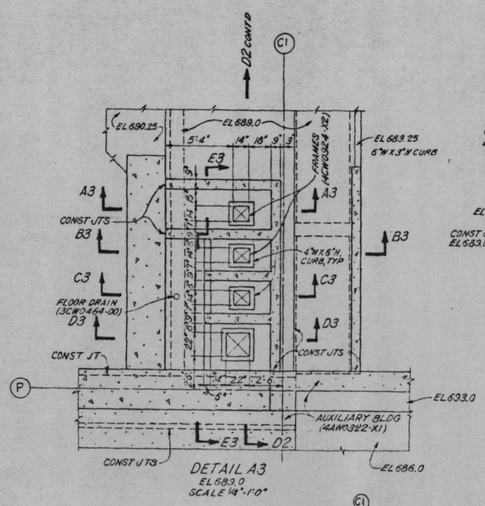

DETAIL A3
EL 689.0
SCALE 1/4"=1'-0"

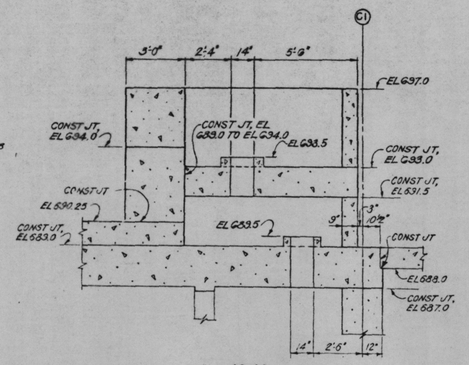

A3-A3
SCALE 3/8"=1'-0"

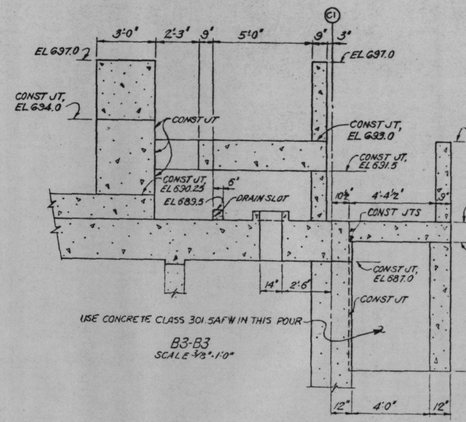

B3-B3
SCALE 3/8"=1'-0"

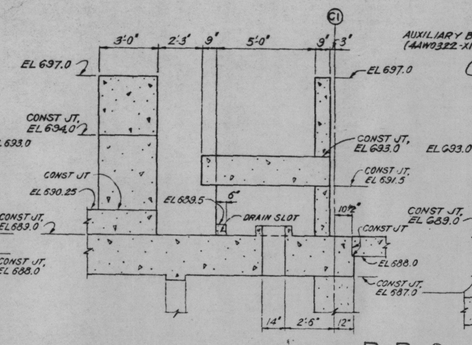

C3-C3
SCALE 3/8"=1'-0"

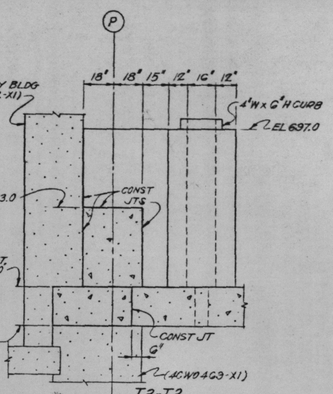

T3-T3
SCALE 3/8"=1'-0"

NOTES:
FOR LIST OF NOTES SEE 4CW0472-X1-1.

PRC APERTURE CARD

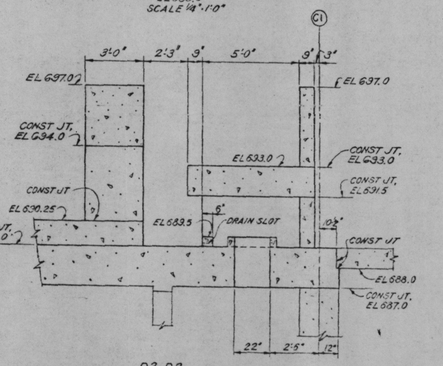

D3-D3
SCALE 3/8"=1'-0"

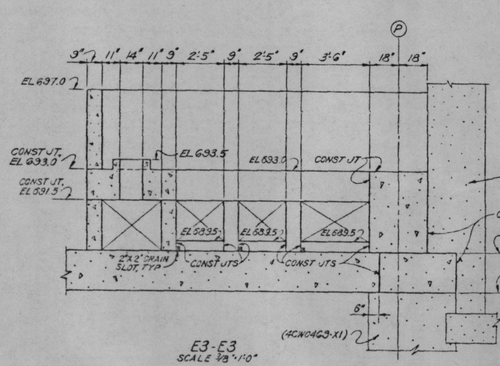

E3-E3
SCALE 3/8"=1'-0"

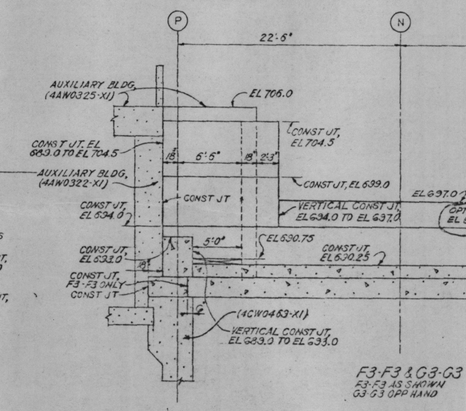

F3-F3 & G3-G3
F3-F3 AS SHOWN
G3-G3 OPP HAND

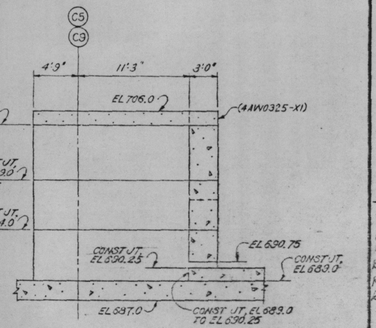

H3-H3 & J3-J3
H3-H3 AS SHOWN
J3-J3 OPP HAND

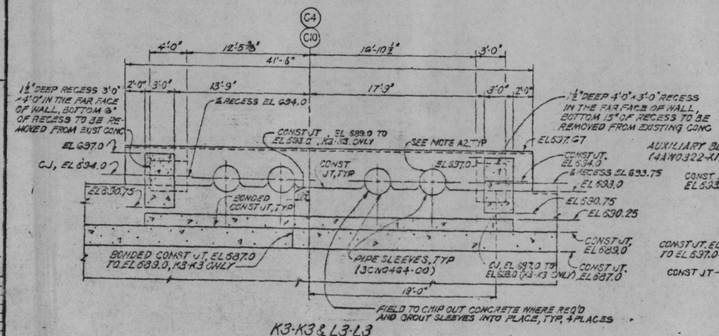

K3-K3 & L3-L3
K3-K3 AS SHOWN & NOTED
L3-L3 OPP HAND

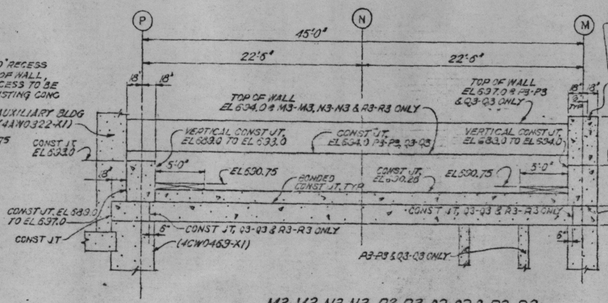

M3-M3, N3-N3, P3-P3, Q3-Q3 & R3-R3
M3-M3, P3-P3 & R3-R3 AS SHOWN & NOTED
N3-N3 & Q3-Q3 OPP HAND AND AS NOTED

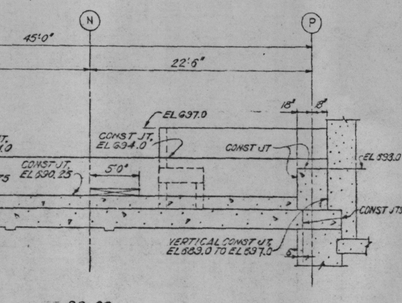

S3-S3

6	SI	4/79									
REV F3-F3 & S3-S3 PER C-34-76											
5	SI	7/27									
REVISED SECTIONS F3-F3, N3-N3, L3-L3, P3-P3 & Q3-Q3.											
4	SI	12-5-77									
REV PER FCR C-13773 IN SECT 3.3											
3	SI	9/13/77									
MINOR REVISIONS, REVISED WALL ELEVATIONS & ADDED WALL 3											
2	SI	1/24/77									
REVISED CONST & WALL ELEVS; PER FCR C-1355, K-338 & D-335											
1	SI	10/27/76									
RELEASED COMP DWG; MINOR REVISIONS; ADDED CONST JT											

REV NO.	ECN NO.	DATE	DSGN	DRWN	CHKD	SUPV	CIVIL	MECH	ELEC	ARCH	APPR
DSGN S.E. SHEPARD											
DRWN G.J. MALICK											
CHKD COLE, ATKINSON, P.R. THRESHER											
SUPV B. HOAGLAND											

INSP
ENGINEER
John F. Cole

CONTROL BUILDING
UNITS 1 & 2

CONCRETE
ROOF SLAB EL 689.0
OUTLINE

BELLEFONTE NUCLEAR PLANT
TENNESSEE VALLEY AUTHORITY
DIVISION OF ENGINEERING DESIGN

SUBMITTED	RECOMMENDED	APPROVED
Earl S. Cole	C.R. Thresher	R.H. Shell

KNOXVILLE | 12-10-75 | 88 | 4CW0472-X1-3R8

RECORD DRAWING AS CONSTRUCTED

PRINTS REQD-R
BR W
PRO- DWT SIZE
7 1

WE		
CE		
CS		
AD		
CO		
ED		
MD		
EF		
SW		
BL		
PA		

Docket # 50-438/439
Control # 8209080002
Date 8/23/82 of Document
REGULATORY DOCKET FILE

POOR ORIGINAL

SCALE 3/16"=1'-0", EXCEPT AS NOTED
COMPANION DRAWINGS: 4CW0472-X1-1 & -2

8209080021