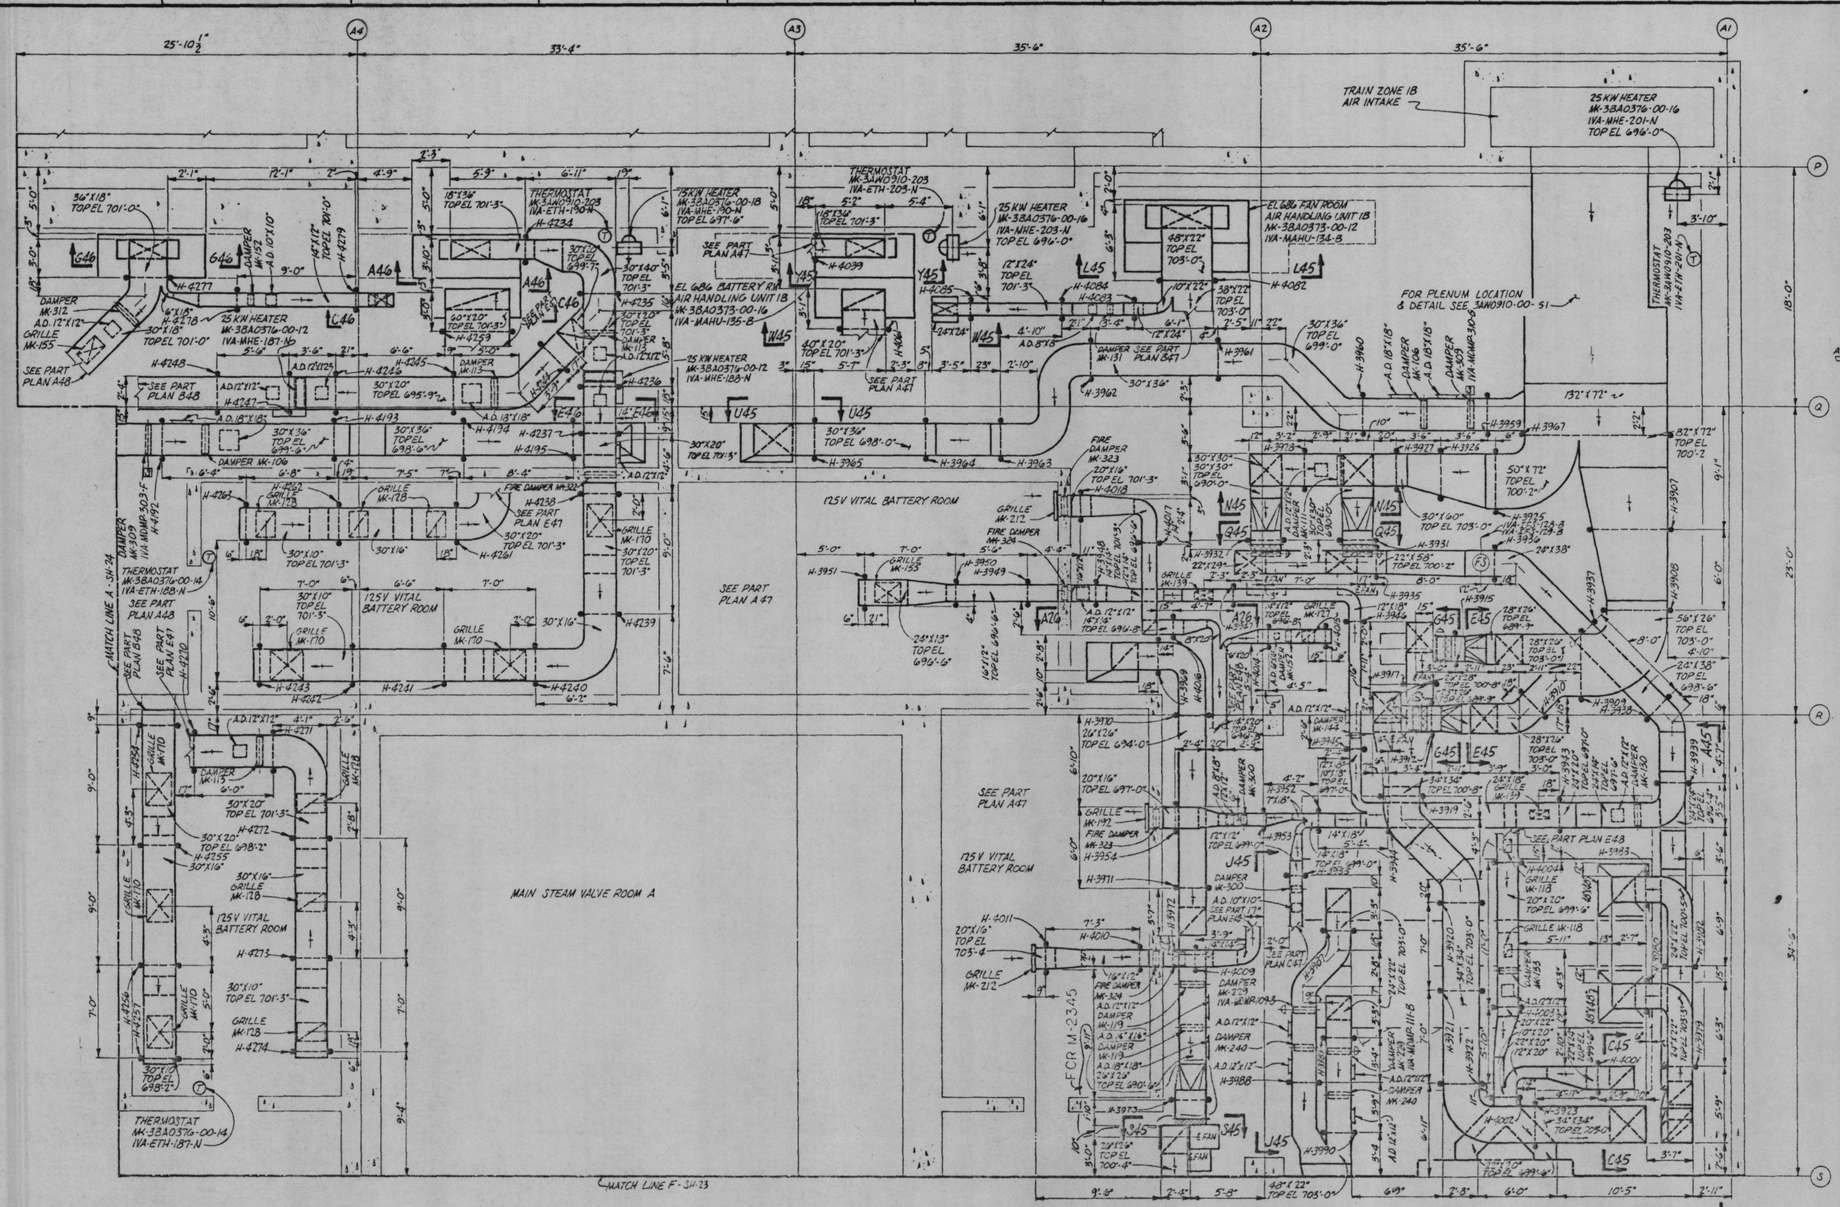

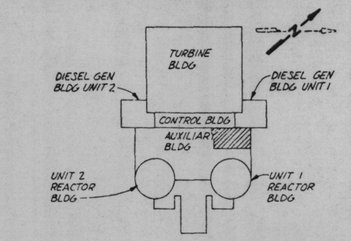

KEY PLAN
NOT TO SCALE

ASSUMED NORTH

NOTES:
1. FOR GENERAL NOTES, REFERENCE DRAWINGS, AND SUPPORT LEGEND SEE 3AW0910-00-01.
2. DUCT SUPPORT LOCATIONS ARE APPROXIMATE. INSTALLED SUPPORTS THIS SHEET MAY VARY ± 6 INCHES FROM LOCATIONS SHOWN TO FACILITATE COMPATIBILITY WITH SUPPORT STEEL AND ELIMINATE INTERFERENCES.
3. ALL DUCT ON THIS SHEET IS SEISMIC CATEGORY I.

PRC APERTURE CARD

Docket # 50-438/439
Control # 8209080002
Date 8/23/82 of Document
REGULATORY DOCKET FILE

REV NO.	ECN NO.	DATE	DSGN	DRWN	CHKD	SUPV	ENGR	INSP	SUBM	RECM	APPR
5	S1	2-17-78	[illegible]	[illegible]	[illegible]	[illegible]	[illegible]	[illegible]	[illegible]	[illegible]	[illegible]
	RELOCATED H-3973 PER [illegible]345 AND MINOR REVISIONS.										
4	J1	12-21-77	[illegible]	[illegible]	[illegible]	[illegible]	[illegible]	[illegible]	[illegible]	[illegible]	[illegible]
	REVISED DUCT SIZE FOR FIRE DMPR AND MINOR REVISIONS.										
3	J1	10-11-77	[illegible]	[illegible]	[illegible]	[illegible]	[illegible]	[illegible]	[illegible]	[illegible]	[illegible]
	RELOCATED H-3932, H-3931, H-3917, H-3919 PER FCR M-1117										
2	S1	6-28-77	[illegible]	[illegible]	[illegible]	[illegible]	[illegible]	[illegible]	[illegible]	[illegible]	[illegible]
	ADDED BACKDRAFT DAMPERS & MINOR REVISIONS.										
1	J1, 381	12-21-77	[illegible]	[illegible]	[illegible]	[illegible]	[illegible]	[illegible]	[illegible]	[illegible]	[illegible]
	ADDED FIRE DAMPS, FLOW SWITCHES, RELEASED HOLD, & MINOR REVISIONS.										

DSGN [illegible] INSP
DRWN [illegible]
CHKD [illegible]
SUPV [illegible] ENGINEER [illegible]

AUXILIARY BUILDING
UNITS 1 & 2

MECHANICAL
HEATING AND VENTILATION

BELLEFONTE NUCLEAR PLANT
TENNESSEE VALLEY AUTHORITY
DIVISION OF ENGINEERING DESIGN

Q

SUBMITTED	RECOMMENDED	APPROVED
[illegible]	[illegible]	[illegible]

KNOXVILLE 2-23-77 | 88 M 3AW0910-00-22 R5

RECORD DRAWING AS CONSTRUCTED

PRINTS REQD — BR 24 PROJ

DWG	SIZE F	SIZE H
ME		
EE		
CE		
AD		1
CO		
EO		
MD		
BF		
SW		
BL		
PA		

POOR ORIGINAL

8209080023