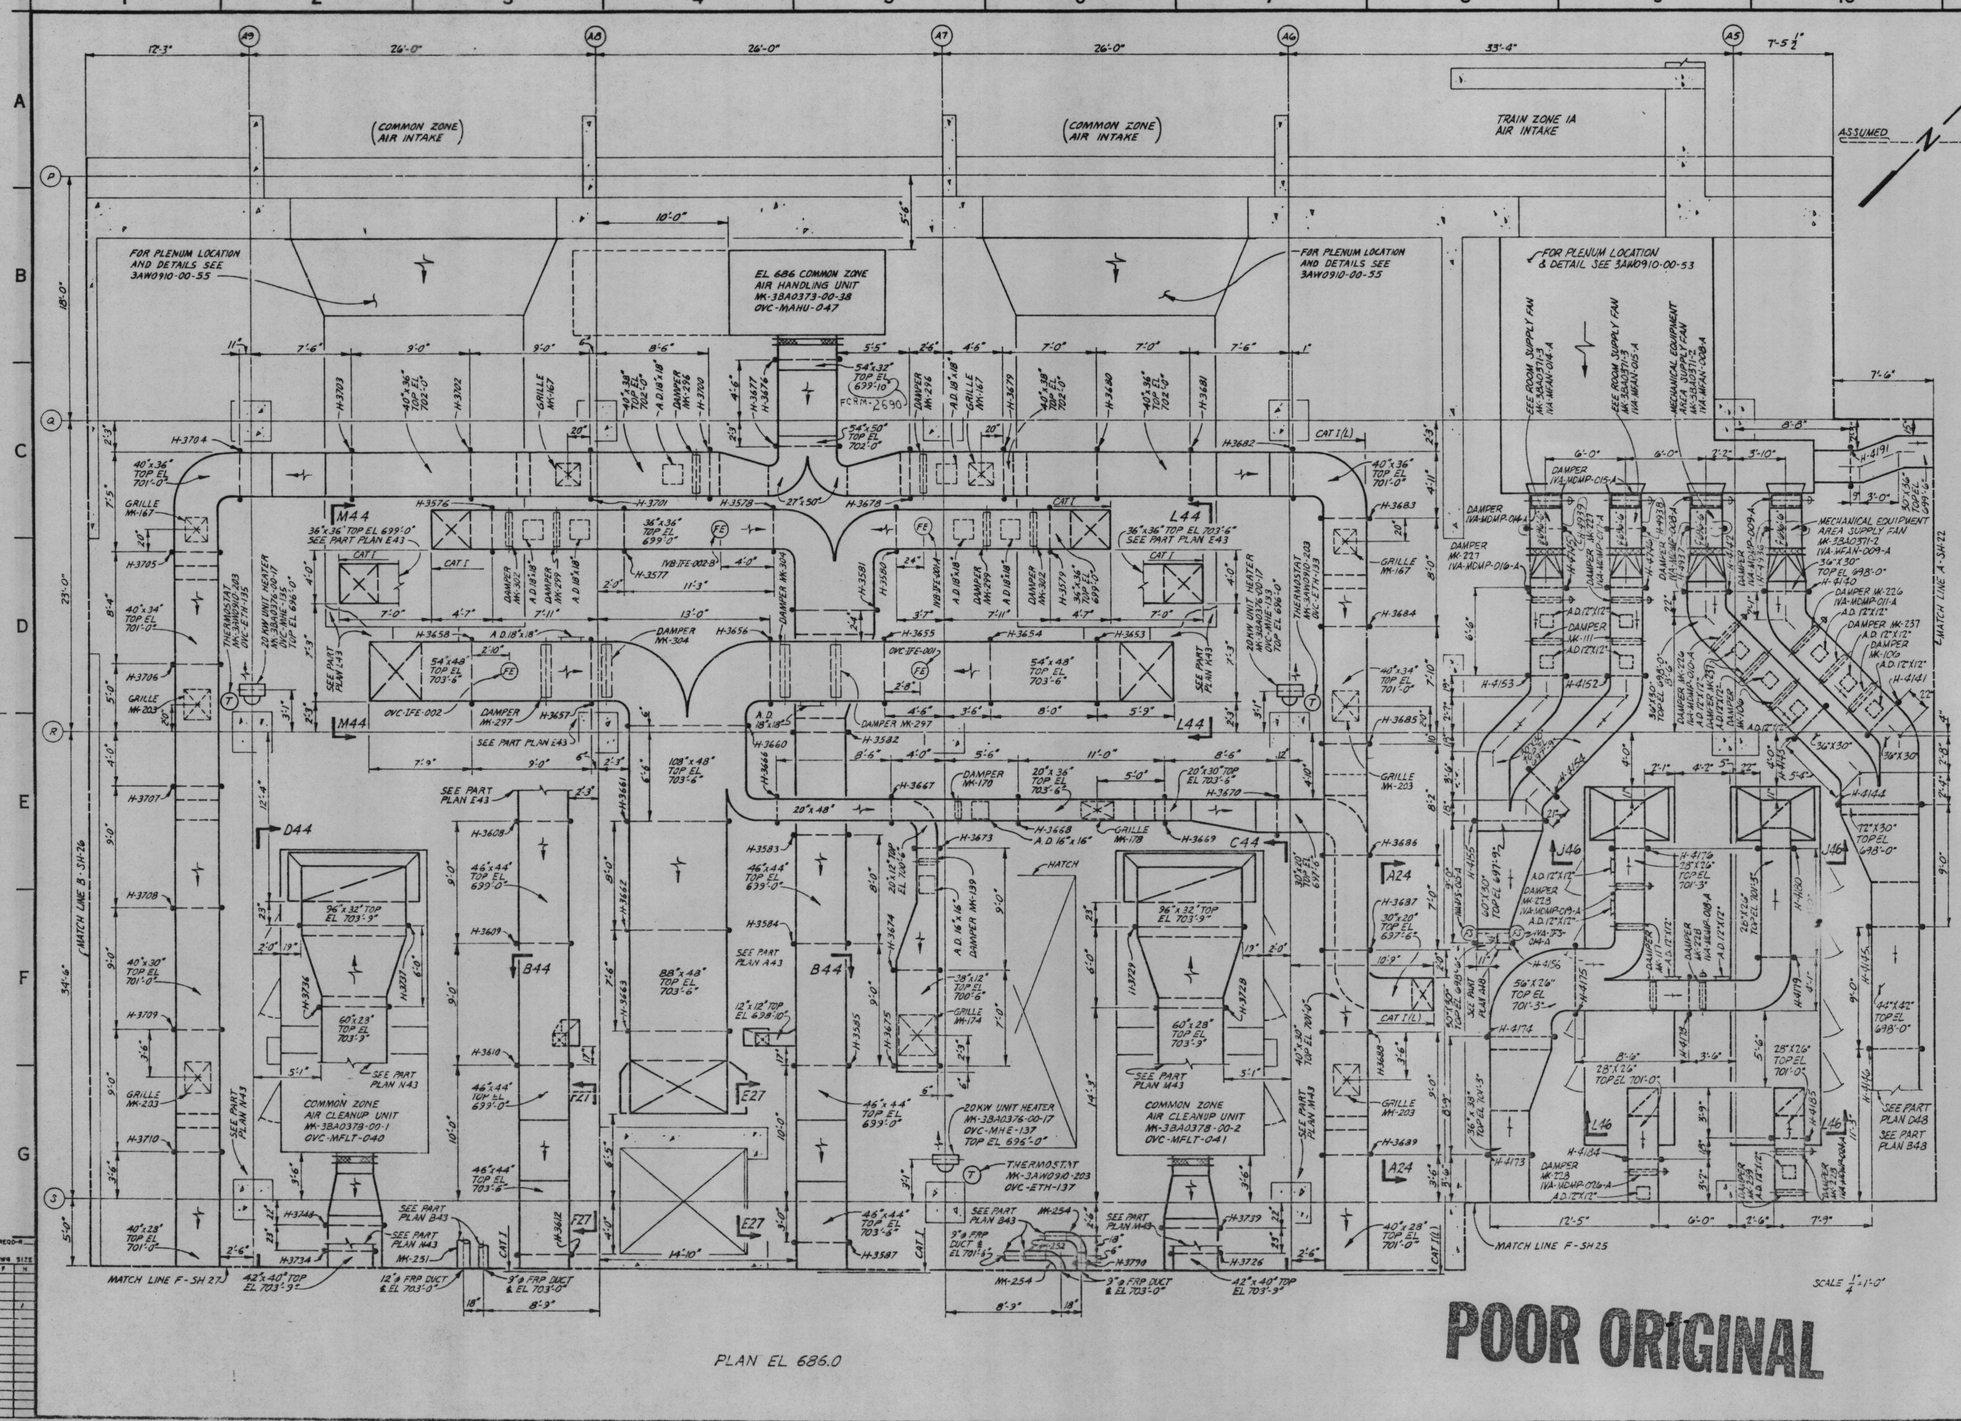

PLAN EL 686.0

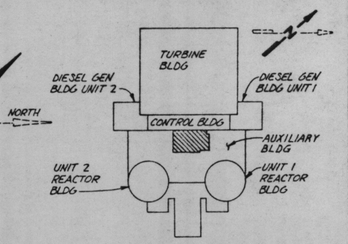

KEY PLAN
NOT TO SCALE

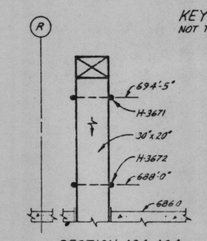

SECTION A24-A24

NOTES:
1. FOR GENERAL NOTES, REFERENCE DRAWINGS, AND SUPPORT LEGEND SEE DWG 3AW0910-00-01.
2. DUCT SUPPORT LOCATIONS ARE APPROXIMATE. INSTALLED SUPPORTS THIS SHEET MAY VARY ±6 INCHES FROM LOCATIONS SHOWN TO FACILITATE COMPATIBILITY WITH SUPPORT STEEL AND ELIMINATE INTERFERENCES.
3. ALL DUCT ON THIS SHEET BOUNDED BY (P) TO (S) AND NORTH OF (A6) IS SEISMIC CATEGORY I EXCEPT AS NOTED.
4. ALL DUCT ON THIS SHEET SOUTH OF (A6) IS SEISMIC CATEGORY I(L) EXCEPT AS NOTED.

PRC APERTURE CARD

Docket # 50-438/439
Control # 8209080002
Date 8/23/82 of Document
REGULATORY DOCKET FILE

REV NO.	ECN NO.	DATE	DSGN	DRWN	CHKD	SUPV	ENGR	INSP	SUBM	RECM	APPR
5	S1										
	REVISED DUCT PER FCR M-2690, ADDED FAN SUPPORTS H-4936 THRU H-4939.										
4	S1	2-27-81									
	RELOCATED FLOW ELEMENT PER FCR M-2402.										
3	S1	2-25-79									
	RELOCATED SUPPORT PER FCR: M1344.										
2	S1	9-5-79									
	REVISED SUPPORT LOCATION PER FCR M-966 AND MINOR REVISIONS.										
1	S1	2-21-78									
	ADDED FLOW SWITCHES AND MINOR REVISIONS.										

DSGN / DRWN / CHKD / SUPV — INSP — ENGINEER

AUXILIARY BUILDING
UNITS 1 & 2

MECHANICAL
HEATING AND VENTILATION

BELLEFONTE NUCLEAR PLANT
TENNESSEE VALLEY AUTHORITY
DIVISION OF ENGINEERING DESIGN

Q

SUBMITTED — RECOMMENDED — APPROVED

KNOXVILLE 2-27-78 38 M 3AW0910-00-24 R 5

RECORD DRAWING AS CONSTRUCTED

POOR ORIGINAL

8209080029