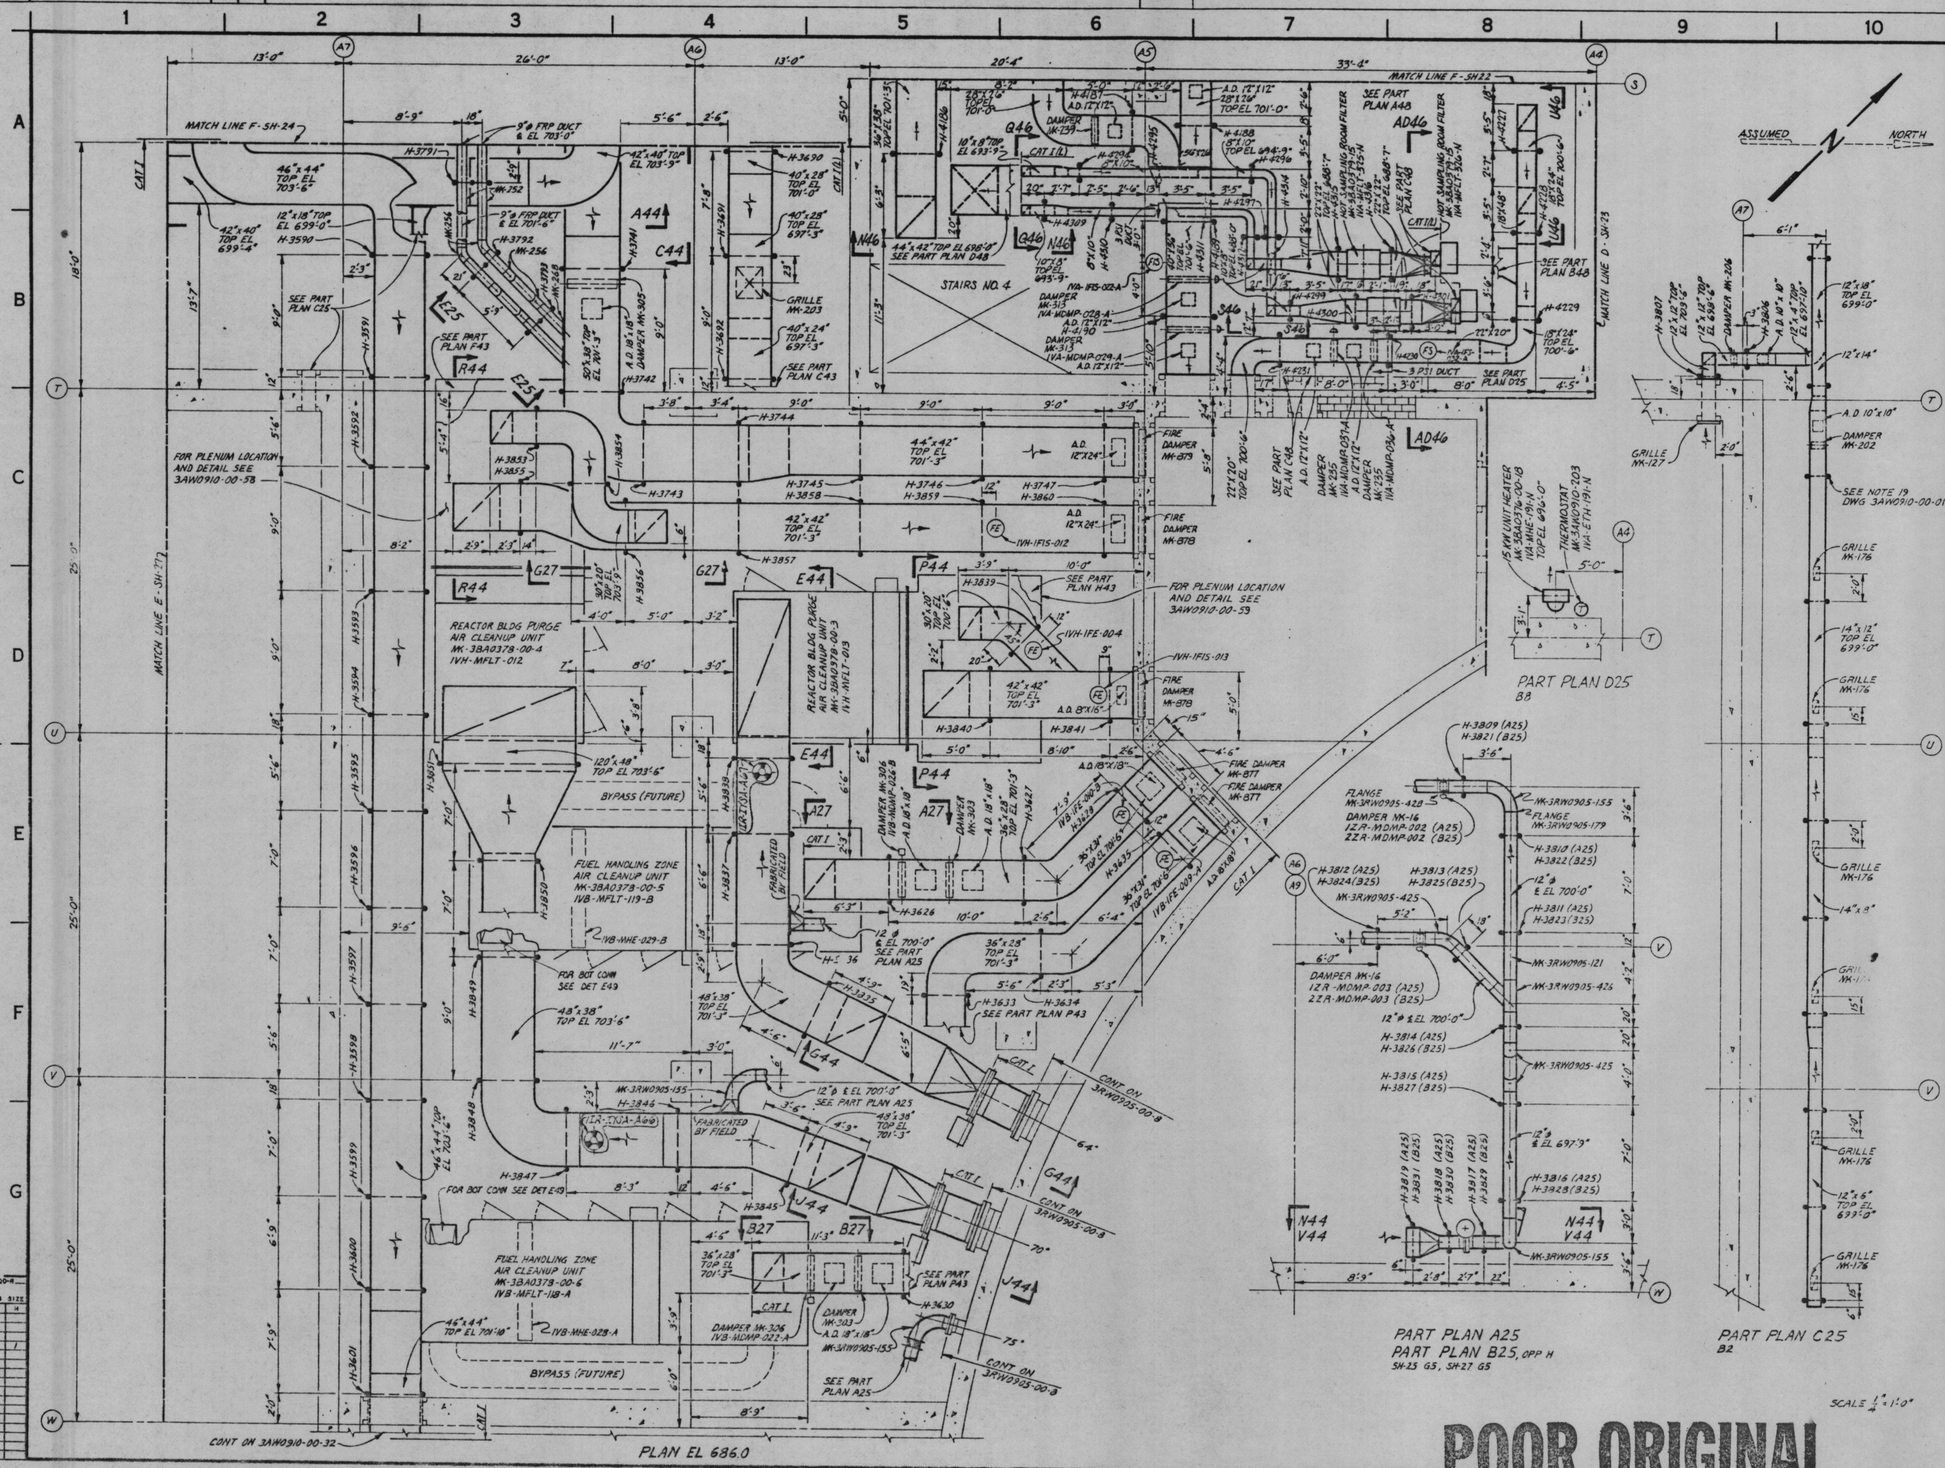

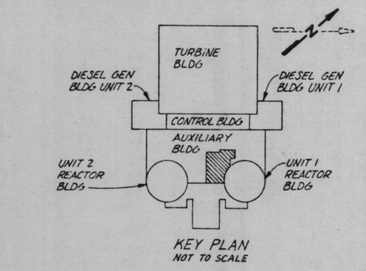

KEY PLAN
NOT TO SCALE

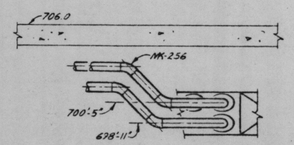

SECTION E25-E25

NOTES:
1. FOR GENERAL NOTES, REFERENCE DRAWINGS, AND SUPPORT LEGEND SEE DWG 3AW0910-00-01.
2. DUCT SUPPORT LOCATIONS ARE APPROXIMATE. INSTALLED SUPPORTS THIS SHEET MAY VARY ± 6 INCHES FROM LOCATIONS SHOWN TO FACILITATE COMPATIBILITY WITH SUPPORT STEEL AND ELIMINATE INTERFERENCES.
3. ALL DUCT ON THIS SHEET BOUNDED BY (A4) AND (A6), WEST OF (T) IS SEISMIC CATEGORY I EXCEPT AS NOTED. DUCT IN ALL OTHER AREAS ON THIS SHEET IS SEISMIC CATEGORY I (L) EXCEPT AS NOTED.

PRC APERTURE CARD

Docket # 50-438/439
Control # 8209080002
Date 8/23/82 of Document
REGULATORY DOCKET FILE

REV NO.	ECN NO.	DATE	DSGN	DRWN	CHKD	SUPV	ENGR	INSP	SUBM	RECM	APPR
3	541	10-4-79									
	ADDED RADIATION MONITORS										
2	51	6-26-79									
	REVISED DIM TO MATCH FAN FDN.										
1	51, 381	12-21-78									
	ADDED FIRE DMPRS, FLOW SWITCHES AND MINOR REVISIONS										

DSGN
DRWN
CHKD
SUPV
INSP
ENGINEER

AUXILIARY BUILDING
UNITS 1&2

MECHANICAL
HEATING AND VENTILATION

BELLEFONTE NUCLEAR PLANT
TENNESSEE VALLEY AUTHORITY
DIVISION OF ENGINEERING DESIGN
Q

SUBMITTED | RECOMMENDED | APPROVED

KNOXVILLE 2-27-78 | 38 | M | 3AW0910-00-25 | R3
RECORD DRAWING AS CONSTRUCTED

POOR ORIGINAL

8209080031