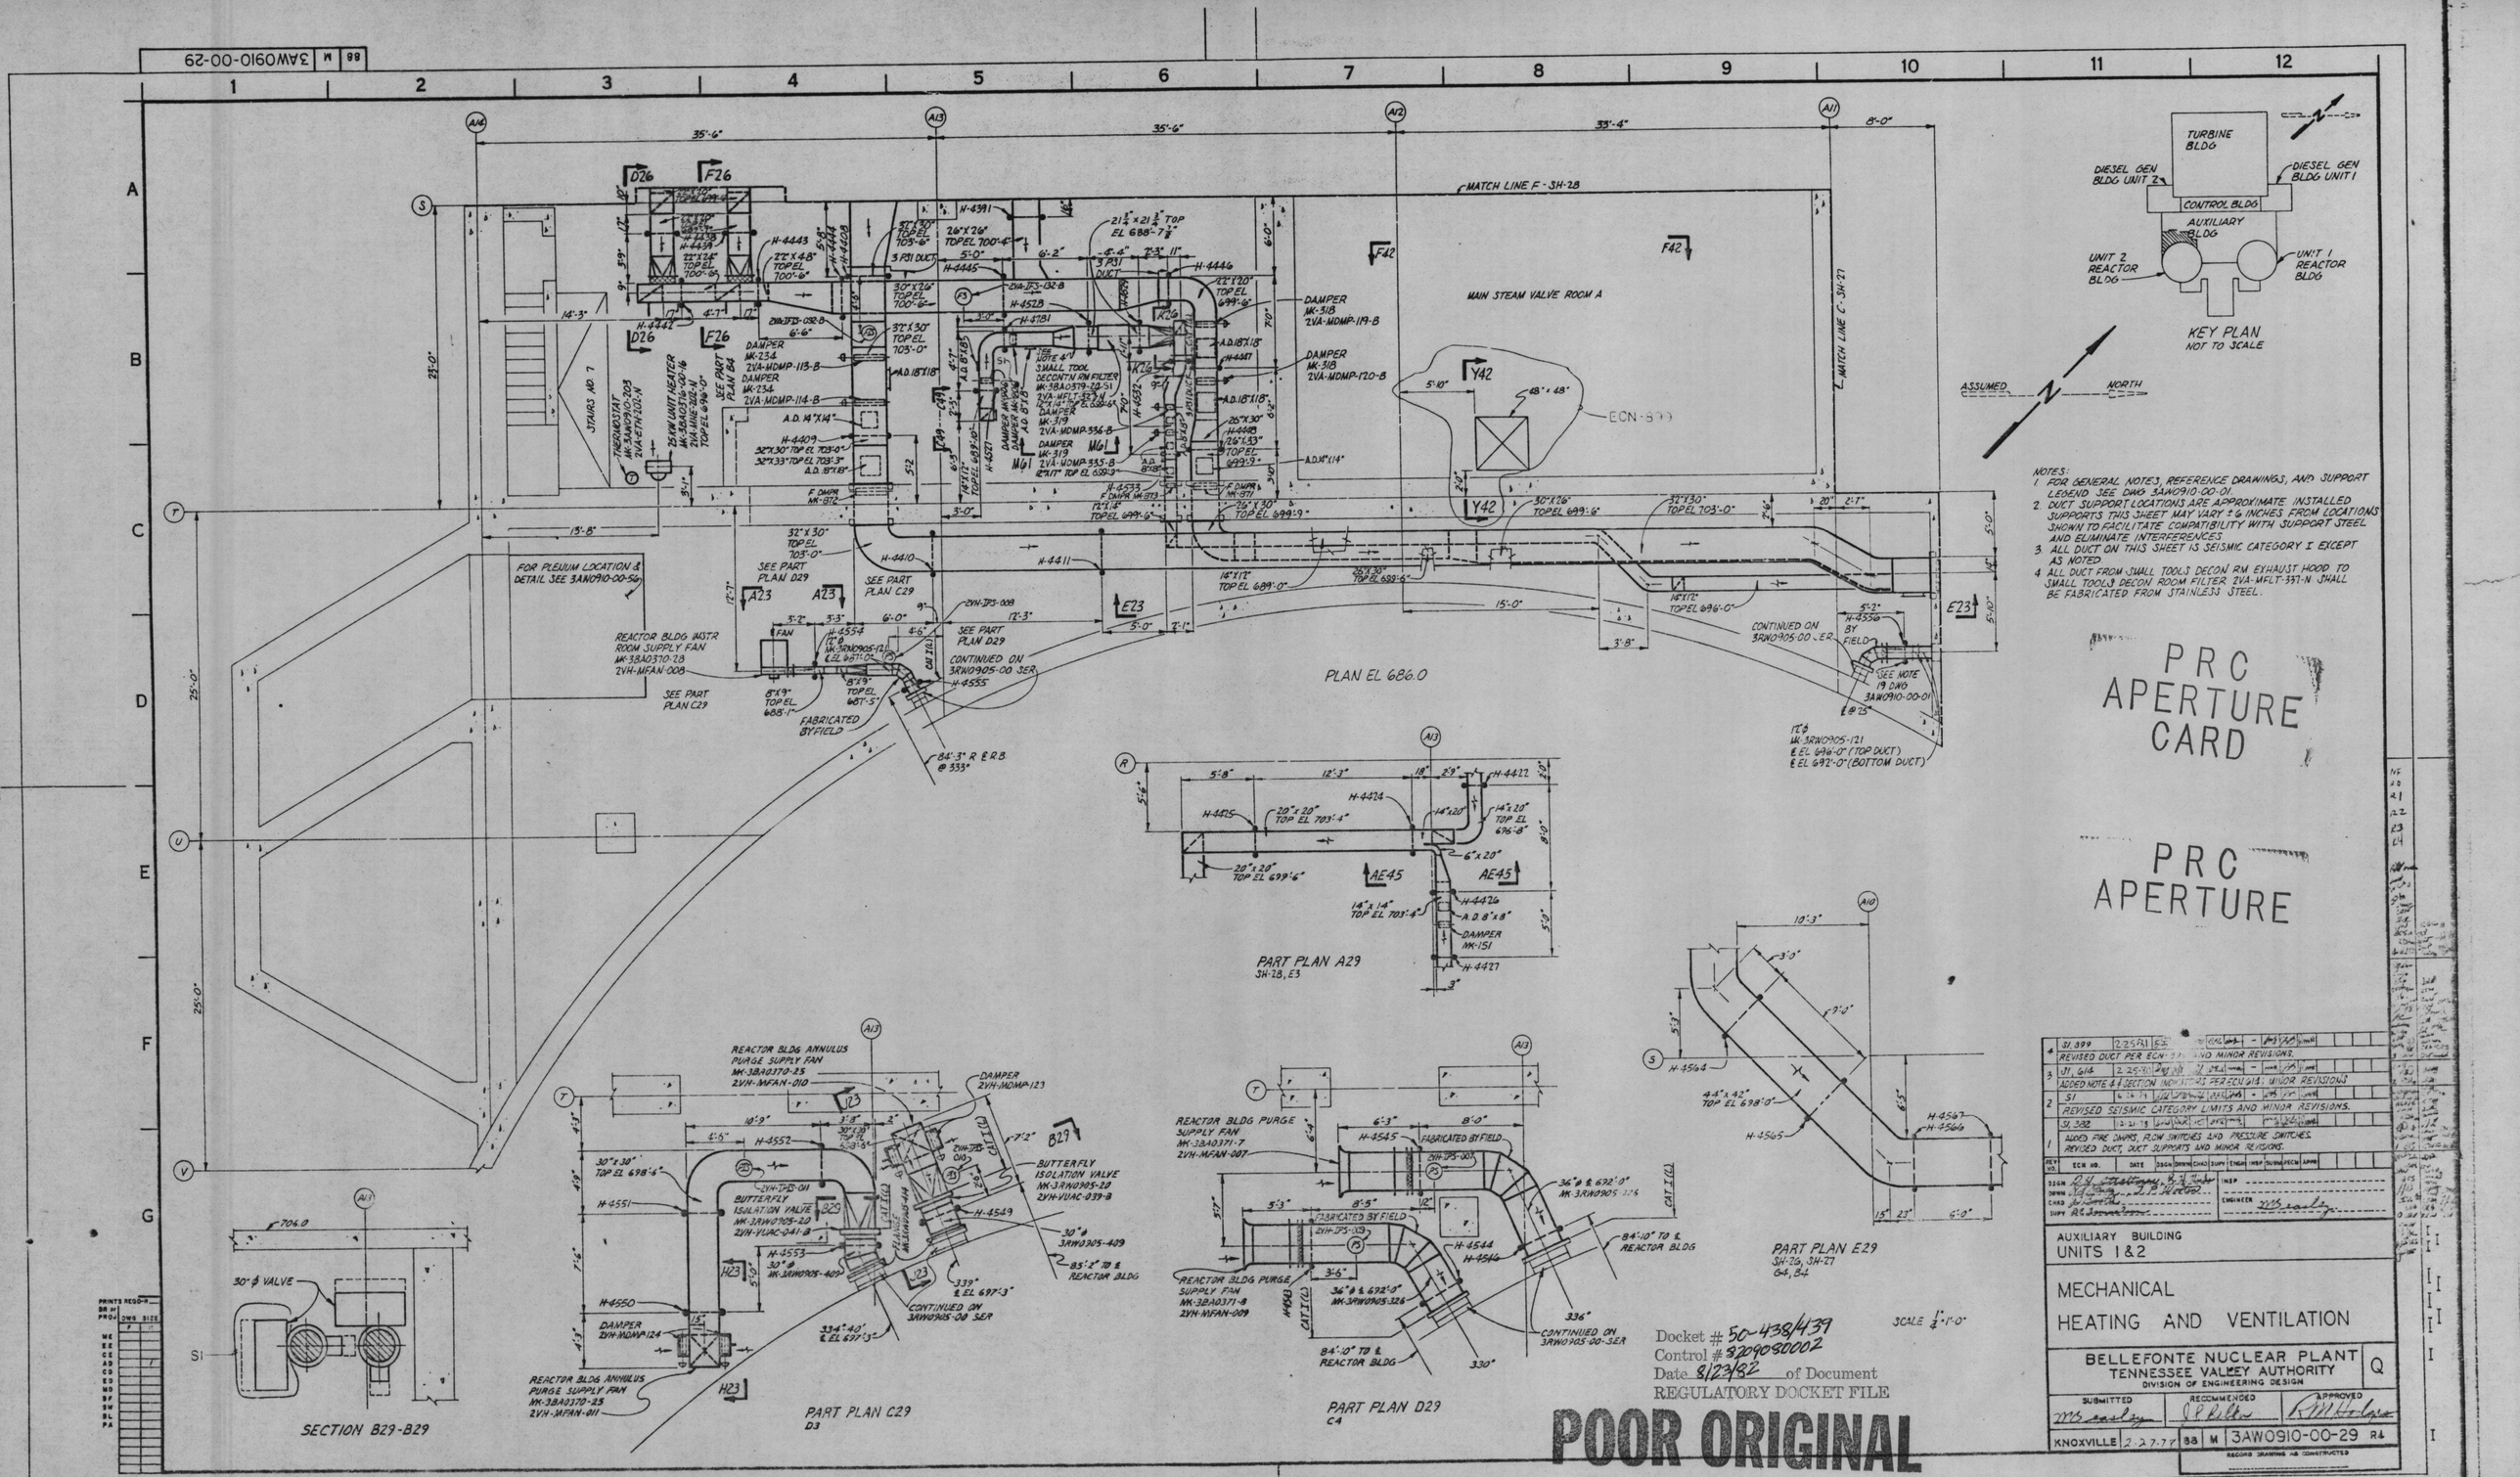

NOTES:
1. FOR GENERAL NOTES, REFERENCE DRAWINGS, AND SUPPORT LEGEND SEE DWG 3AW0910-00-01.
2. DUCT SUPPORT LOCATIONS ARE APPROXIMATE INSTALLED SUPPORTS THIS SHEET MAY VARY ± 6 INCHES FROM LOCATIONS SHOWN TO FACILITATE COMPATIBILITY WITH SUPPORT STEEL AND ELIMINATE INTERFERENCES.
3. ALL DUCT ON THIS SHEET IS SEISMIC CATEGORY I EXCEPT AS NOTED.
4. ALL DUCT FROM SMALL TOOLS DECON RM EXHAUST HOOD TO SMALL TOOLS DECON ROOM FILTER 2VA-MFLT-337-N SHALL BE FABRICATED FROM STAINLESS STEEL.

PRC APERTURE CARD

PRC APERTURE

REV NO.	ECN NO.	DATE	DSGN	DRWN	CHKD	SUPV	ENGR	INSP	SUBM	RECM	APPR
4	S1, 899	2-25-81	[illegible]	[illegible]	[illegible]	[illegible]	-	[illegible]	[illegible]	[illegible]	
	REVISED DUCT PER ECN-[illegible] AND MINOR REVISIONS.										
3	J1, 614	2-25-80	[illegible]	[illegible]	[illegible]	[illegible]	-	[illegible]	[illegible]	[illegible]	
	ADDED NOTE 4 & SECTION INDICATORS PER ECN 614; MINOR REVISIONS										
2	S1	6-26-79	[illegible]	[illegible]	[illegible]	[illegible]	-	[illegible]	[illegible]	[illegible]	
	REVISED SEISMIC CATEGORY LIMITS AND MINOR REVISIONS.										
1	S1, 382	12-21-78	[illegible]	[illegible]	[illegible]	[illegible]	[illegible]	[illegible]	[illegible]	[illegible]	
	ADDED FIRE DAMPS, FLOW SWITCHES AND PRESSURE SWITCHES. REVISED DUCT, DUCT SUPPORTS AND MINOR REVISIONS.										

DSGN R. Y. Strattman, B. H. Hodge
DRWN [illegible], J. P. Hooton
CHKD [illegible]
SUPV R. E. Jonathan
INSP
ENGINEER [illegible]

AUXILIARY BUILDING
UNITS 1 & 2

MECHANICAL
HEATING AND VENTILATION

BELLEFONTE NUCLEAR PLANT
TENNESSEE VALLEY AUTHORITY
DIVISION OF ENGINEERING DESIGN

Q

SUBMITTED [illegible] RECOMMENDED [illegible] APPROVED [illegible]

KNOXVILLE 2-27-77 | 88 | M | 3AW0910-00-29 | R4

RECORD DRAWING AS CONSTRUCTED

Docket # 50-438/439
Control # 8209080002
Date 8/23/82 of Document
REGULATORY DOCKET FILE

POOR ORIGINAL

8209080043