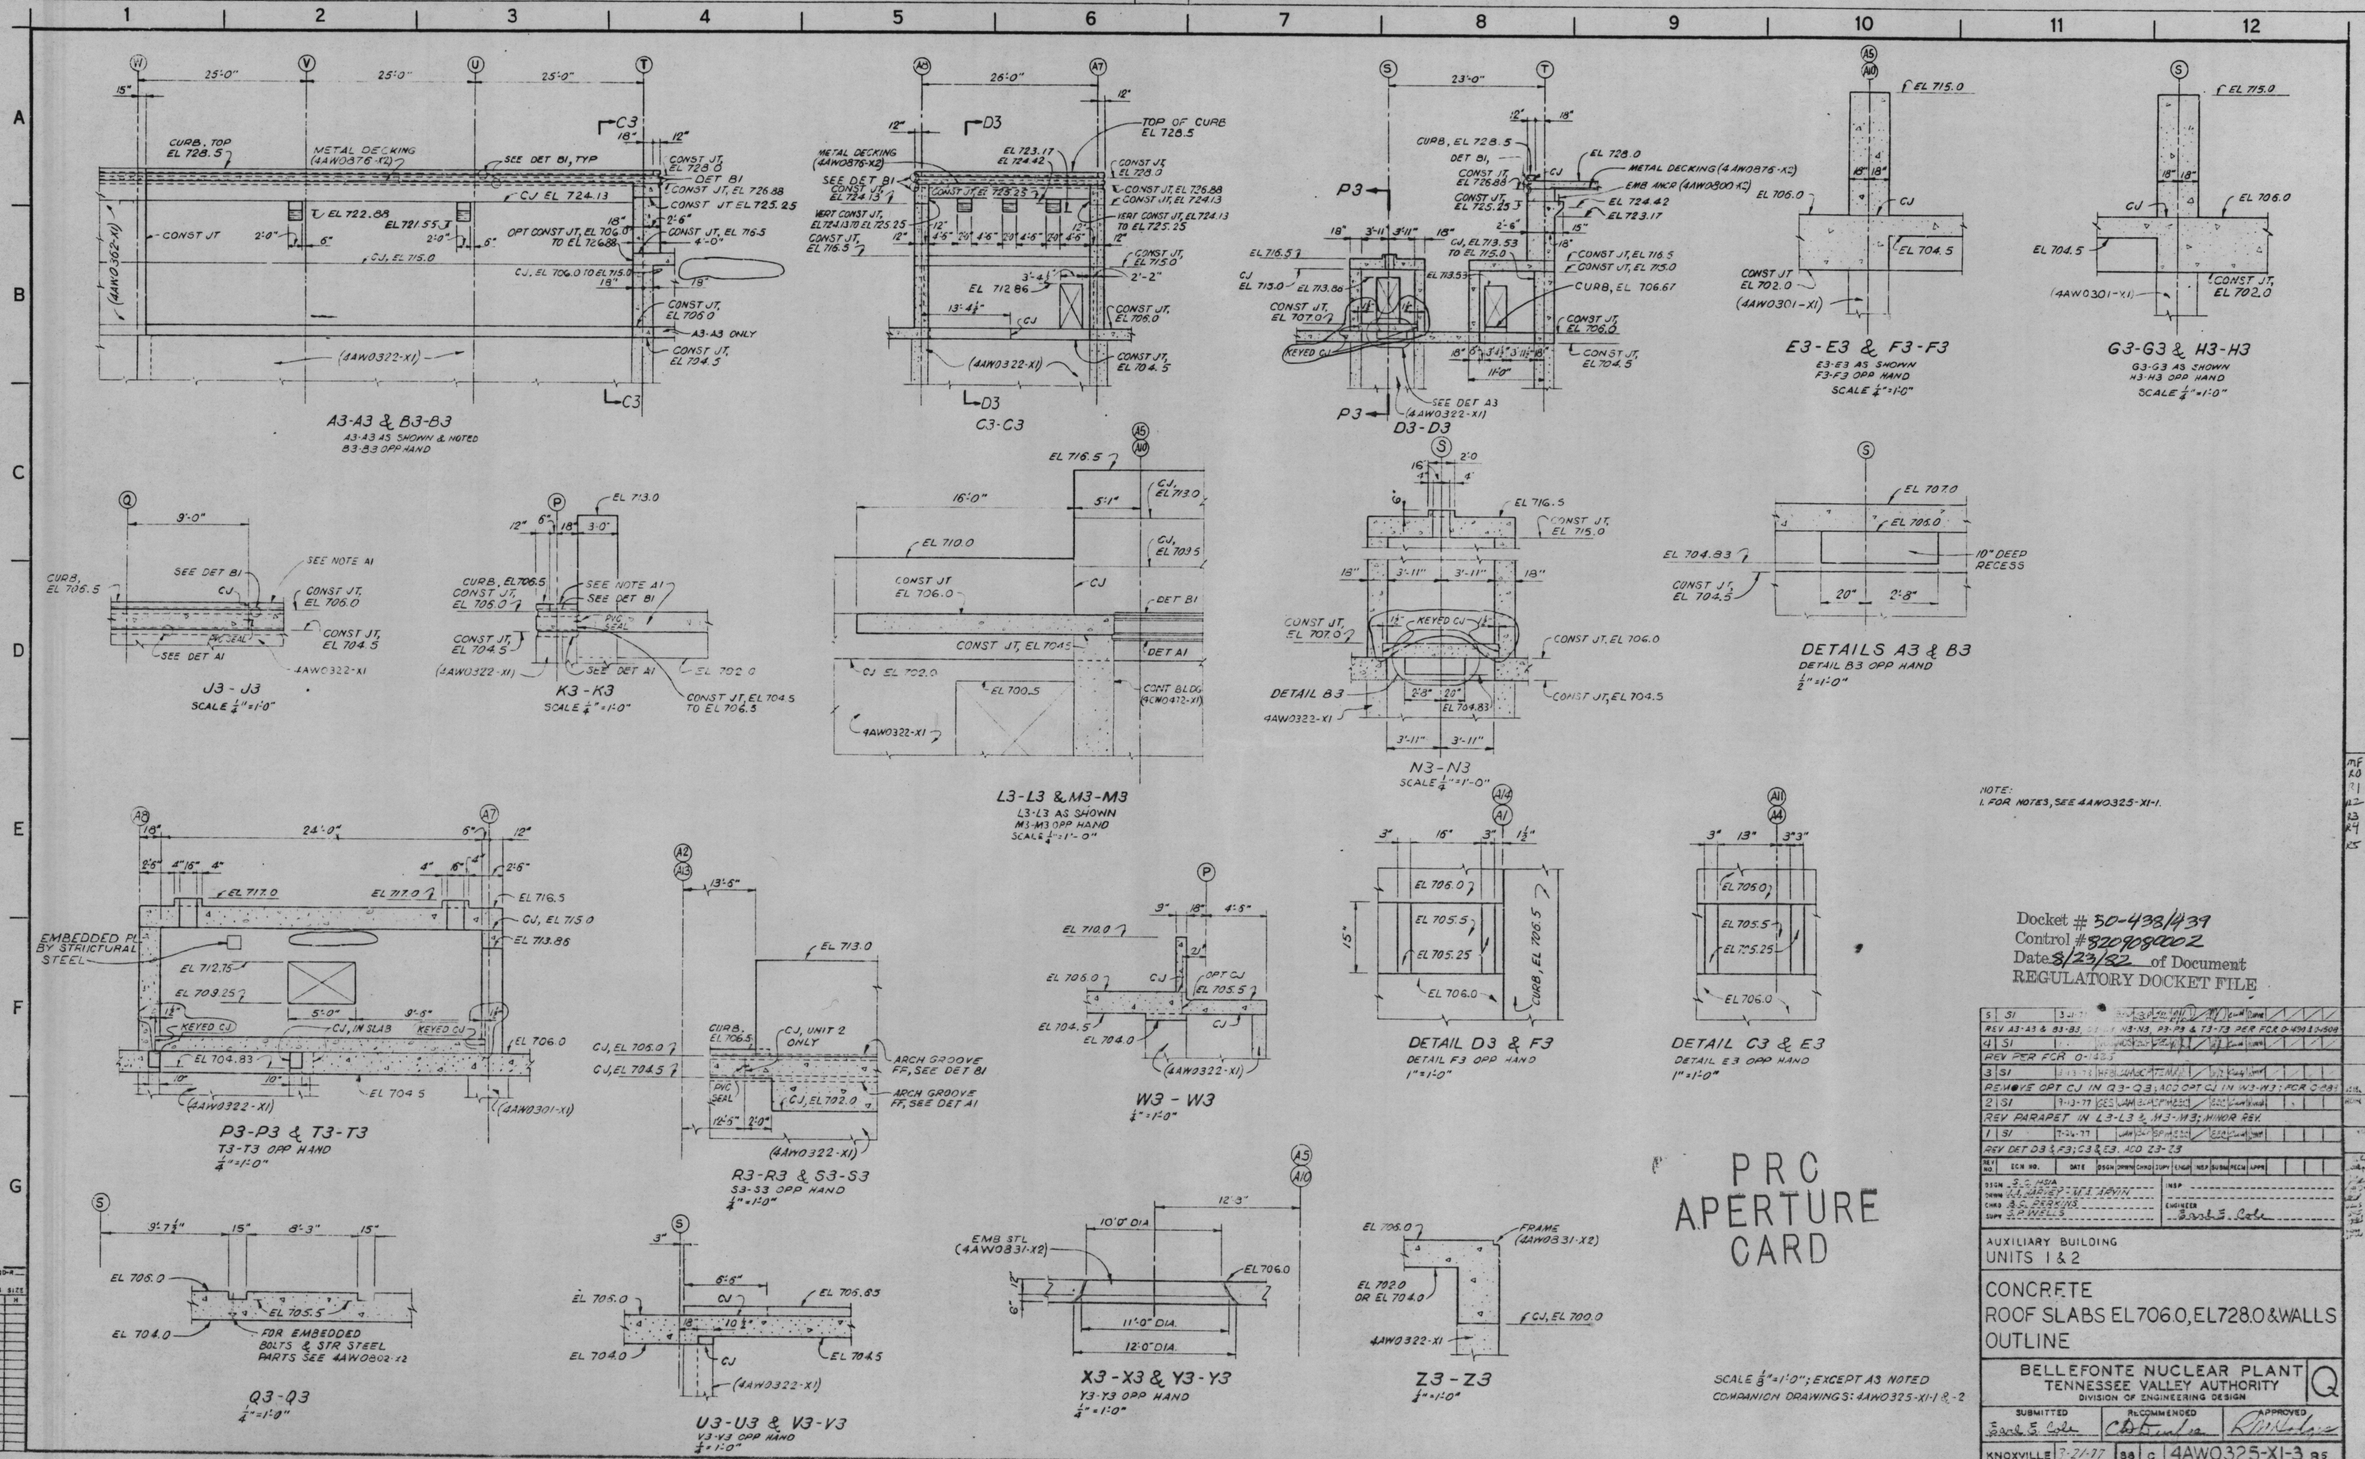
A3-A3 & B3-B3
A3-A3 AS SHOWN & NOTED
B3-B3 OPP HAND
C3-C3
D3-D3
E3-E3 & F3-F3
E3-E3 AS SHOWN
F3-F3 OPP HAND
SCALE 1/4"=1'-0"
G3-G3 & H3-H3
G3-G3 AS SHOWN
H3-H3 OPP HAND
SCALE 1/4"=1'-0"
J3 - J3
SCALE 1/4"=1'-0"
K3 - K3
SCALE 1/4"=1'-0"
L3-L3 & M3-M3
L3-L3 AS SHOWN
M3-M3 OPP HAND
SCALE 1/4"=1'-0"
N3 - N3
SCALE 1/4"=1'-0"
DETAILS A3 & B3
DETAIL B3 OPP HAND
1/2"=1'-0"
P3-P3 & T3-T3
T3-T3 OPP HAND
1/4"=1'-0"
R3-R3 & S3-S3
S3-S3 OPP HAND
1/4"=1'-0"
W3 - W3
1/4"=1'-0"
DETAIL D3 & F3
DETAIL F3 OPP HAND
1"=1'-0"
DETAIL C3 & E3
DETAIL E3 OPP HAND
1"=1'-0"
Q3 - Q3
1/4"=1'-0"
U3-U3 & V3-V3
V3-V3 OPP HAND
1/4"=1'-0"
X3 - X3 & Y3 - Y3
Y3-Y3 OPP HAND
1/4"=1'-0"
Z3 - Z3
1/4"=1'-0"
SCALE 1/8"=1'-0"; EXCEPT AS NOTED
COMPANION DRAWINGS: 4AW0325-XI-1 & -2
NOTE:
1. FOR NOTES, SEE 4AW0325-XI-1.
Docket # 50-438/439
Control # 8209080002
Date 8/23/82 of Document
REGULATORY DOCKET FILE
PRC APERTURE CARD
AUXILIARY BUILDING
UNITS 1 & 2
CONCRETE
ROOF SLABS EL 706.0, EL 728.0 & WALLS
OUTLINE
BELLEFONTE NUCLEAR PLANT
TENNESSEE VALLEY AUTHORITY
DIVISION OF ENGINEERING DESIGN
KNOXVILLE 7-21-77 88 C 4AW0325-XI-3 R5
RECORD DRAWING AS CONSTRUCTED
8209080058