NOTES:

1. FOR GENERAL NOTES AND REFERENCE DRAWINGS SEE 5GW1925-NC-01.
2. PANELS 1IX-ILPR-010,-030 AND -031 TO BE FIELD ROUTED. SEE 5RW1925-NC-07 FOR PANEL INSTALLATION. TUBING FOR THESE PANELS SHALL BE B31.1.9.

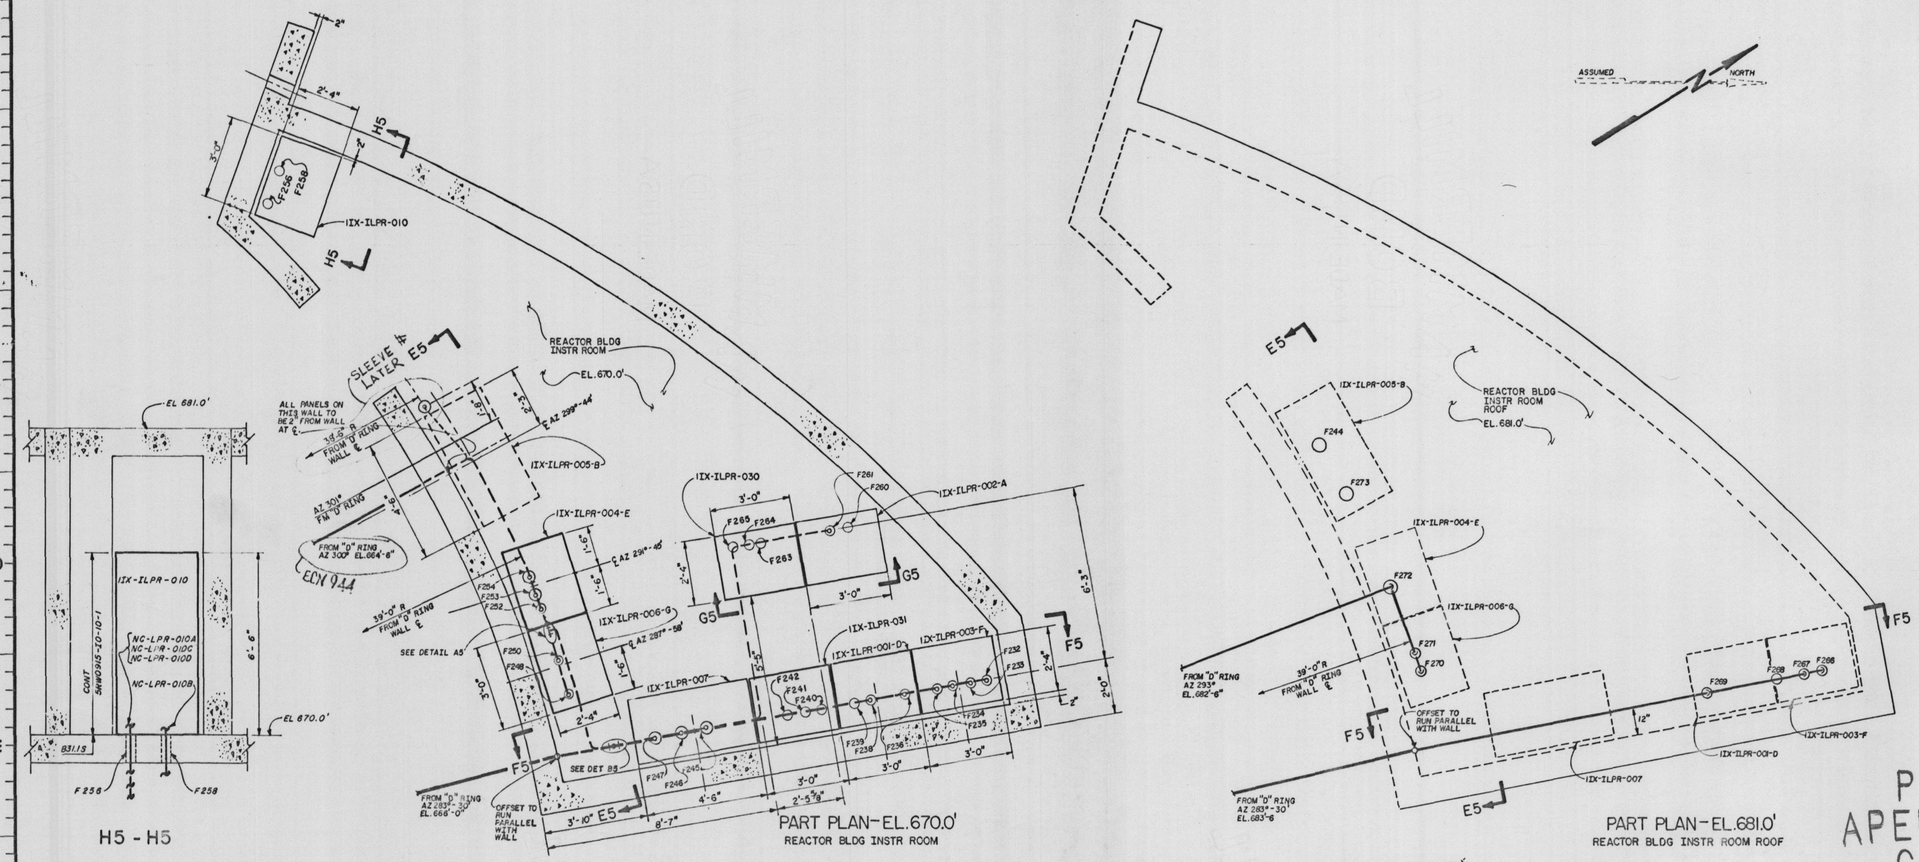

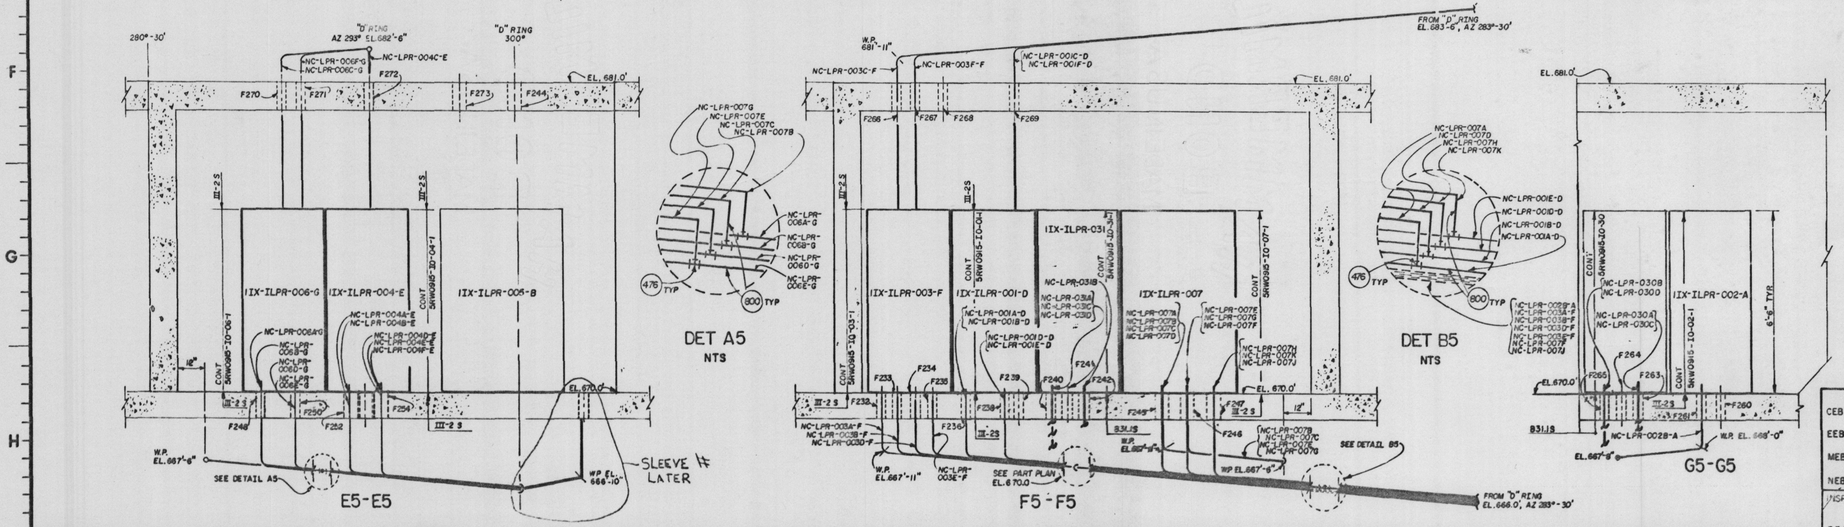

PRC APERTURE CARD

Docket # 50-438/439
Control # 8301060310
Date 12/29/82 of Document
REGULATORY DOCKET FILE

8301060337

REV NO	ECN NO.	DATE	DSGN	DRWN	CHKD	SUPV	ENGR	INSP	SUBM	RECM	APPD
2	944	7-7-82									
INCORPORATED ECN 944											
1	S1	3-10-81									
ADDED 1IX-ILPR-010,-030,-031 AND NOTE 2.											

DSGN J.A. Webb
DRWN J.J. Deery
CHKD J. Jones C. Smith
SUPV E.B. Bennett Jr.
INSP
ENGINEER Charles D. Armstrong

SCALE: 1/2" = 1'-0" EXCEPT AS NOTED

REACTOR BLDG
UNIT 1

INSTRUMENTS & CONTROLS
LCL PNLS 1IX-ILPR-001-D,-002-A,-003-F,-004-E, -006-G,-007,-010,-030 & -031
INSTALLATION EL 670.0

FURTHER REVIEW
CEB R.C. Brewster
EEB N/A
MEB N/A
NEB George F. Dilworth Jr.
INSPECTED AND APPROVED FOR ISSUE

BELLEFONTE NUCLEAR PLANT
TENNESSEE VALLEY AUTHORITY
DIVISION OF ENGINEERING DESIGN

Q

SUBMITTED	RECOMMENDED	APPROVED
C.D. Armstrong	J.L. Sanger	R.M. Gilliland

KNOXVILLE | 10-10-80 | 88 | E | 5RW1925-NC-05 | R2

RECORD DRAWING AS CONSTRUCTED