


A6-A6

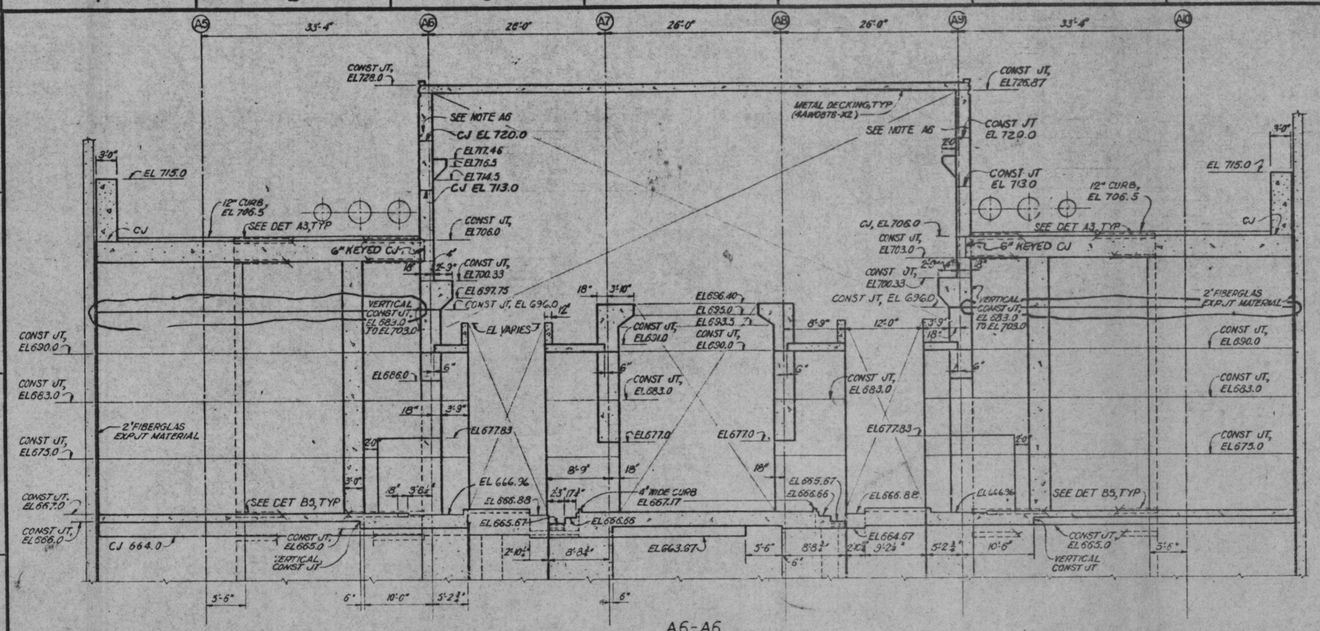


DET A6
SCALE $\frac{3}{8}$"=1'-0"

F6-F6
SCALE $\frac{3}{8}$"=1'-0"

NOTE A6: POURS FOR 22" THICK WALL SECTIONS SHALL BE 501.5 AFW CONCRETE

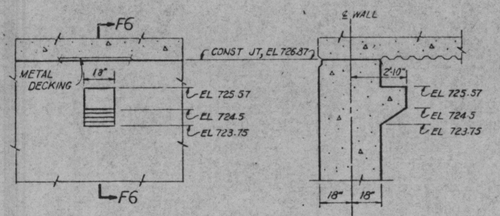


B6-B6 AS SHOWN
C6-C6 OPP HAND




D6-D6 AS SHOWN
E6-E6 OPP HAND

NOTES:
1. FOR LIST OF NOTES AND REFERENCE DRAWINGS SEE 4AW0362-XI-1.
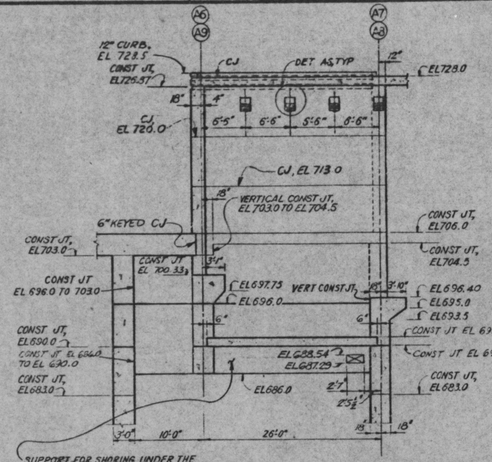
| REV NO. | ECN NO. | DATE | DSGN | DRWN | CHKD | SUPV | ENGR | MGR | SUBM | RECM | APPR |
|---|---|---|---|---|---|---|---|---|---|---|---|
| 6 | SI | 9-23-79 | DLB | DLB | TRL | MWF | | RD | | | |
| REV D6-D8, E6-E8 PER FCR 0-1792; ADD CJ IN A6-A6 | | | | | | | | | | | |
| 5 | SI | 10-19-78 | NDS | NDS | DSR | JD | | RD | | | |
| REV PER FCR 0-1393 | | | | | | | | | | | |
| 4 | SI | 6-21-78 | MFB | BEM | DCS | JD | | RD | | | |
| REVISED CONST JT SECT A6-A6, B6-B6, C8-C8, & D6-D8, E6-E6 | | | | | | | | | | | |
| 3 | SI | 3-13-78 | MFB | MFB | BCP | JEW | | RD | | | |
| REV SECT A6-A6 | | | | | | | | | | | |
| 2 | SI | 8-19-77 | MFB | MFB | DCS | JEW | | RD | | | |
| REV CJ SECT A6, B6 & C8 | | | | | | | | | | | |
| 1 | SI | 7-25-77 | MFB | DCS | JEW | DLB | | RD | | | |
| MINOR REVISIONS, ADDED HVAC OPNGS. | | | | | | | | | | | |

DSGN C.K. HOUSEWRIGHT
DRWN P.V. CHAU
CHKD G.E. SHERARD / C.K. HOUSEWRIGHT
SUPV P.M. WARRINER
INSP
ENGINEER Earl E. Cole

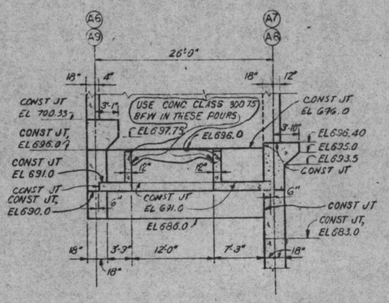AUXILIARY BUILDING STAGE II
UNITS 1&2

CONCRETE
SLABS WALLS AND ROOF ABOVE EL 664.0
OUTLINE

BELLEFONTE NUCLEAR PLANT
TENNESSEE VALLEY AUTHORITY
DIVISION OF ENGINEERING DESIGN

| SUBMITTED | RECOMMENDED | APPROVED |
|---|---|---|
| Earl E. Cole | C.K. Housewright | S.M. Lee |

KNOXVILLE | 5-22-77 | BB | C | 4AW0362-XI-6-R6

RECORD DRAWING AS CONSTRUCTED

PRINTS RECD-4
BR INT
PROJ

| DRG | SIZE |
|---|---|
| | F |
| ME | |
| EE | |
| CE | |
| AD | |
| CD | |
| ED | |
| MD | |
| EF | |
| SW | |
| BL | |
| PA | |

POOR ORIGINAL

PRC APERTURE CARD

Docket # 50-438/439
Control # 8209010340
Date 8/25/82 of Document
REGULATORY DOCKET FILE

SCALE $\frac{1}{8}$"-1'-0" EXCEPT AS NOTED.
COMPANION DRAWINGS 4AW0362-XI-1 THRU 5

8209010348