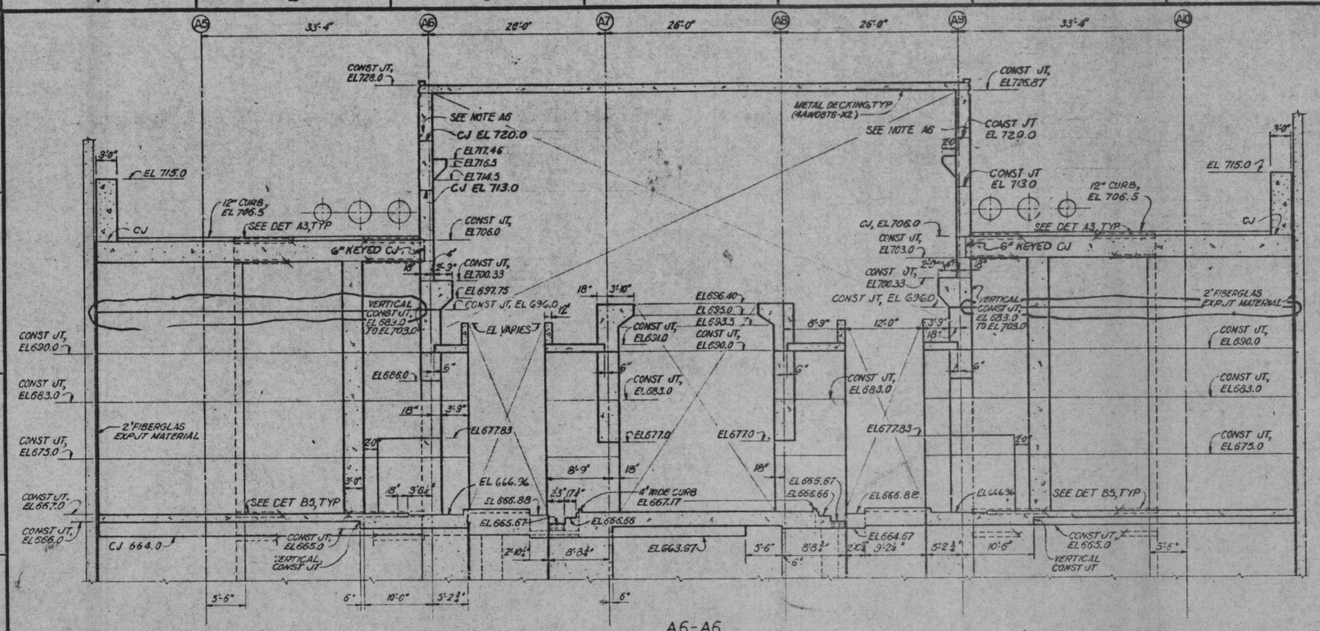

A6-A6

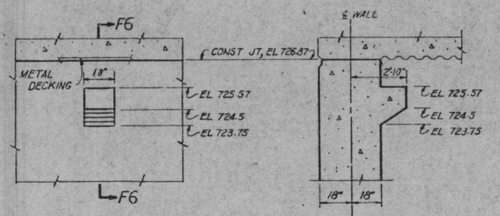

DET A6
SCALE $\frac{3}{8}$"=1'-0"

F6-F6
SCALE $\frac{3}{8}$"=1'-0"

NOTE A6: POURS FOR 22" THICK WALL SECTIONS SHALL BE 501.5 AFW CONCRETE

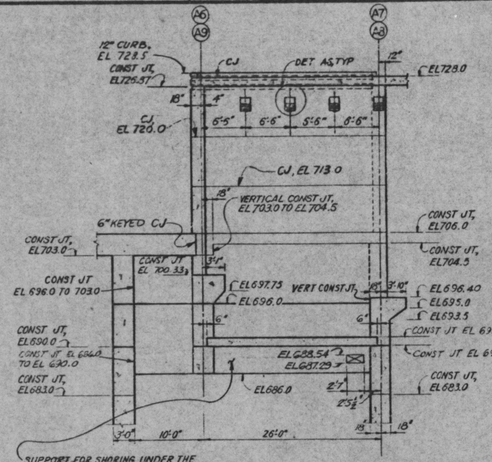

B6-B6 AS SHOWN
C6-C6 OPP HAND

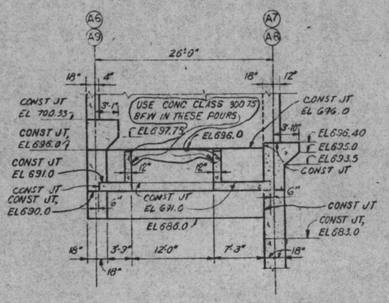

D6-D6 AS SHOWN
E6-E6 OPP HAND

NOTES:
1. FOR LIST OF NOTES AND REFERENCE DRAWINGS SEE 4AW0362-XI-1.

REV NO.	ECN NO.	DATE	DSGN	DRWN	CHKD	SUPV	ENGR	MGR	SUBM	RECM	APPR
6	SI	9-23-79	DLB	DLB	TRL	MWF		RD			
REV D6-D8, E6-E8 PER FCR 0-1792; ADD CJ IN A6-A6											
5	SI	10-19-78	NDS	NDS	DSR	JD		RD			
REV PER FCR 0-1393											
4	SI	6-21-78	MFB	BEM	DCS	JD		RD			
REVISED CONST JT SECT A6-A6, B6-B6, C8-C8, & D6-D8, E6-E6											
3	SI	3-13-78	MFB	MFB	BCP	JEW		RD			
REV SECT A6-A6											
2	SI	8-19-77	MFB	MFB	DCS	JEW		RD			
REV CJ SECT A6, B6 & C8											
1	SI	7-25-77	MFB	DCS	JEW	DLB		RD			
MINOR REVISIONS, ADDED HVAC OPNGS.											

DSGN C.K. HOUSEWRIGHT
DRWN P.V. CHAU
CHKD G.E. SHERARD / C.K. HOUSEWRIGHT
SUPV P.M. WARRINER
INSP
ENGINEER Earl E. Cole

AUXILIARY BUILDING STAGE II
UNITS 1&2

CONCRETE
SLABS WALLS AND ROOF ABOVE EL 664.0
OUTLINE

BELLEFONTE NUCLEAR PLANT
TENNESSEE VALLEY AUTHORITY
DIVISION OF ENGINEERING DESIGN

SUBMITTED	RECOMMENDED	APPROVED
Earl E. Cole	C.K. Housewright	S.M. Lee

KNOXVILLE | 5-22-77 | BB | C | 4AW0362-XI-6-R6

RECORD DRAWING AS CONSTRUCTED

PRINTS RECD-4
BR INT
PROJ

DRG	SIZE
	F
ME	
EE	
CE	
AD	
CD	
ED	
MD	
EF	
SW	
BL	
PA	

POOR ORIGINAL

PRC APERTURE CARD

Docket # 50-438/439
Control # 8209010340
Date 8/25/82 of Document
REGULATORY DOCKET FILE

SCALE $\frac{1}{8}$"-1'-0" EXCEPT AS NOTED.
COMPANION DRAWINGS 4AW0362-XI-1 THRU 5

8209010348