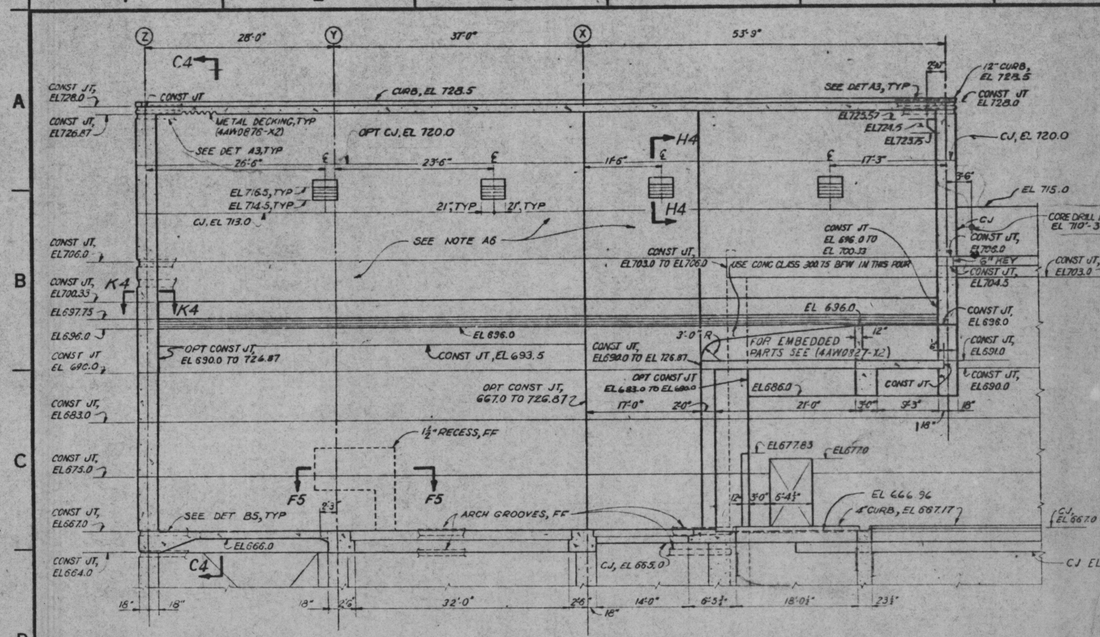

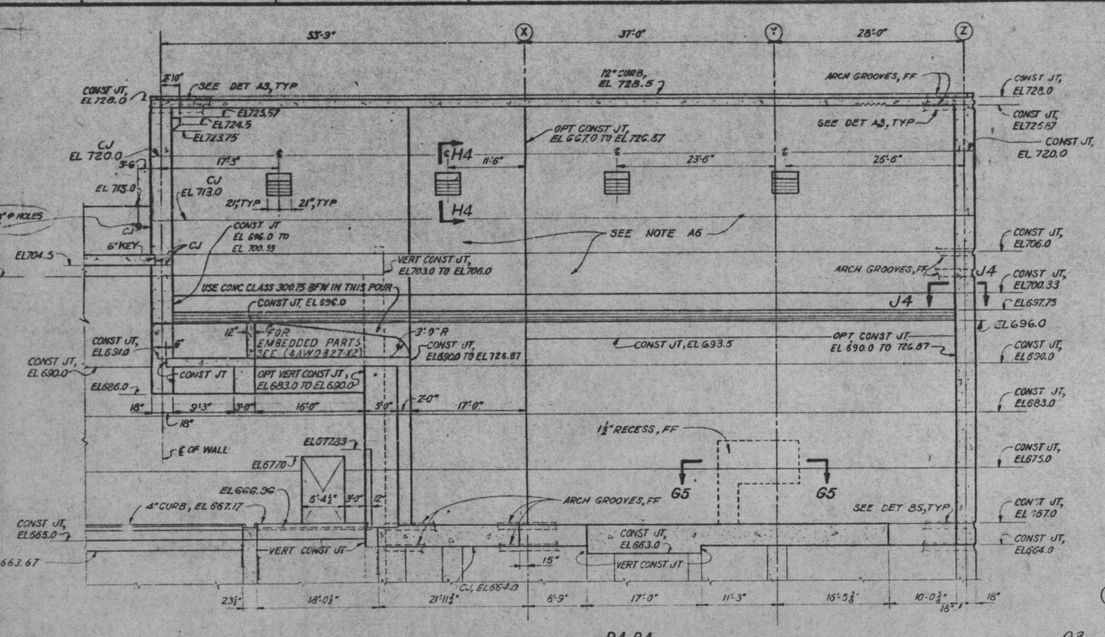

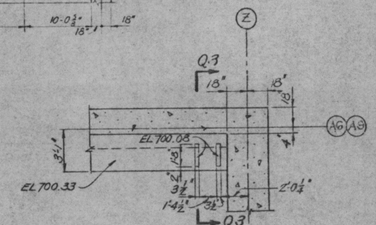

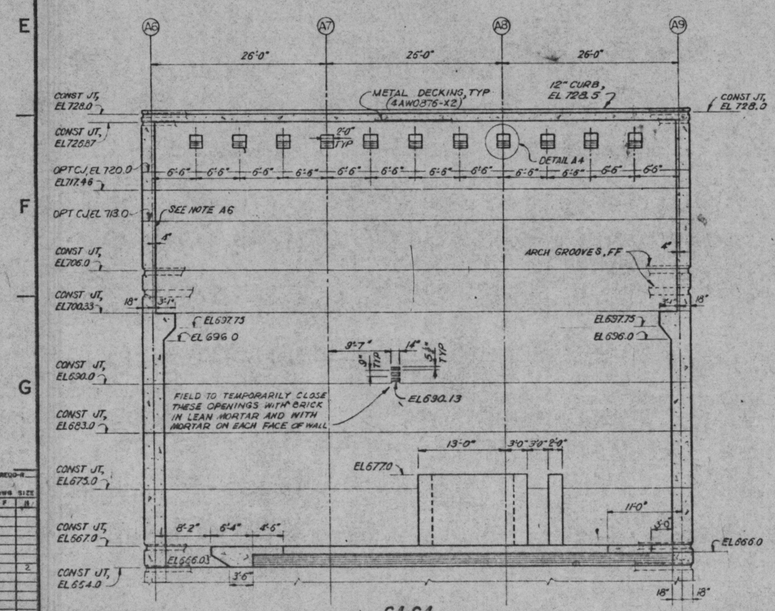

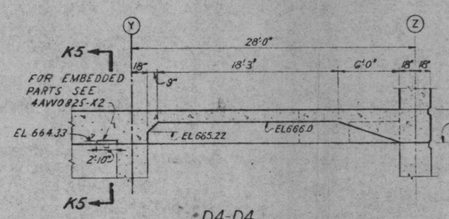

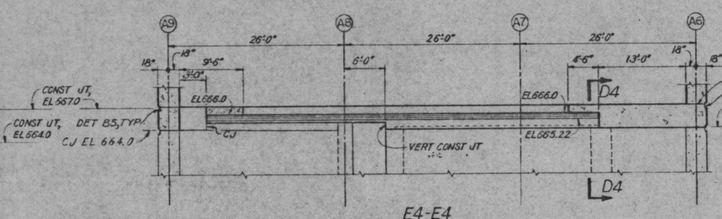

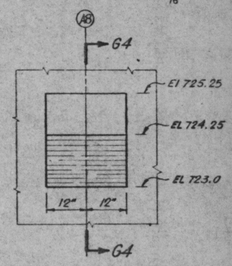

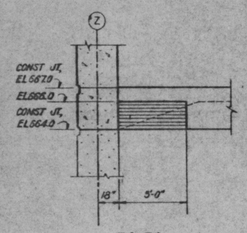

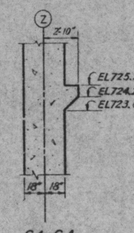

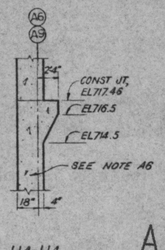

PRC APERTURE CARD

Docket # 50-438/439
Control # 8209010344
Date 8/25/82 of Document
REGULATORY DOCKET FILE

SCALE ⅛"=1'-0" EXCEPT AS NOTED.
COMPANION DRAWINGS: 4AW0362-XI-1 THRU 3,4,5,6

NOTES:
1. FOR LIST OF NOTES AND REFERENCE DRAWINGS SEE 4AW0362-XI-1.

REV NO.	ECN NO.	DATE	DRAWN	DESIGN	CHKD	SUPV	CHIEF	INSP	SUPRV	ECN	APPR
8	903	3-23-82									
CORE DRILLED HOLES IN SECTIONS A4-A4 & B4-B4											
7	SI	4-21-79									
REV A4-A4 & B4-B4 PER FCR 0-1792											
6	SI	3-21-79									
REV SECT A4-A4 & B4-B4 PER FCR 0-1454											
5	SI	10-9-78									
REV OUTLINE EL. IN A4-A4, B4-B4 & C4-C4; FCR 0-1393 & 0-1311											
4	SI	6-21-78									
REVISED CONST JT SECT A4-A4 & B4-B4											
3	SI	3-13-77									
MINOR REVISION, REVISED SLAB EL EV & SECTION B4-B4											
2	SI	12-5-77									
ADD OPNG IN C4-C4 & REV DIM IN D4-D4.											
1	SI	8-11-77									
REV CJ SECT A4, B4, C4 & H4; REV SLOPE SECT B4 & A4											

DRAWN C.K. HOUSEWRIGHT
DESIGN P.U. CHAU
CHIEF R.E. SHEPARD FOR C.K. HOUSEWRIGHT
SUPV P.M. HABBLER
INSP
ENGINEER Earl E. Cole

AUXILIARY BUILDING STAGE II
UNITS 1 & 2

CONCRETE
SLABS WALLS AND ROOF ABOVE EL 664.0
OUTLINE

BELLEFONTE NUCLEAR PLANT
TENNESSEE VALLEY AUTHORITY
DIVISION OF ENGINEERING DESIGN

SUBMITTED Earl E. Cole | RECOMMENDED C.A. Burpee | APPROVED R.M. Hollow

KNOXVILLE 3-22-77 | 88 | C | 4AW0362-XI-4 | R8

RECORD DRAWING AS CONSTRUCTED

8209010344