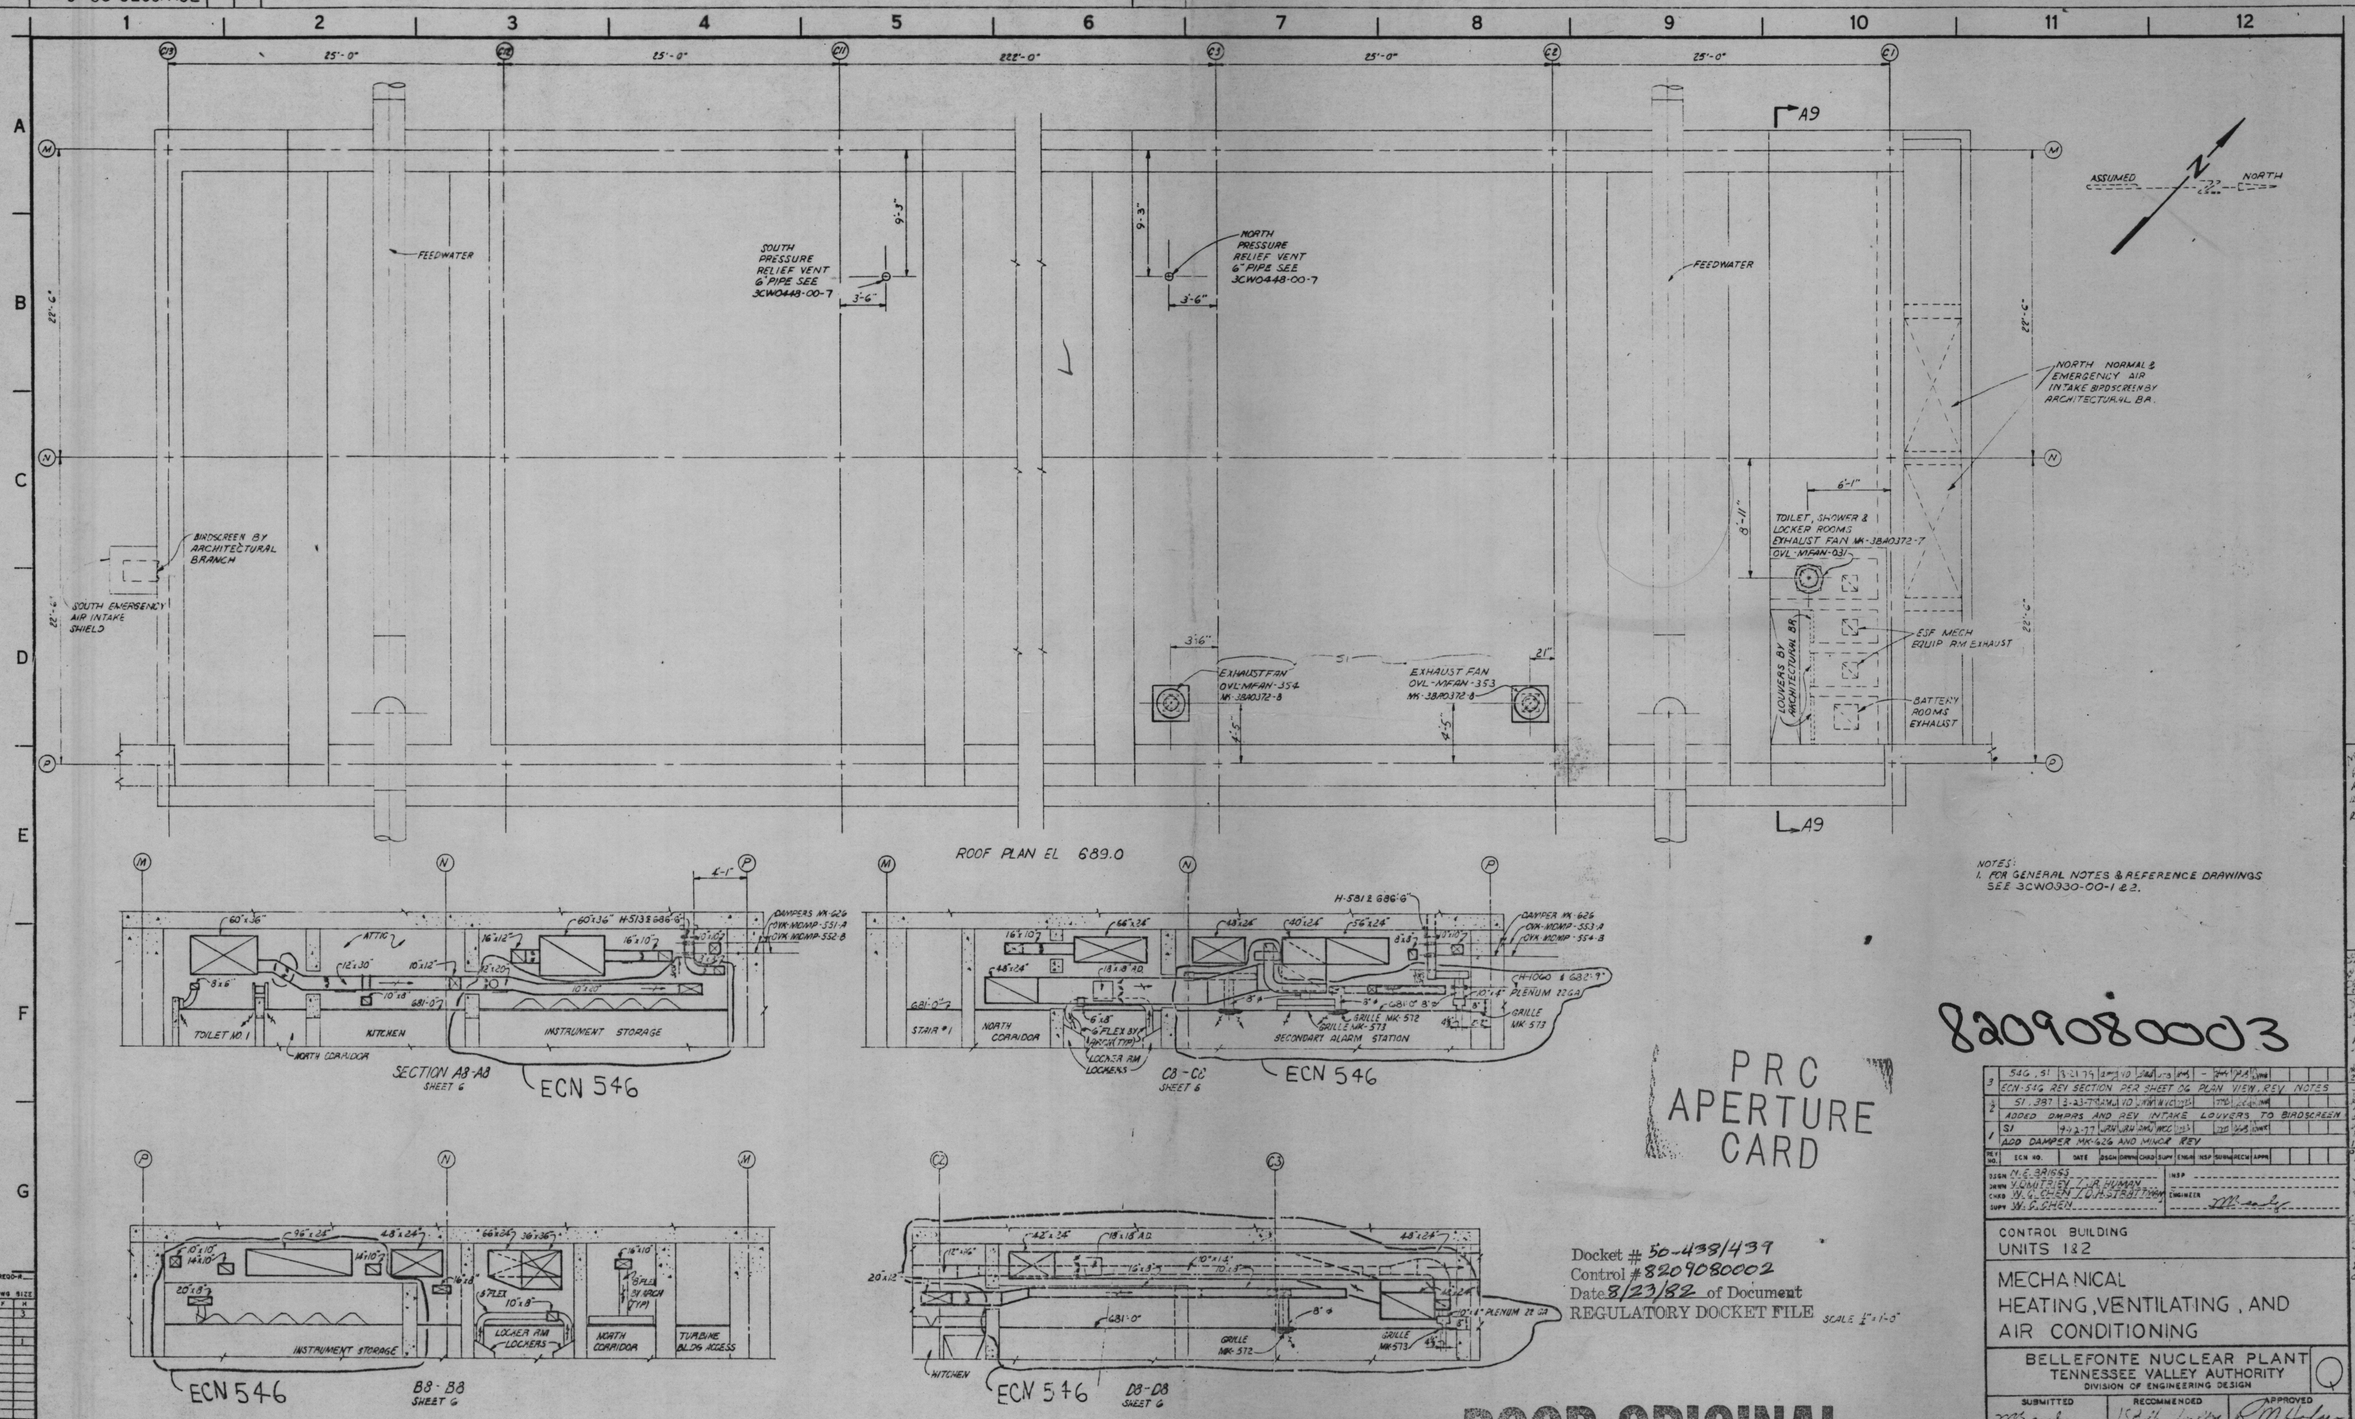

NOTES:
1. FOR GENERAL NOTES & REFERENCE DRAWINGS SEE 3CW0930-00-1 & 2.

8209080003

PRC APERTURE CARD

Docket # 50-438/439
Control # 8209080002
Date 8/23/82 of Document
REGULATORY DOCKET FILE

SCALE 1/4" = 1'-0"

REV NO.	ECN NO.	DATE	DSGN	DRWN	CHKD	SUPV	ENGR	INSP	SUBM	RECM	APPR
3	546, S1	3-21-79	[illegible]	[illegible]	[illegible]	[illegible]	-	[illegible]	[illegible]	[illegible]	
	ECN-546 REV SECTION PER SHEET 06 PLAN VIEW, REV NOTES										
2	S1, 387	3-23-78	[illegible]	[illegible]	[illegible]	[illegible]		[illegible]	[illegible]	[illegible]	
	ADDED DMPRS AND REV INTAKE LOUVERS TO BIRDSCREEN										
1	S1	9-12-77	[illegible]	[illegible]	[illegible]	[illegible]		[illegible]	[illegible]	[illegible]	
	ADD DAMPER MK-626 AND MINOR REV										

DSGN N.E. BRIGGS
DRWN Y. DMITRIEV / J.R. HUMAN
CHKD W. C. CHEN / D.H. STRATTMAN
SUPV W. C. CHEN
INSP
ENGINEER

CONTROL BUILDING
UNITS 1&2

MECHANICAL
HEATING, VENTILATING, AND
AIR CONDITIONING

BELLEFONTE NUCLEAR PLANT
TENNESSEE VALLEY AUTHORITY
DIVISION OF ENGINEERING DESIGN

SUBMITTED	RECOMMENDED	APPROVED
[signature]	[signature]	[signature]

KNOXVILLE 6-10-76 | 88 | M | 3CW0930-00-08 R3

RECORD DRAWING AS CONSTRUCTED

POOR ORIGINAL