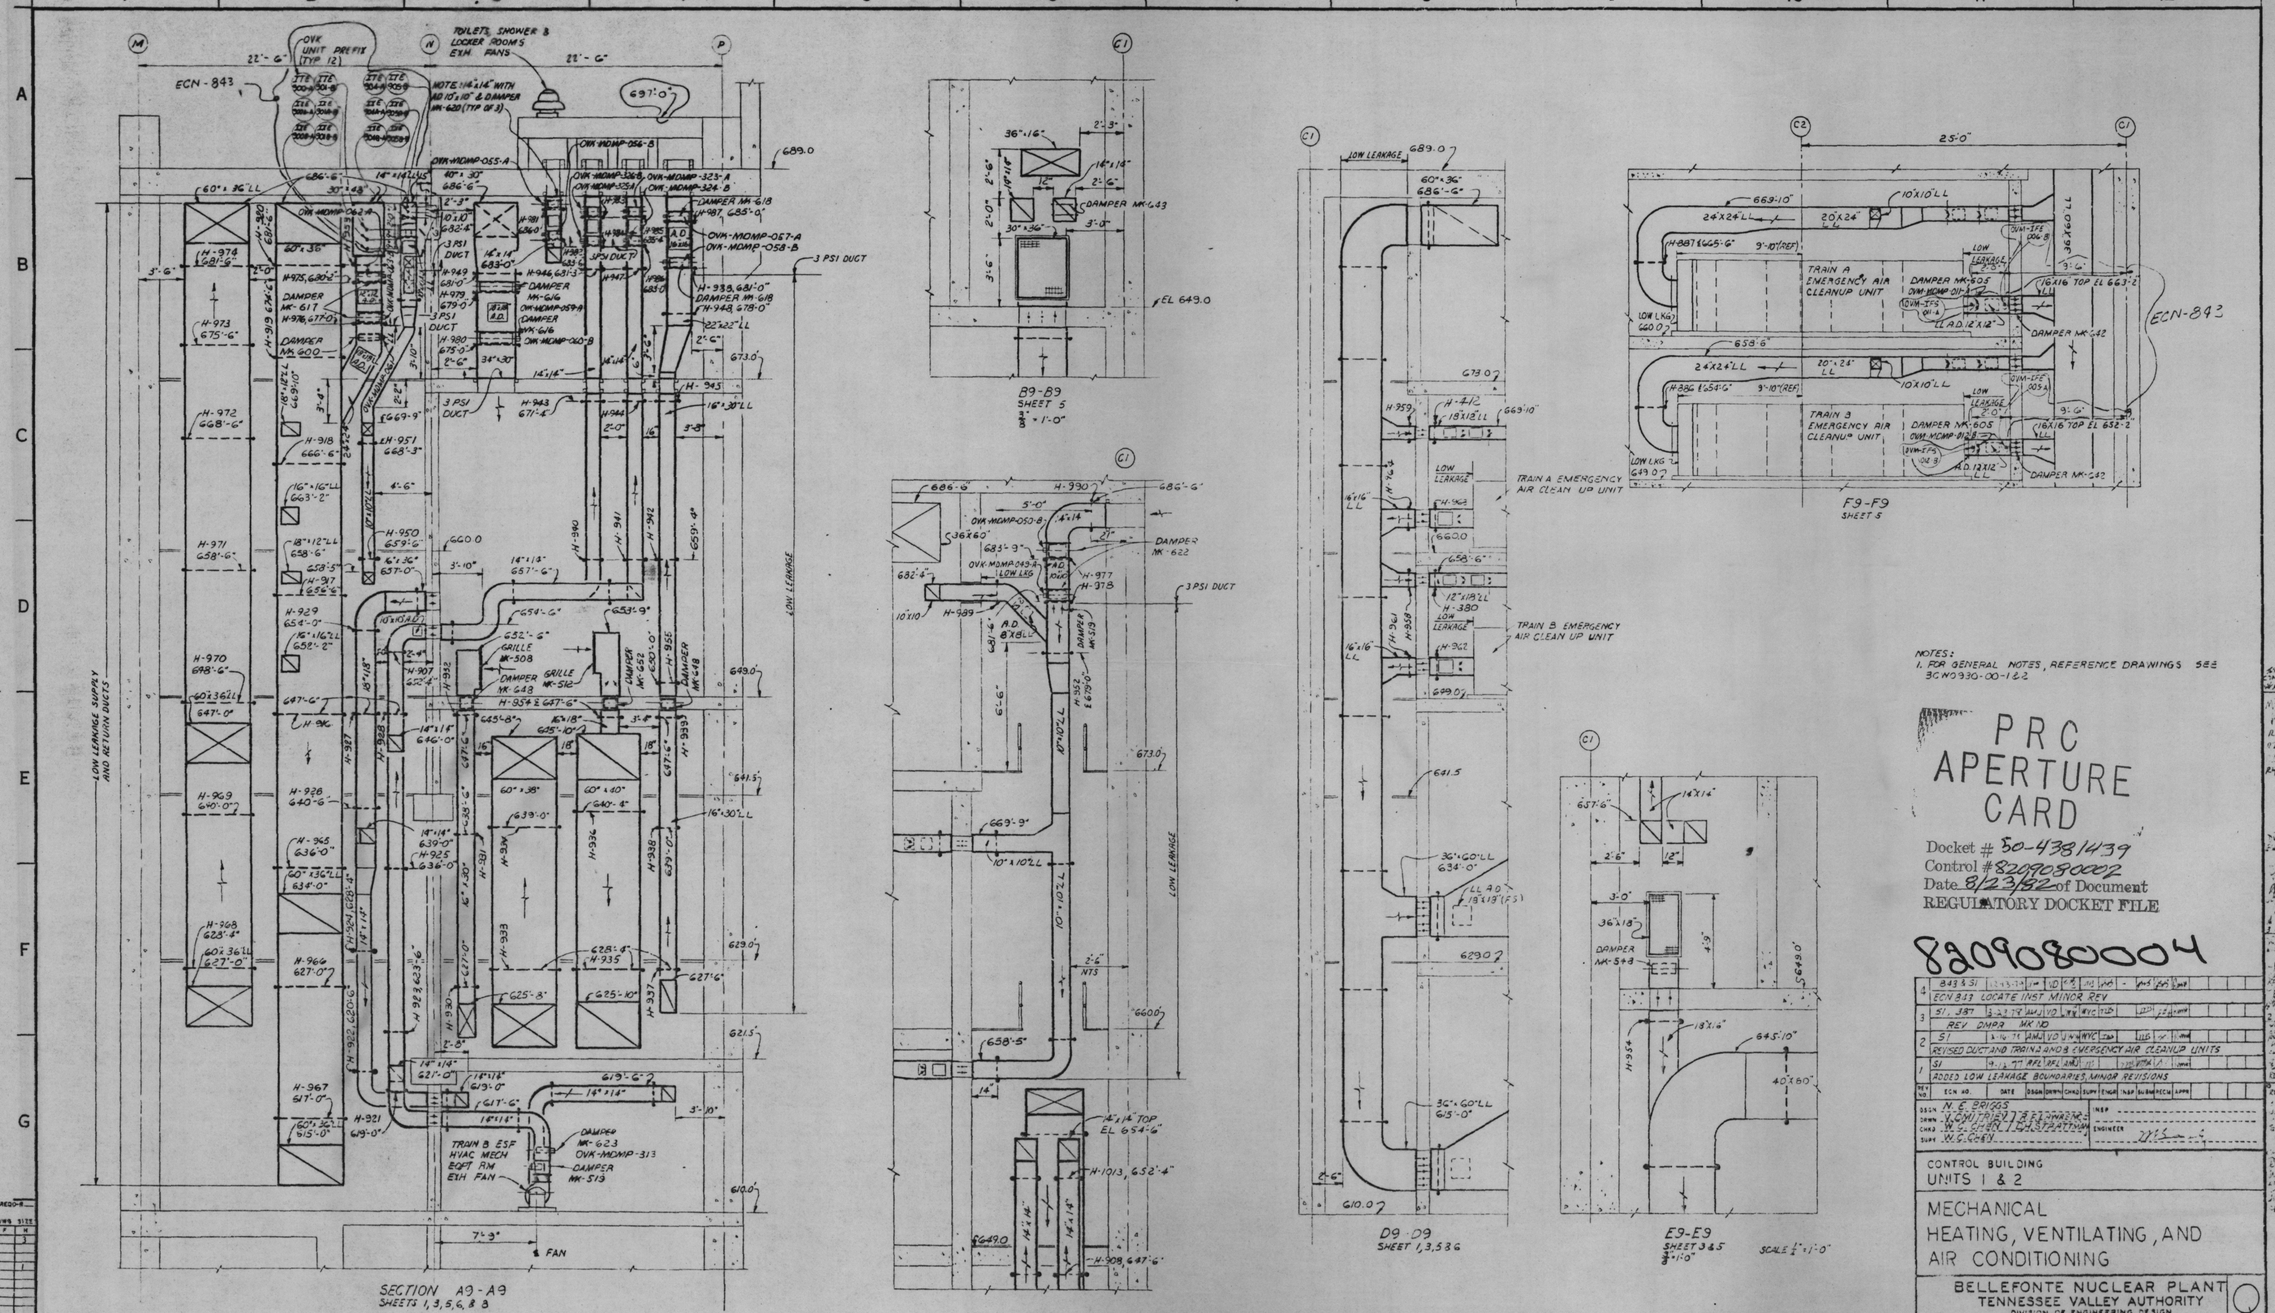

NOTES:
1. FOR GENERAL NOTES, REFERENCE DRAWINGS SEE 3CW0930-00-1&2

PRC APERTURE CARD

Docket # 50-4381439
Control # 8209080002
Date 8/23/82 of Document
REGULATORY DOCKET FILE

8209080004

REV NO.	ECN NO.	DATE	DSGN	DRWN	CHKD	SUPV	ENGR	INSP	SUBM	RECM	APPR
4	843 & S1	[illegible]	[illegible]	[illegible]	[illegible]	[illegible]	[illegible]	-	[illegible]	[illegible]	[illegible]
	ECN 843 LOCATE INST MINOR REV										
3	S1, 387	3-22-78	AMJ	VD	JWW	WVC	TLD		[illegible]	[illegible]	[illegible]
	REV DMPR MK NO										
2	S1	2-16-78	AMJ	VD	JWW	WVC	TLD		[illegible]	[illegible]	[illegible]
	REVISED DUCT AND TRAIN A AND B EMERGENCY AIR CLEANUP UNITS										
1	S1	9-12-77	RFL	RFL	AMJ	[illegible]	[illegible]	[illegible]	[illegible]	[illegible]	[illegible]
	ADDED LOW LEAKAGE BOUNDARIES, MINOR REVISIONS										

DSGN N. E. BRIGGS
DRWN V. CMITRIEV / B. ELDWARDS
CHKD W. C. CHEN / C. H. STRATTMAN
SUPV W. C. CHEN
INSP
ENGINEER

CONTROL BUILDING
UNITS 1 & 2

MECHANICAL
HEATING, VENTILATING, AND
AIR CONDITIONING

BELLEFONTE NUCLEAR PLANT
TENNESSEE VALLEY AUTHORITY
DIVISION OF ENGINEERING DESIGN

SUBMITTED	RECOMMENDED	APPROVED
[illegible]	[illegible]	[illegible]

KNOXVILLE 6-10-76 | 88 | M | 3CW0930-00-09 R&

RECORD DRAWING AS CONSTRUCTED

POOR ORIGINAL