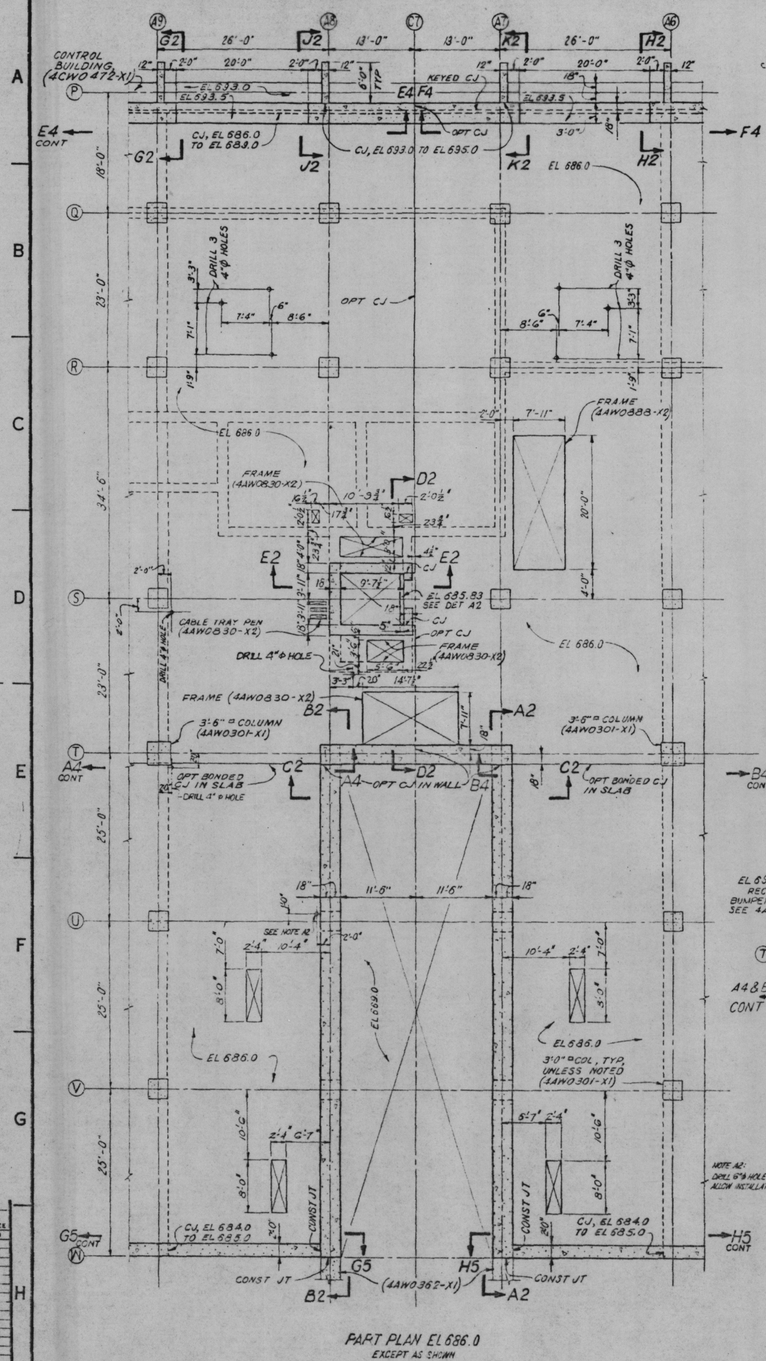

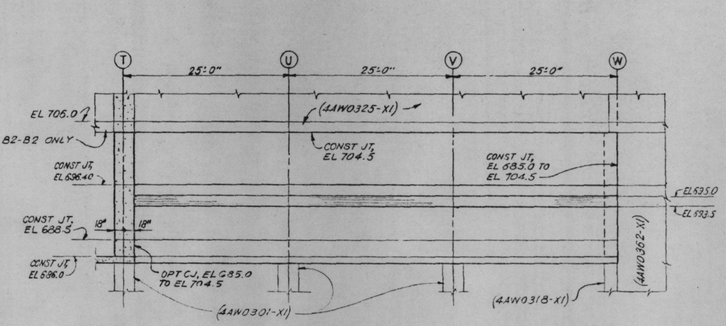

A2-A2 & B2-B2

A2-A2 AS SHOWN
B2-B2 OPP HAND & A3 NOTED

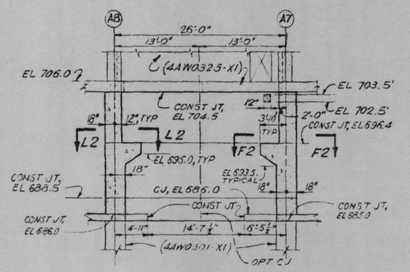

C2-C2

NOTE
1. FOR NOTES, SEE 4AWO322-XI-1

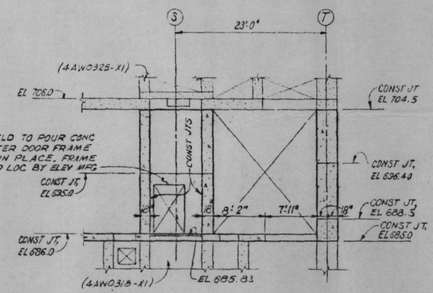

D2-D2

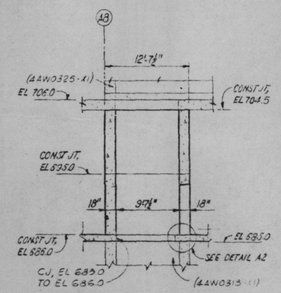

E2-E2

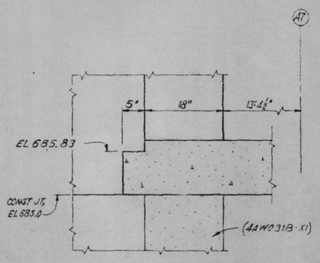

DETAIL A2
SCALE: 1"=1'-0"

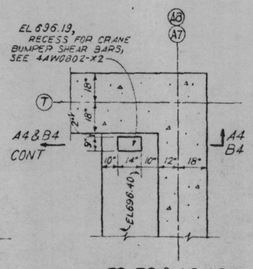

F2-F2 & L2-L2

F2-F2 AS SHOWN
L2-L2 OPP HAND
SCALE ⅜"=1'-0"

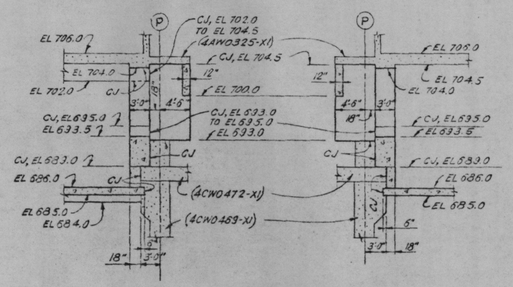

G2-G2 & H2-H2

G2-G2 AS SHOWN
H2-H2 OPP HAND

J2-J2 & K2-K2

J2-J2 AS SHOWN
K2-K2 OPP HAND

REV	BY	DATE	DESCRIPTION
8	SI	6-3-77	REVISED PART PLAN EL 686.0 PER FCR 0-2297 & 0-2212 & 0-2+13
7	SI	6-1-77	REVISED PART PLAN EL 686.0 PER FCR 0-2303, SEE NOTE A2
REV PART PLAN EL 686.0 PER FCR 0-1979			
5	SI	4-30-77	REVISED PART PLAN EL 686.0 PER FCR 0-1979
ADDED DRILL HOLES IN PART PLAN EL 686.0			
4	SI	3-31-77	ADDED OPT CJ IN SLAB PER FCR 0-336
3	SI	3-21-77	REV SEC C2-C2, TO ADD HVAC OPNGS & FCR 0-675
2	SI	3-11-77	MINOR REVISIONS, ADDED HVAC OPNGS IN SLAB.
1	SI	1-27-77	REMOVED HOLD ON SECTION F2-F2

DSGN KK KIM
DRWN EE SHIBLY
CHKD CJ MERRICK/MM COMPLEX
SUPV S.W. VANCE

INSP
ENGINEER Bish & Cole

AUXILIARY BUILDING
UNITS 1 & 2

CONCRETE
FL SLAB EL 686.0 & WALLS TO EL 704.5
OUTLINE

BELLEFONTE NUCLEAR PLANT
TENNESSEE VALLEY AUTHORITY
DIVISION OF ENGINEERING DESIGN

SUBMITTED	RECOMMENDED	APPROVED
Bish & Cole	[illegible]	[illegible]

KNOXVILLE 1-10-77 | BB | C | 4AWO322-XI-2 Rev

RECORD DRAWING AS CONSTRUCTED

PRC APERTURE CARD

Docket # 50-438/439
Control # ~~82090080~~ 8209080077
Date 9/23/82 of Document
REGULATORY DOCKET FILE

SCALE ⅜"=1'-0"; EXCEPT AS NOTED.
COMPANION DRAWINGS:
4AWO322-XI-1, 3, 4, & 5

POOR ORIGINAL

8209080077