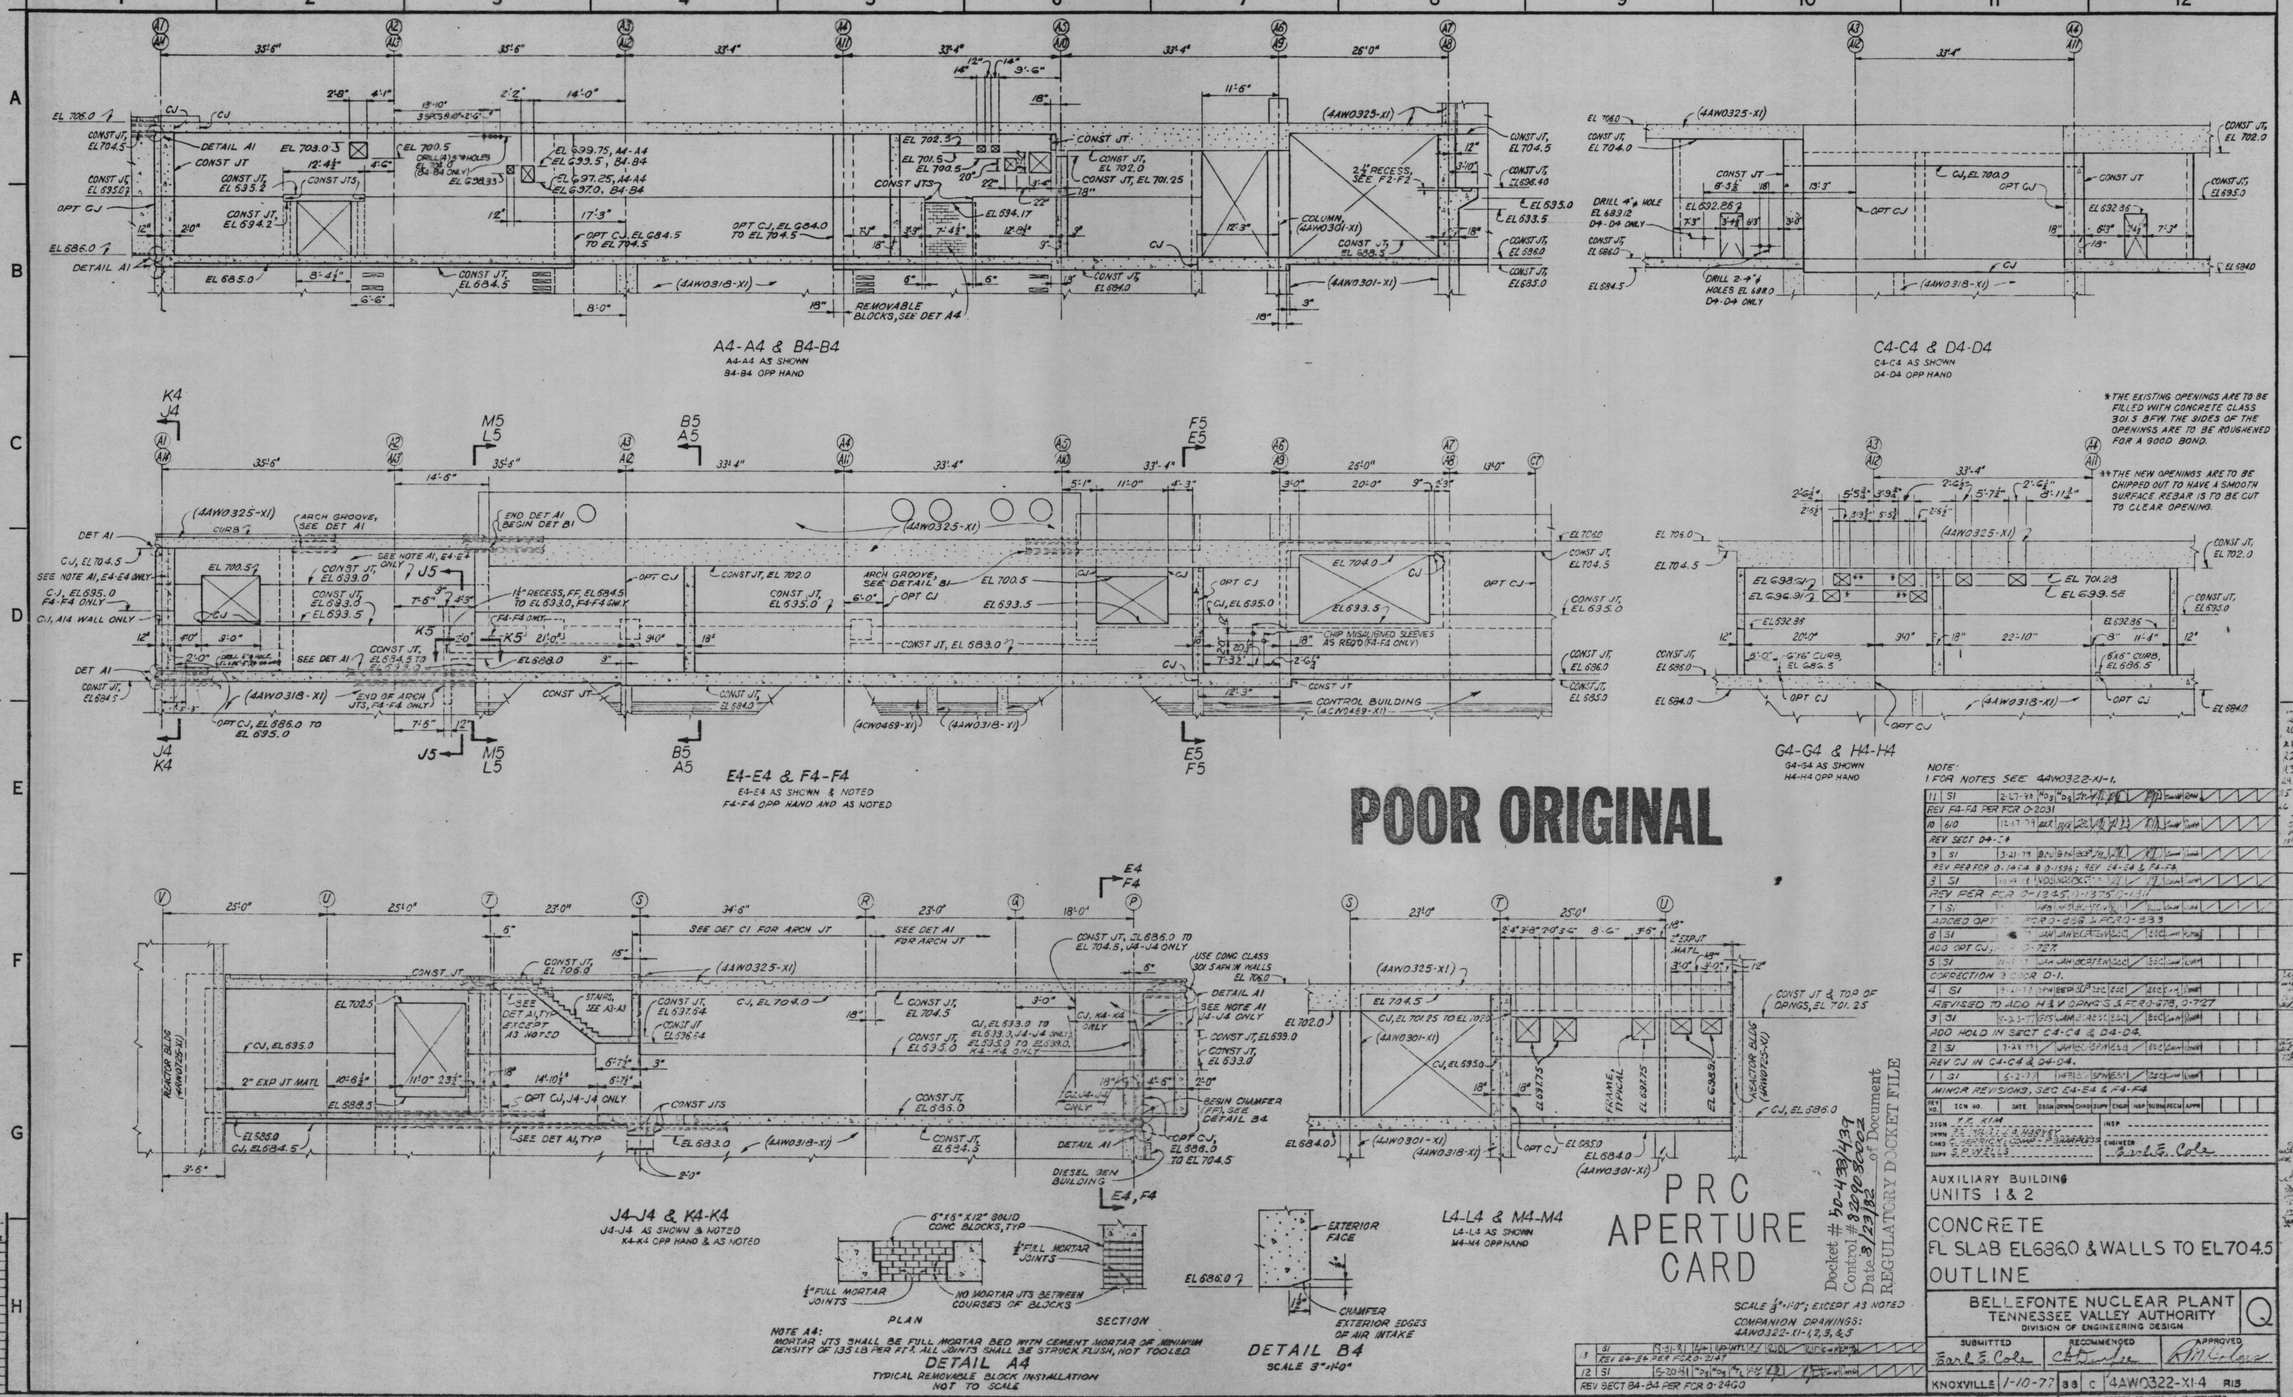
A4-A4 & B4-B4
A4-A4 AS SHOWN
B4-B4 OPP HAND
C4-C4 & D4-D4
C4-C4 AS SHOWN
D4-D4 OPP HAND
E4-E4 & F4-F4
E4-E4 AS SHOWN & NOTED
F4-F4 OPP HAND AND AS NOTED
G4-G4 & H4-H4
G4-G4 AS SHOWN
H4-H4 OPP HAND
J4-J4 & K4-K4
J4-J4 AS SHOWN & NOTED
K4-K4 OPP HAND & AS NOTED
L4-L4 & M4-M4
L4-L4 AS SHOWN
M4-M4 OPP HAND
DETAIL A4
TYPICAL REMOVABLE BLOCK INSTALLATION
NOT TO SCALE
PLAN
SECTION
DETAIL B4
SCALE 3"=1'-0"
REMOVABLE BLOCKS, SEE DET A4
CONTROL BUILDING
DIESEL GEN BUILDING
REACTOR BLDG
NOTE:
1 FOR NOTES SEE 4AW0322-XI-1.
AUXILIARY BUILDING
UNITS 1 & 2
CONCRETE
FL SLAB EL686.0 & WALLS TO EL704.5
OUTLINE
BELLEFONTE NUCLEAR PLANT
TENNESSEE VALLEY AUTHORITY
DIVISION OF ENGINEERING DESIGN
KNOXVILLE 1-10-77
4AW0322-XI-4
RECORD DRAWING AS CONSTRUCTED
POOR ORIGINAL
PRC APERTURE CARD
Docket # 50-439/439
Control # 8209080014
Date 3/23/82
of Document
REGULATORY DOCKET FILE
8209080014