


○ B/M ITEM NO
 ⊗ OUTGOING TERMINAL

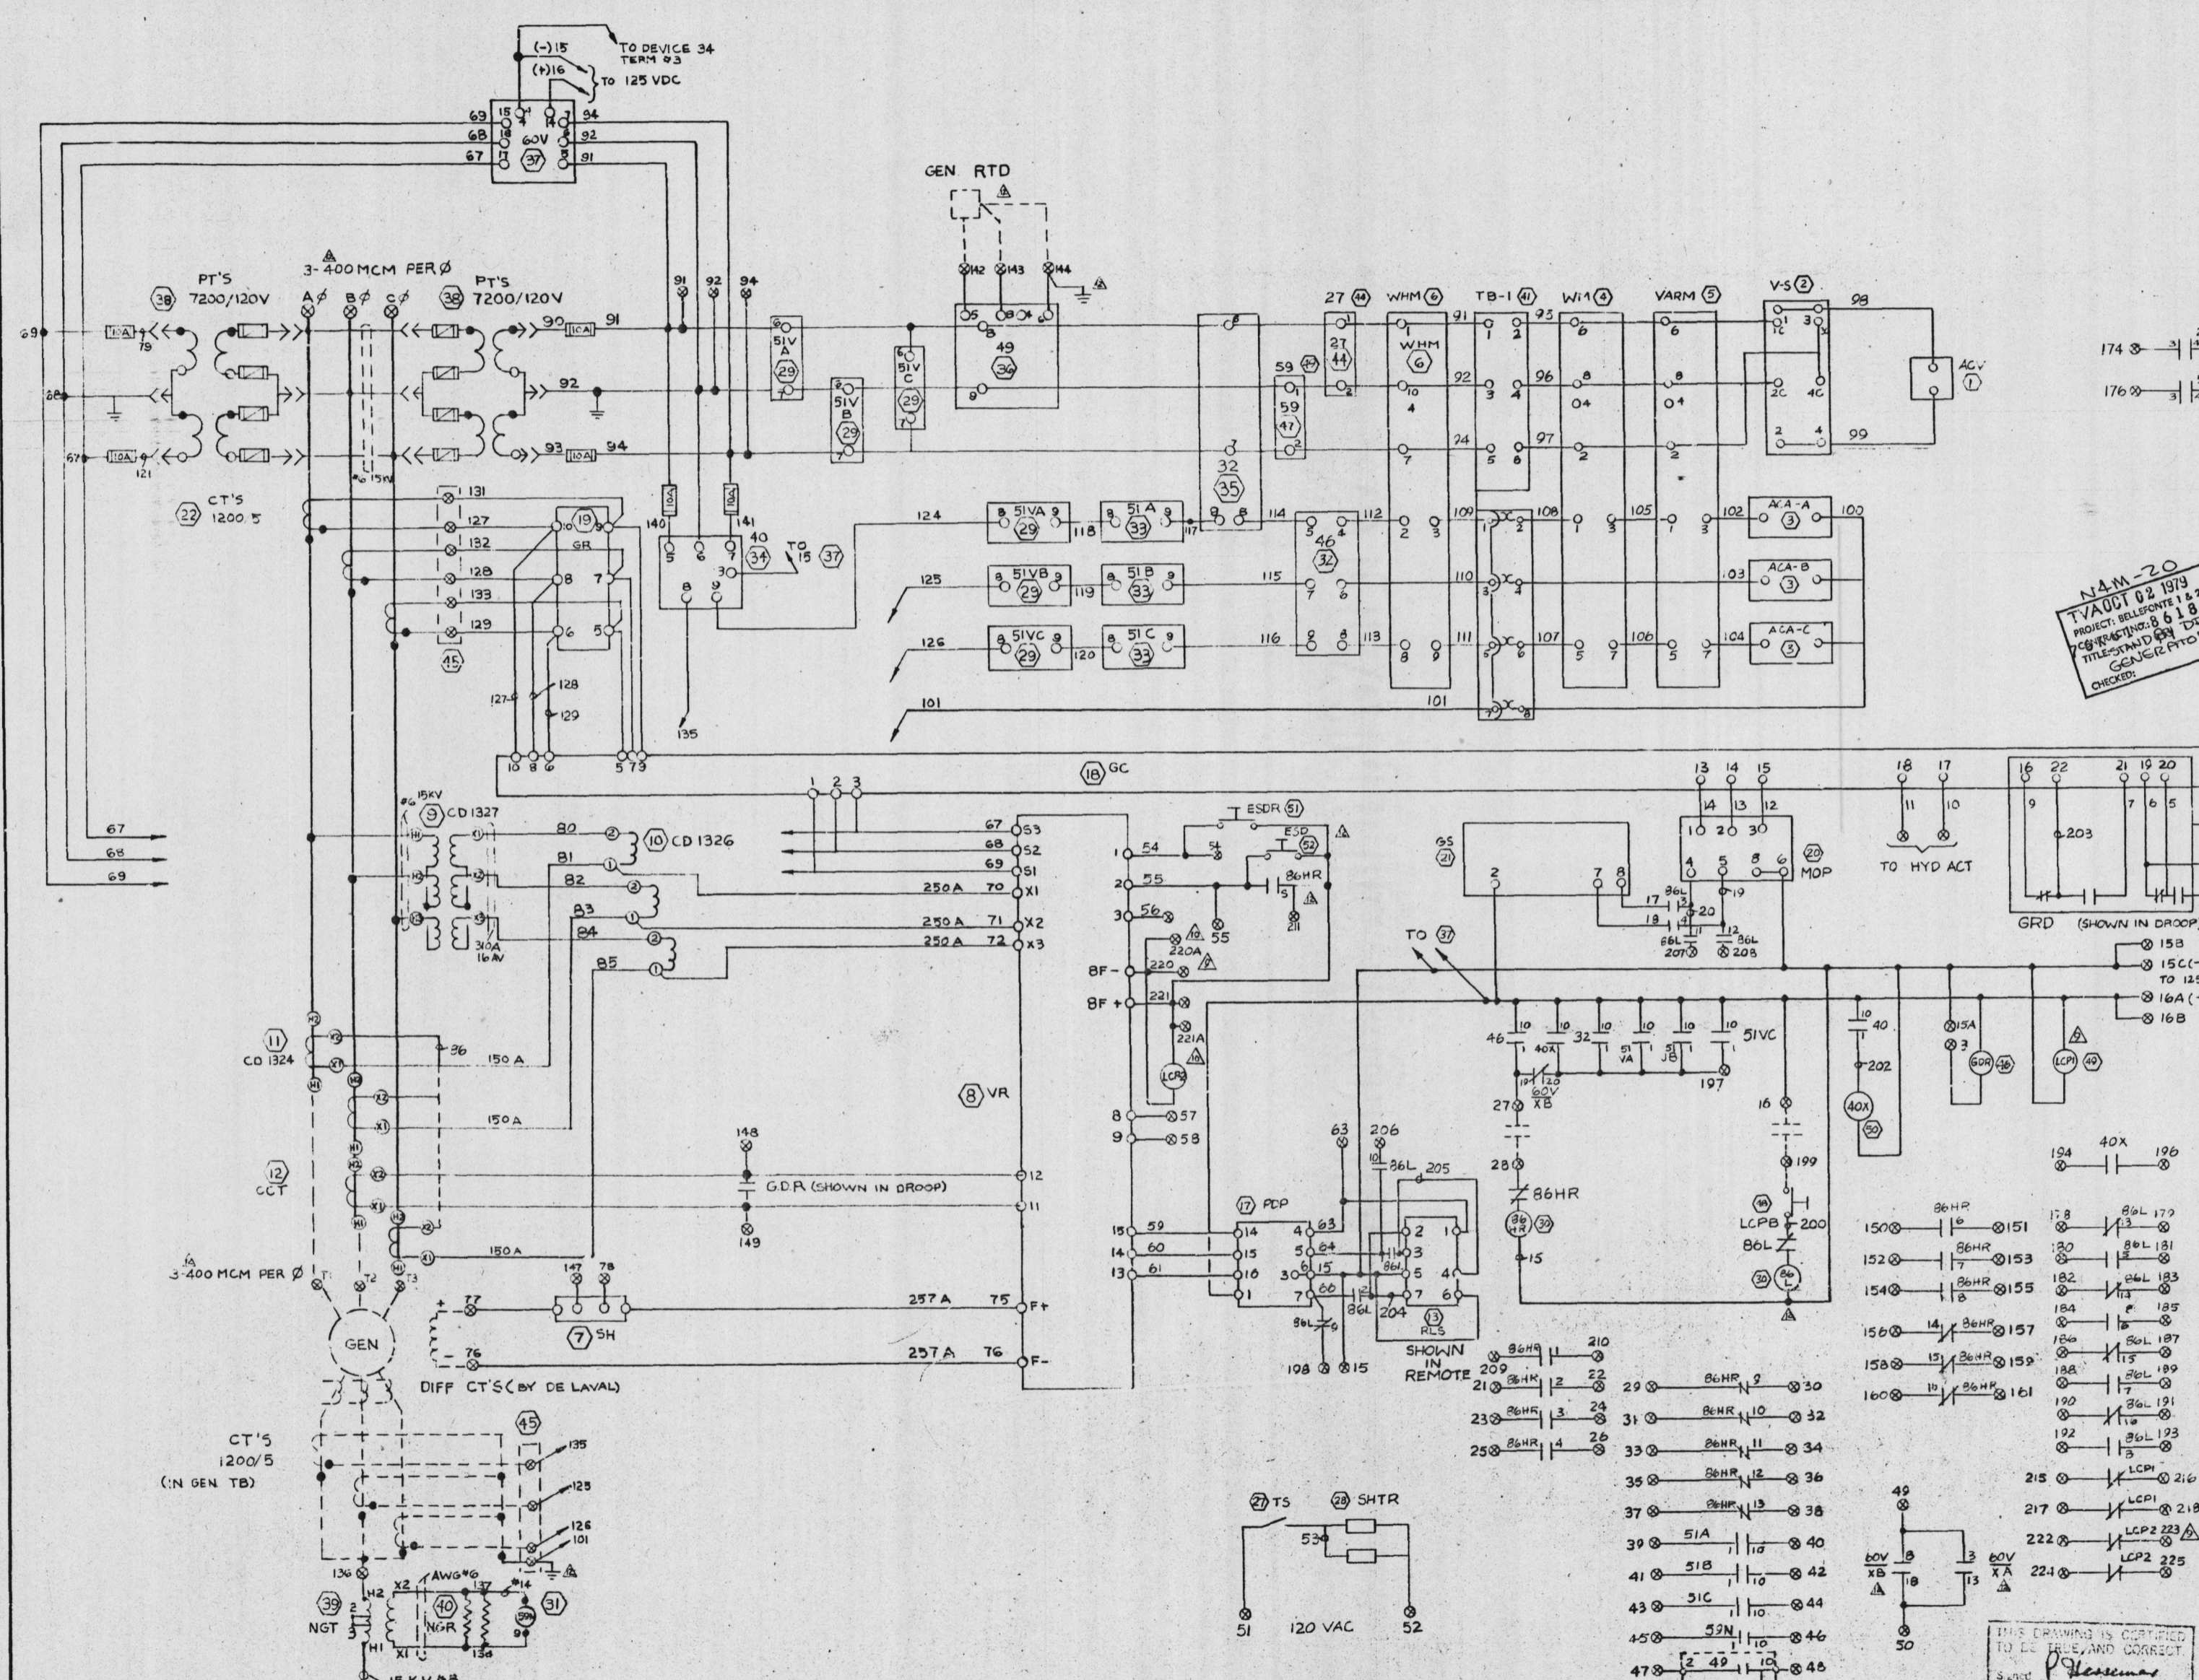

N.A.M.-20
 PROJECT: BELLEFONTE 1 & 2
 CONTRACT NO. 66181
 GEN. CONTROL PANEL
 CHECKED

APPROVED
 This approval does not relieve
 the Contractor from any part of his
 responsibility for the correctness
 of design, details, and dimensions
 TENSILE
 DATE: OCT 20 1978
 (BY: [Signature])

APERTURE CARD

TENNESSEE VALLEY AUTHORITY
 CONTRACT NO. 7581-86181
 BELLEFONTE UNITS 1 & 2

NO.	REVISIONS	BY	DATE
12	PER CUST. REVISED PRINT	K.F.	3-10-77
11	REDRAWN	A.W.	10-25-77
10	AS BUILT	J.E.	3-2-78
9	PER CUST. REVISED PRINT	M.E.	1-26-78
8	CHANGE PER MARKED ON DWG DTD 11-23-77	M.E.	12-21-77
7	PER CUST. LETTER DTD 11-08-77	H.S.	11-15-77
6	PER CUST. REVISED PRINT	CTH	7-22-77
5	AS BUILT	CTH	5-27-77
4	REV. MOP TB ADDED LCP	DAS	3-3-77
3	PER CUST. REVISED PRINT	CTH	1-23-77
2	MISC. REV.	M.H.	1-4-77
1	MISC. REV.	CTH	7-21-76

SCHEMATICS
 DIESEL GENERATOR LOCAL PANELS
 BELLEFONTE NUCLEAR PLANT
 TENNESSEE VALLEY AUTHORITY

ENGINEER: TVA
 CUSTOMER: DE LAVAL
 P.O. NO.: 62566



Post Office Box 1995
 705 N. Carlton
 Telephone 458-2621
 Stockton, California 95201

DRAWN BY: A.G.
 DWG. NO. D54200-2
 SHEET 2 OF 4
 DATE: 9-10-79

Docket # 50-438
 Control # 320208064
 Date 8/22/02 of Document
 REGULATORY DOCKET FILE

THIS DRAWING IS CERTIFIED
 TO BE TRUE AND CORRECT
 Signed: P. Hessemer
 Project Engineer
 Date: 9-10-79