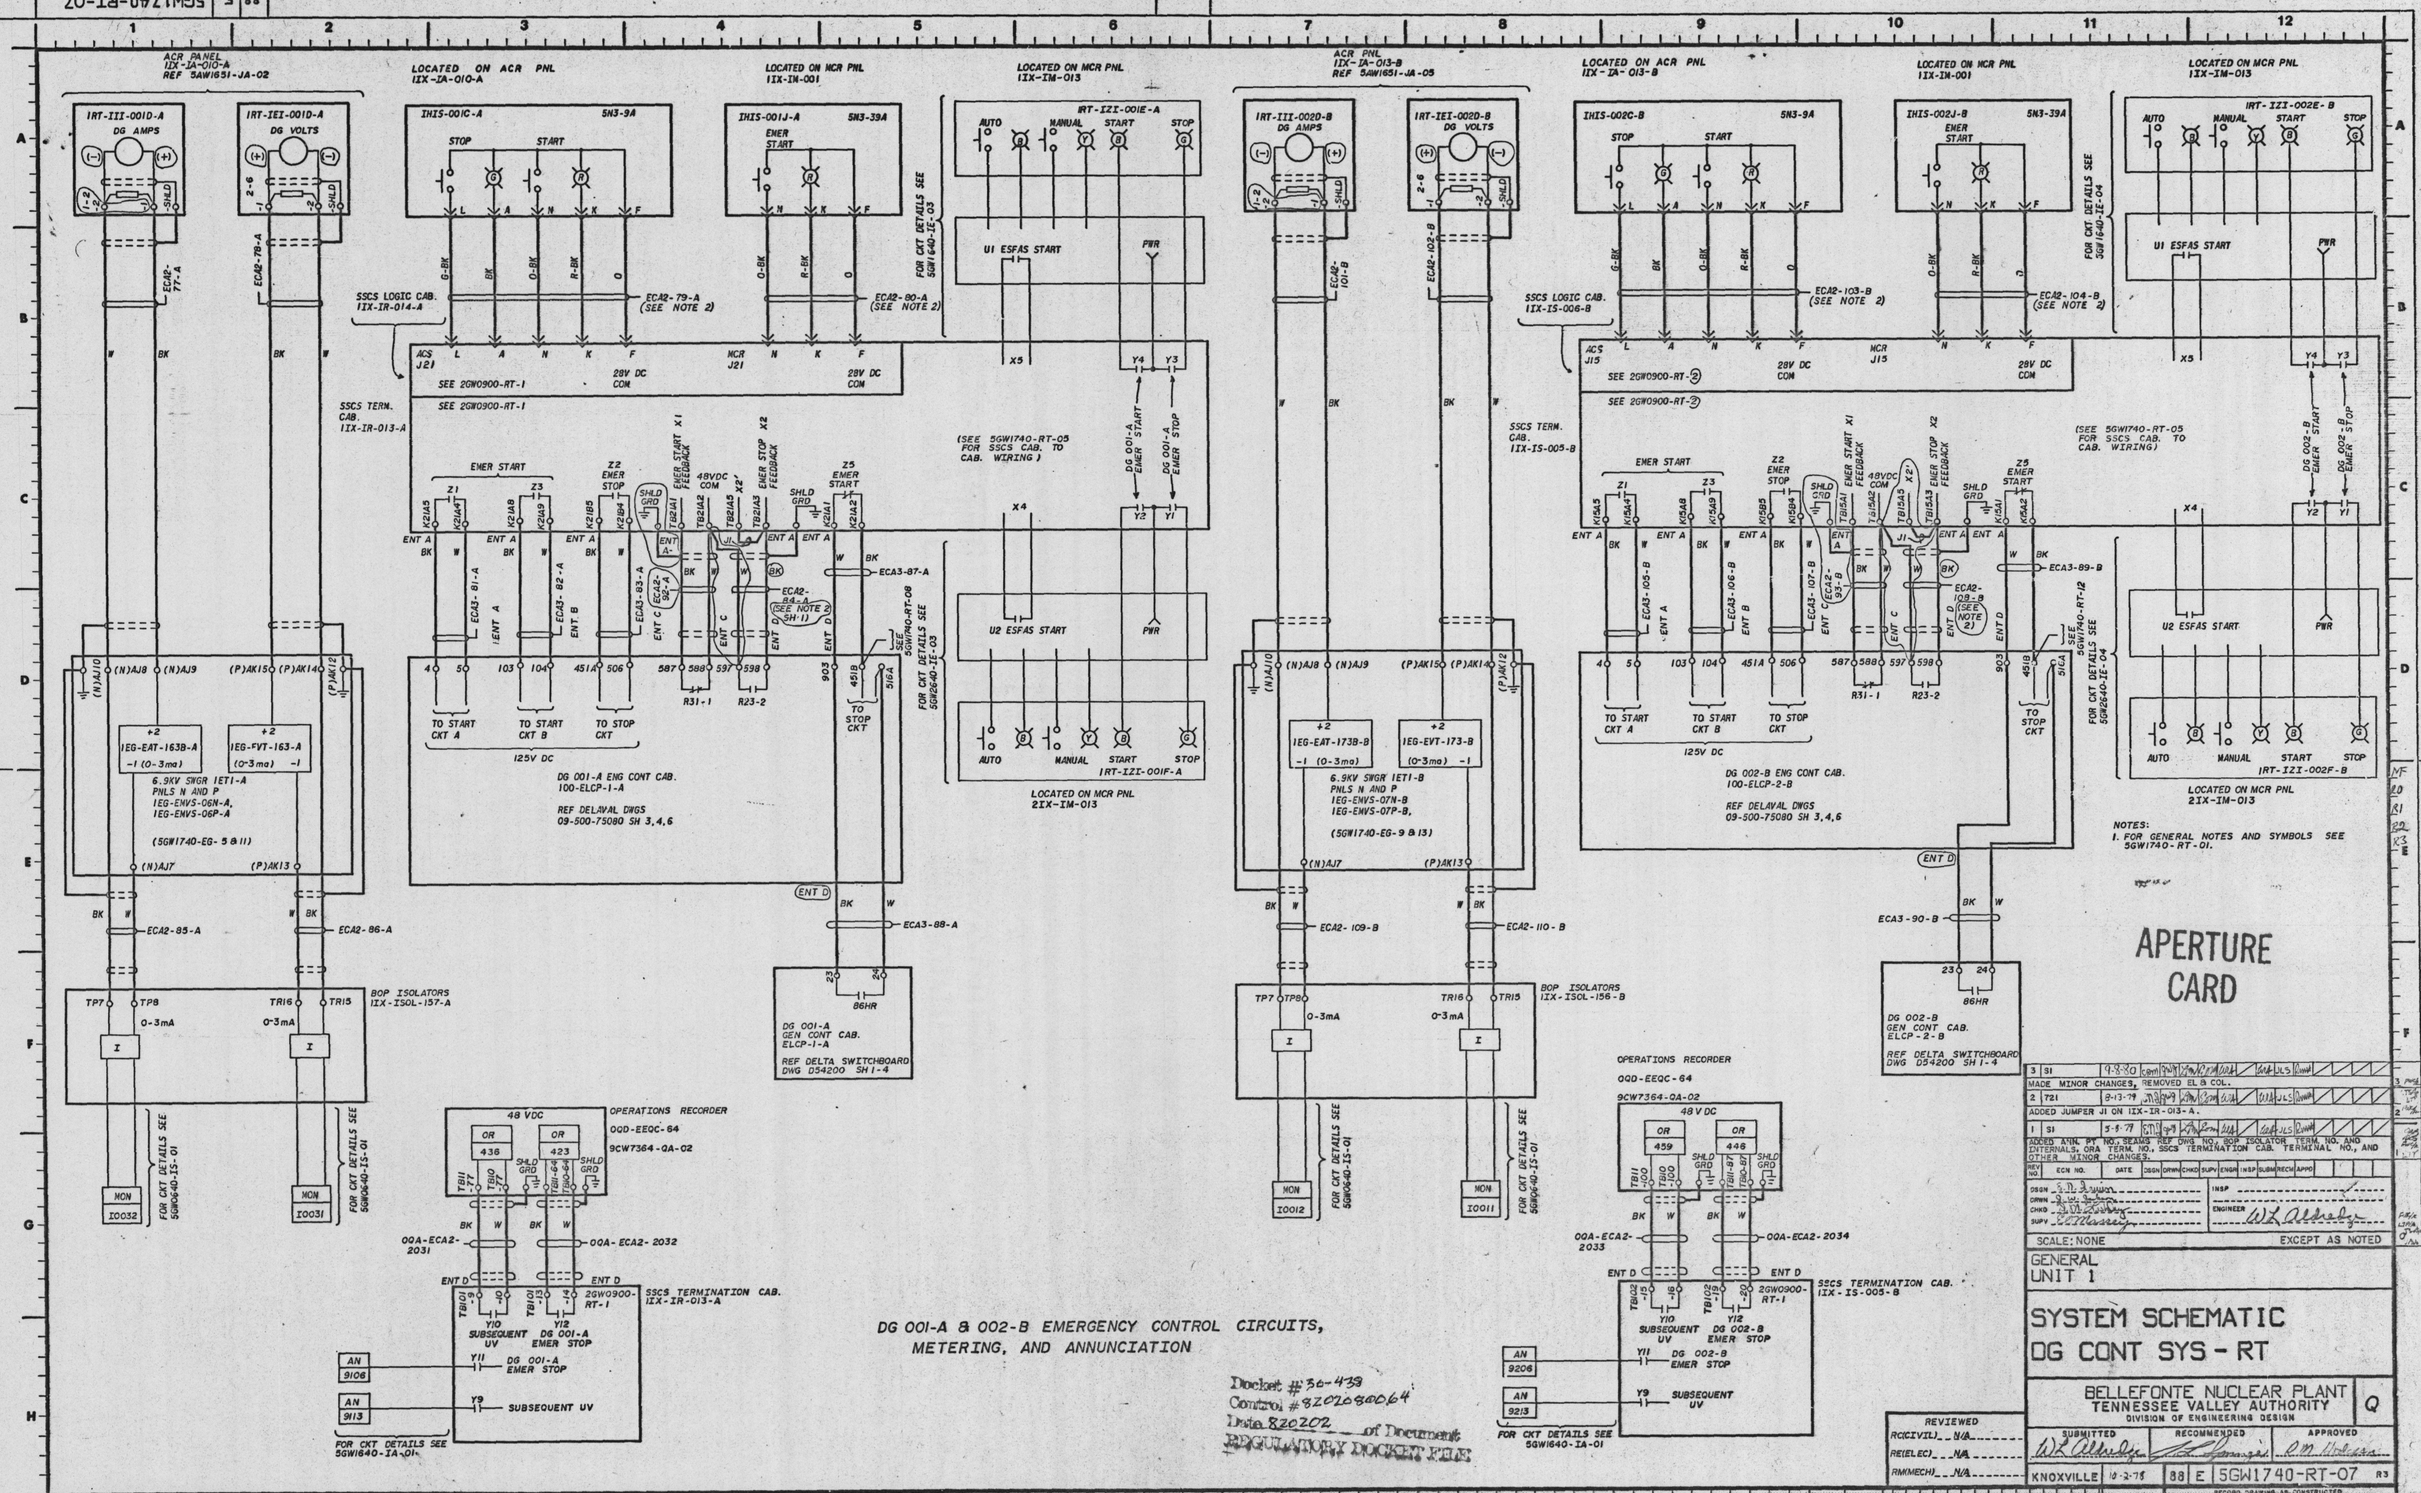

DG 001-A & 002-B EMERGENCY CONTROL CIRCUITS, METERING, AND ANNUNCIATION

NOTES:
1. FOR GENERAL NOTES AND SYMBOLS SEE 5GW1740-RT-01.

APERTURE CARD

REV NO.	ECN NO.	DATE	DSGN	DRWN	CHKD	SUPV	ENGR	INSP	SUBM	RECM	APPD
3	S1	9-8-80	CBM	[illegible]	[illegible]	[illegible]	[illegible]	[illegible]	JLS	[illegible]	
MADE MINOR CHANGES, REMOVED EL & COL.											
2	721	8-13-79	[illegible]	[illegible]	[illegible]	[illegible]	[illegible]	[illegible]	JLS	[illegible]	
ADDED JUMPER J1 ON 1IX-IR-013-A.											
1	S1	5-8-79	[illegible]	[illegible]	[illegible]	[illegible]	[illegible]	[illegible]	JLS	[illegible]	
ADDED ANN. PT NO., SEAMS REF DWG NO., BOP ISOLATOR TERM. NO. AND INTERNALS, ORA TERM. NO., SSCS TERMINATION CAB. TERMINAL NO., AND OTHER MINOR CHANGES.											

DSGN E. M. Irwin
DRWN [illegible]
CHKD [illegible]
SUPV [illegible]
INSP
ENGINEER W. L. Aldredge

SCALE: NONE — EXCEPT AS NOTED

GENERAL
UNIT 1

SYSTEM SCHEMATIC
DG CONT SYS - RT

BELLEFONTE NUCLEAR PLANT
TENNESSEE VALLEY AUTHORITY
DIVISION OF ENGINEERING DESIGN

Q

SUBMITTED	RECOMMENDED	APPROVED
W. L. Aldredge	[illegible]	R. M. Hodgson

REVIEWED
RC(CIVIL) N/A
RE(ELEC) N/A
RM(MECH) N/A

KNOXVILLE 10-2-78 | 88 | E | 5GW1740-RT-07 | R3

RECORD DRAWING AS CONSTRUCTED

Docket # 50-438
Control # 8202080064
Date 820202 of Document
REGULATORY DOCKET FILE