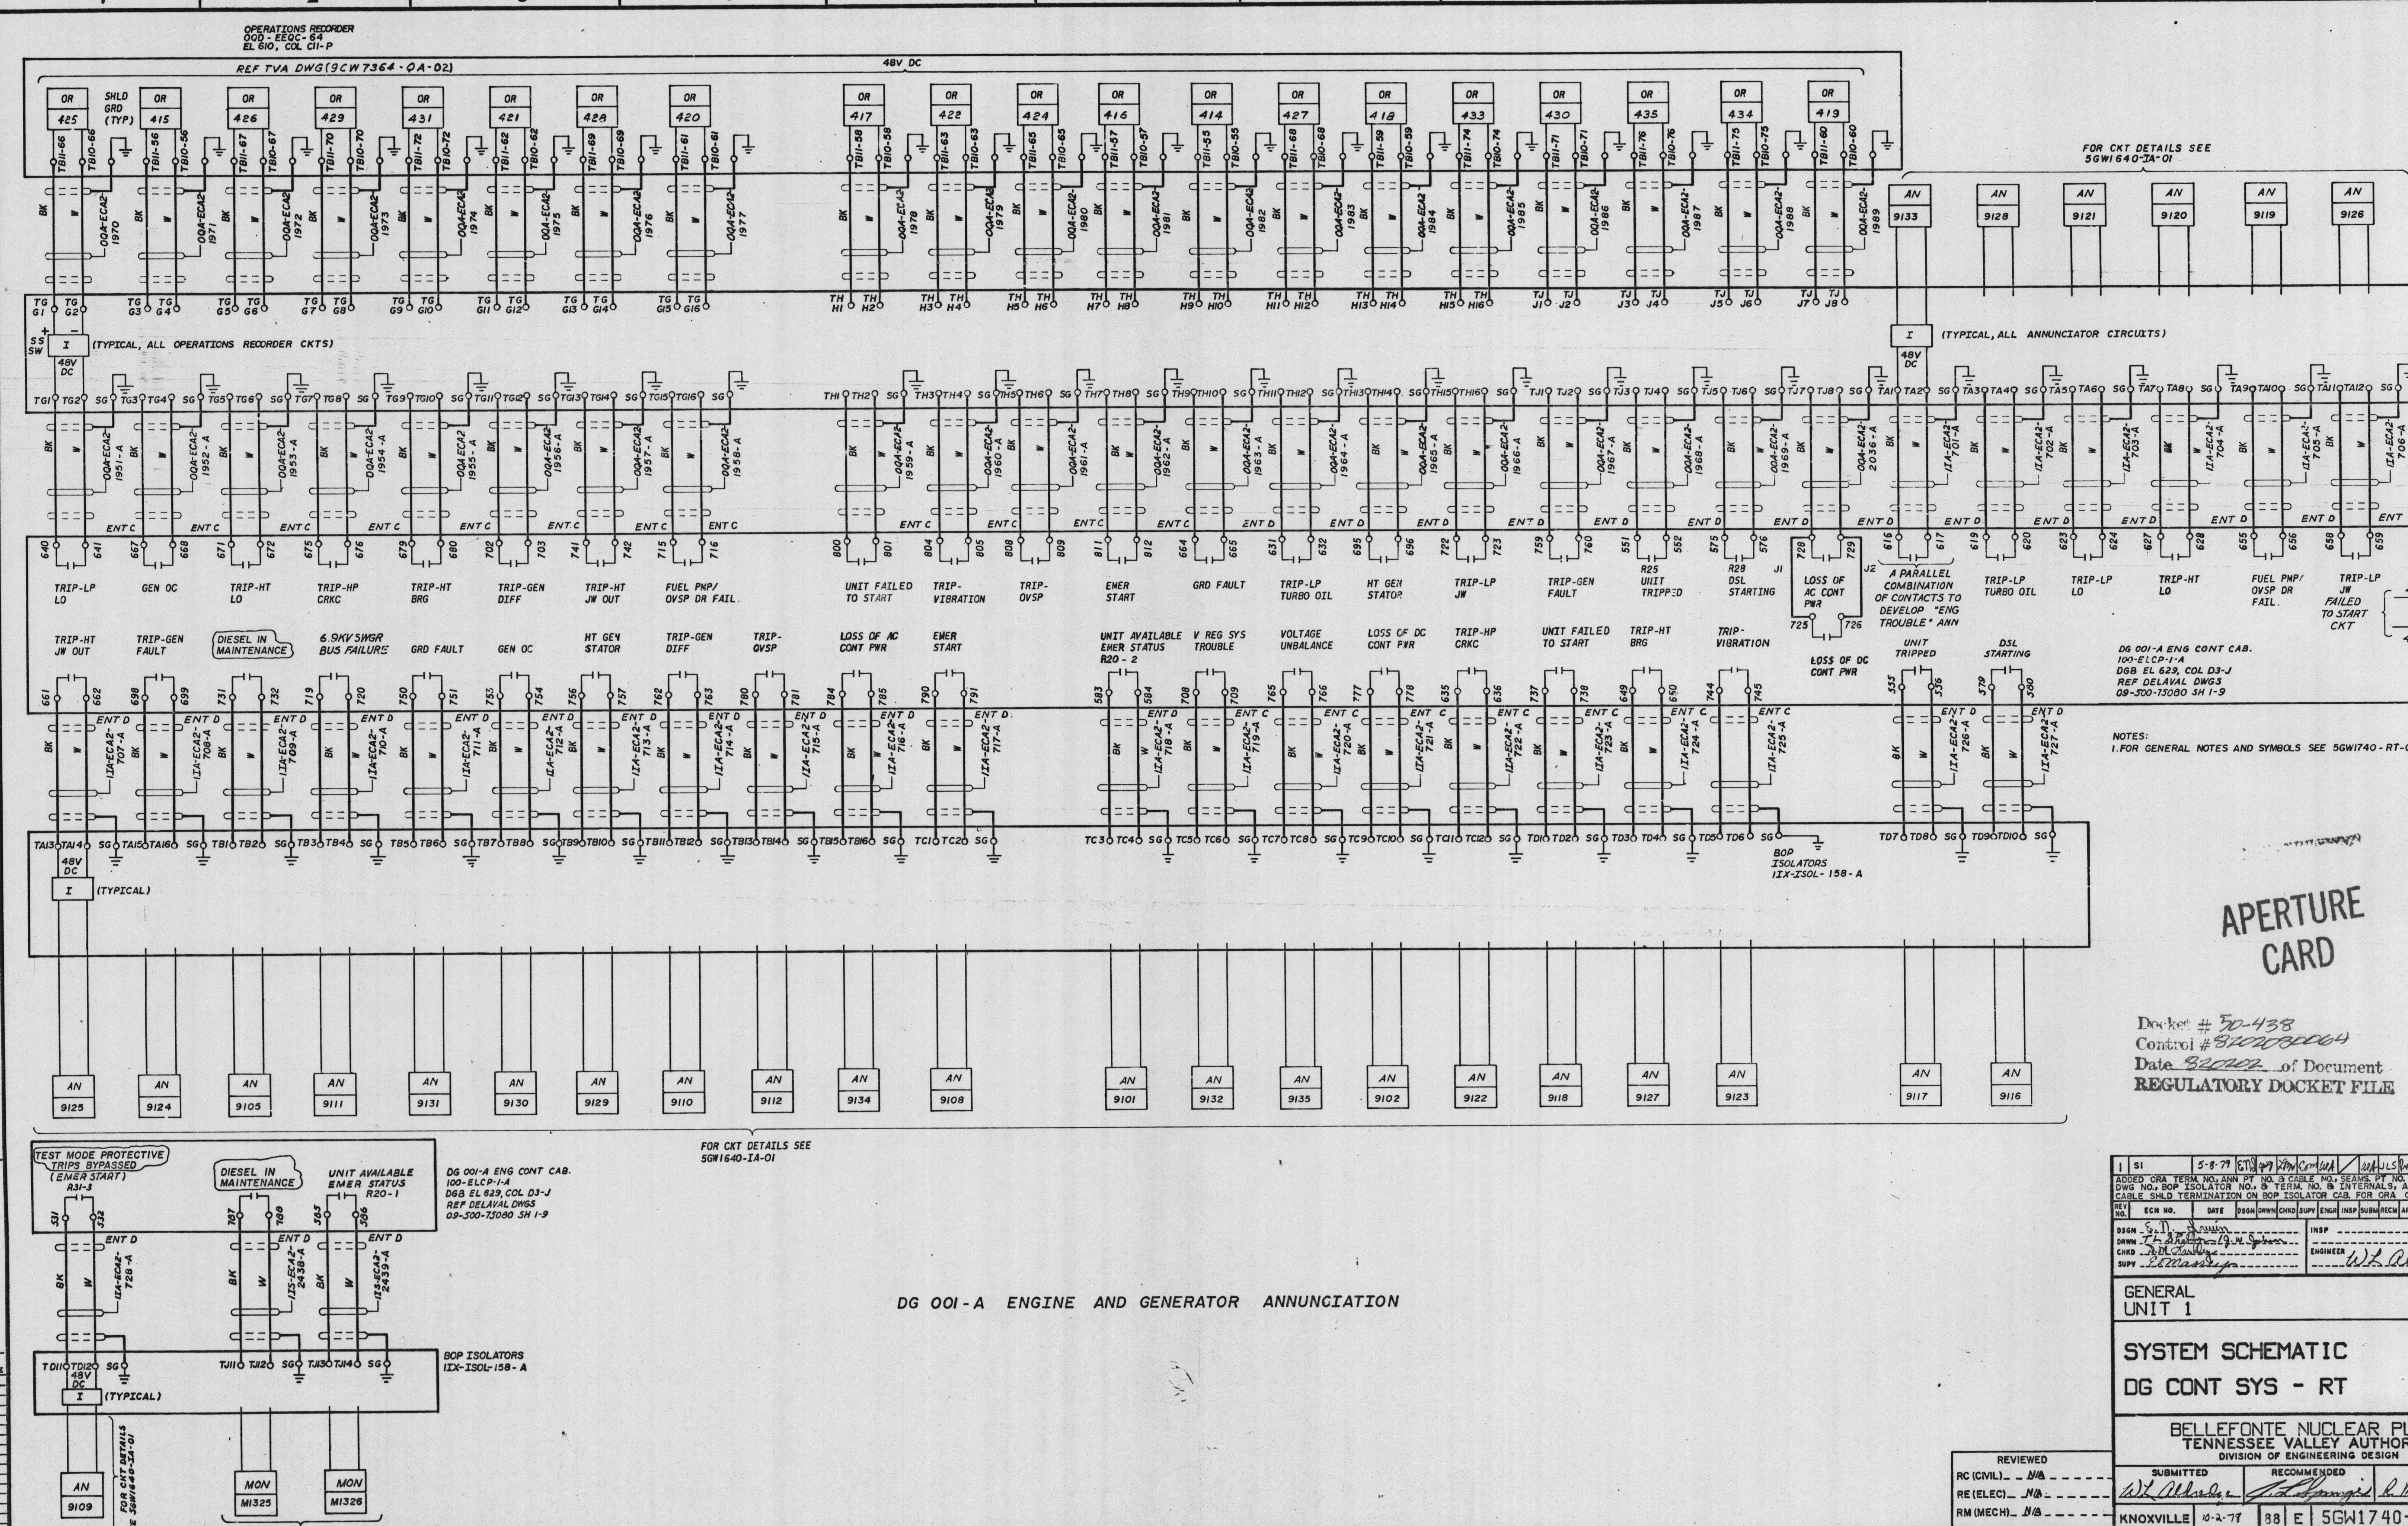

DG 001-A ENGINE AND GENERATOR ANNUNCIATION

NOTES:
1. FOR GENERAL NOTES AND SYMBOLS SEE 5GW1740-RT-01.

APERTURE CARD

Docket # 50-438
Control # 8202030064
Date 820202 of Document
REGULATORY DOCKET FILE

REV NO.	ECN NO.	DATE	DSGN	DRWN	CHKD	SUPV	ENGR	INSP	SUBM	RECM	APPR
1	SI	5-8-79	END								

ADDED ORA TERM. NO., ANN PT NO. & CABLE NO., SEAMS. PT NO. & CABLE NO. & REF DWG NO., BOP ISOLATOR NO., & TERM. NO. & INTERNALS, AND REMOVED CABLE SHLD TERMINATION ON BOP ISOLATOR CAB. FOR ORA CABLES.

DSGN E. N. Irwin
DRWN T. L. Shelton / J. W. Jackson
CHKD D. M. Lashley
SUPV E. Massey
INSP
ENGINEER W. L. Aldredge

GENERAL
UNIT 1

SYSTEM SCHEMATIC
DG CONT SYS - RT

BELLEFONTE NUCLEAR PLANT
TENNESSEE VALLEY AUTHORITY
DIVISION OF ENGINEERING DESIGN
Q

REVIEWED
RC (CIVIL) N/A
RE (ELEC) N/A
RM (MECH) N/A

SUBMITTED	RECOMMENDED	APPROVED
W. L. Aldredge	J. L. Spangi	R. M. Hodges

KNOXVILLE 10-2-78 | 88 | E | 5GW1740-RT-10 | R1

RECORD DRAWING AS CONSTRUCTED

MF
RO
R1