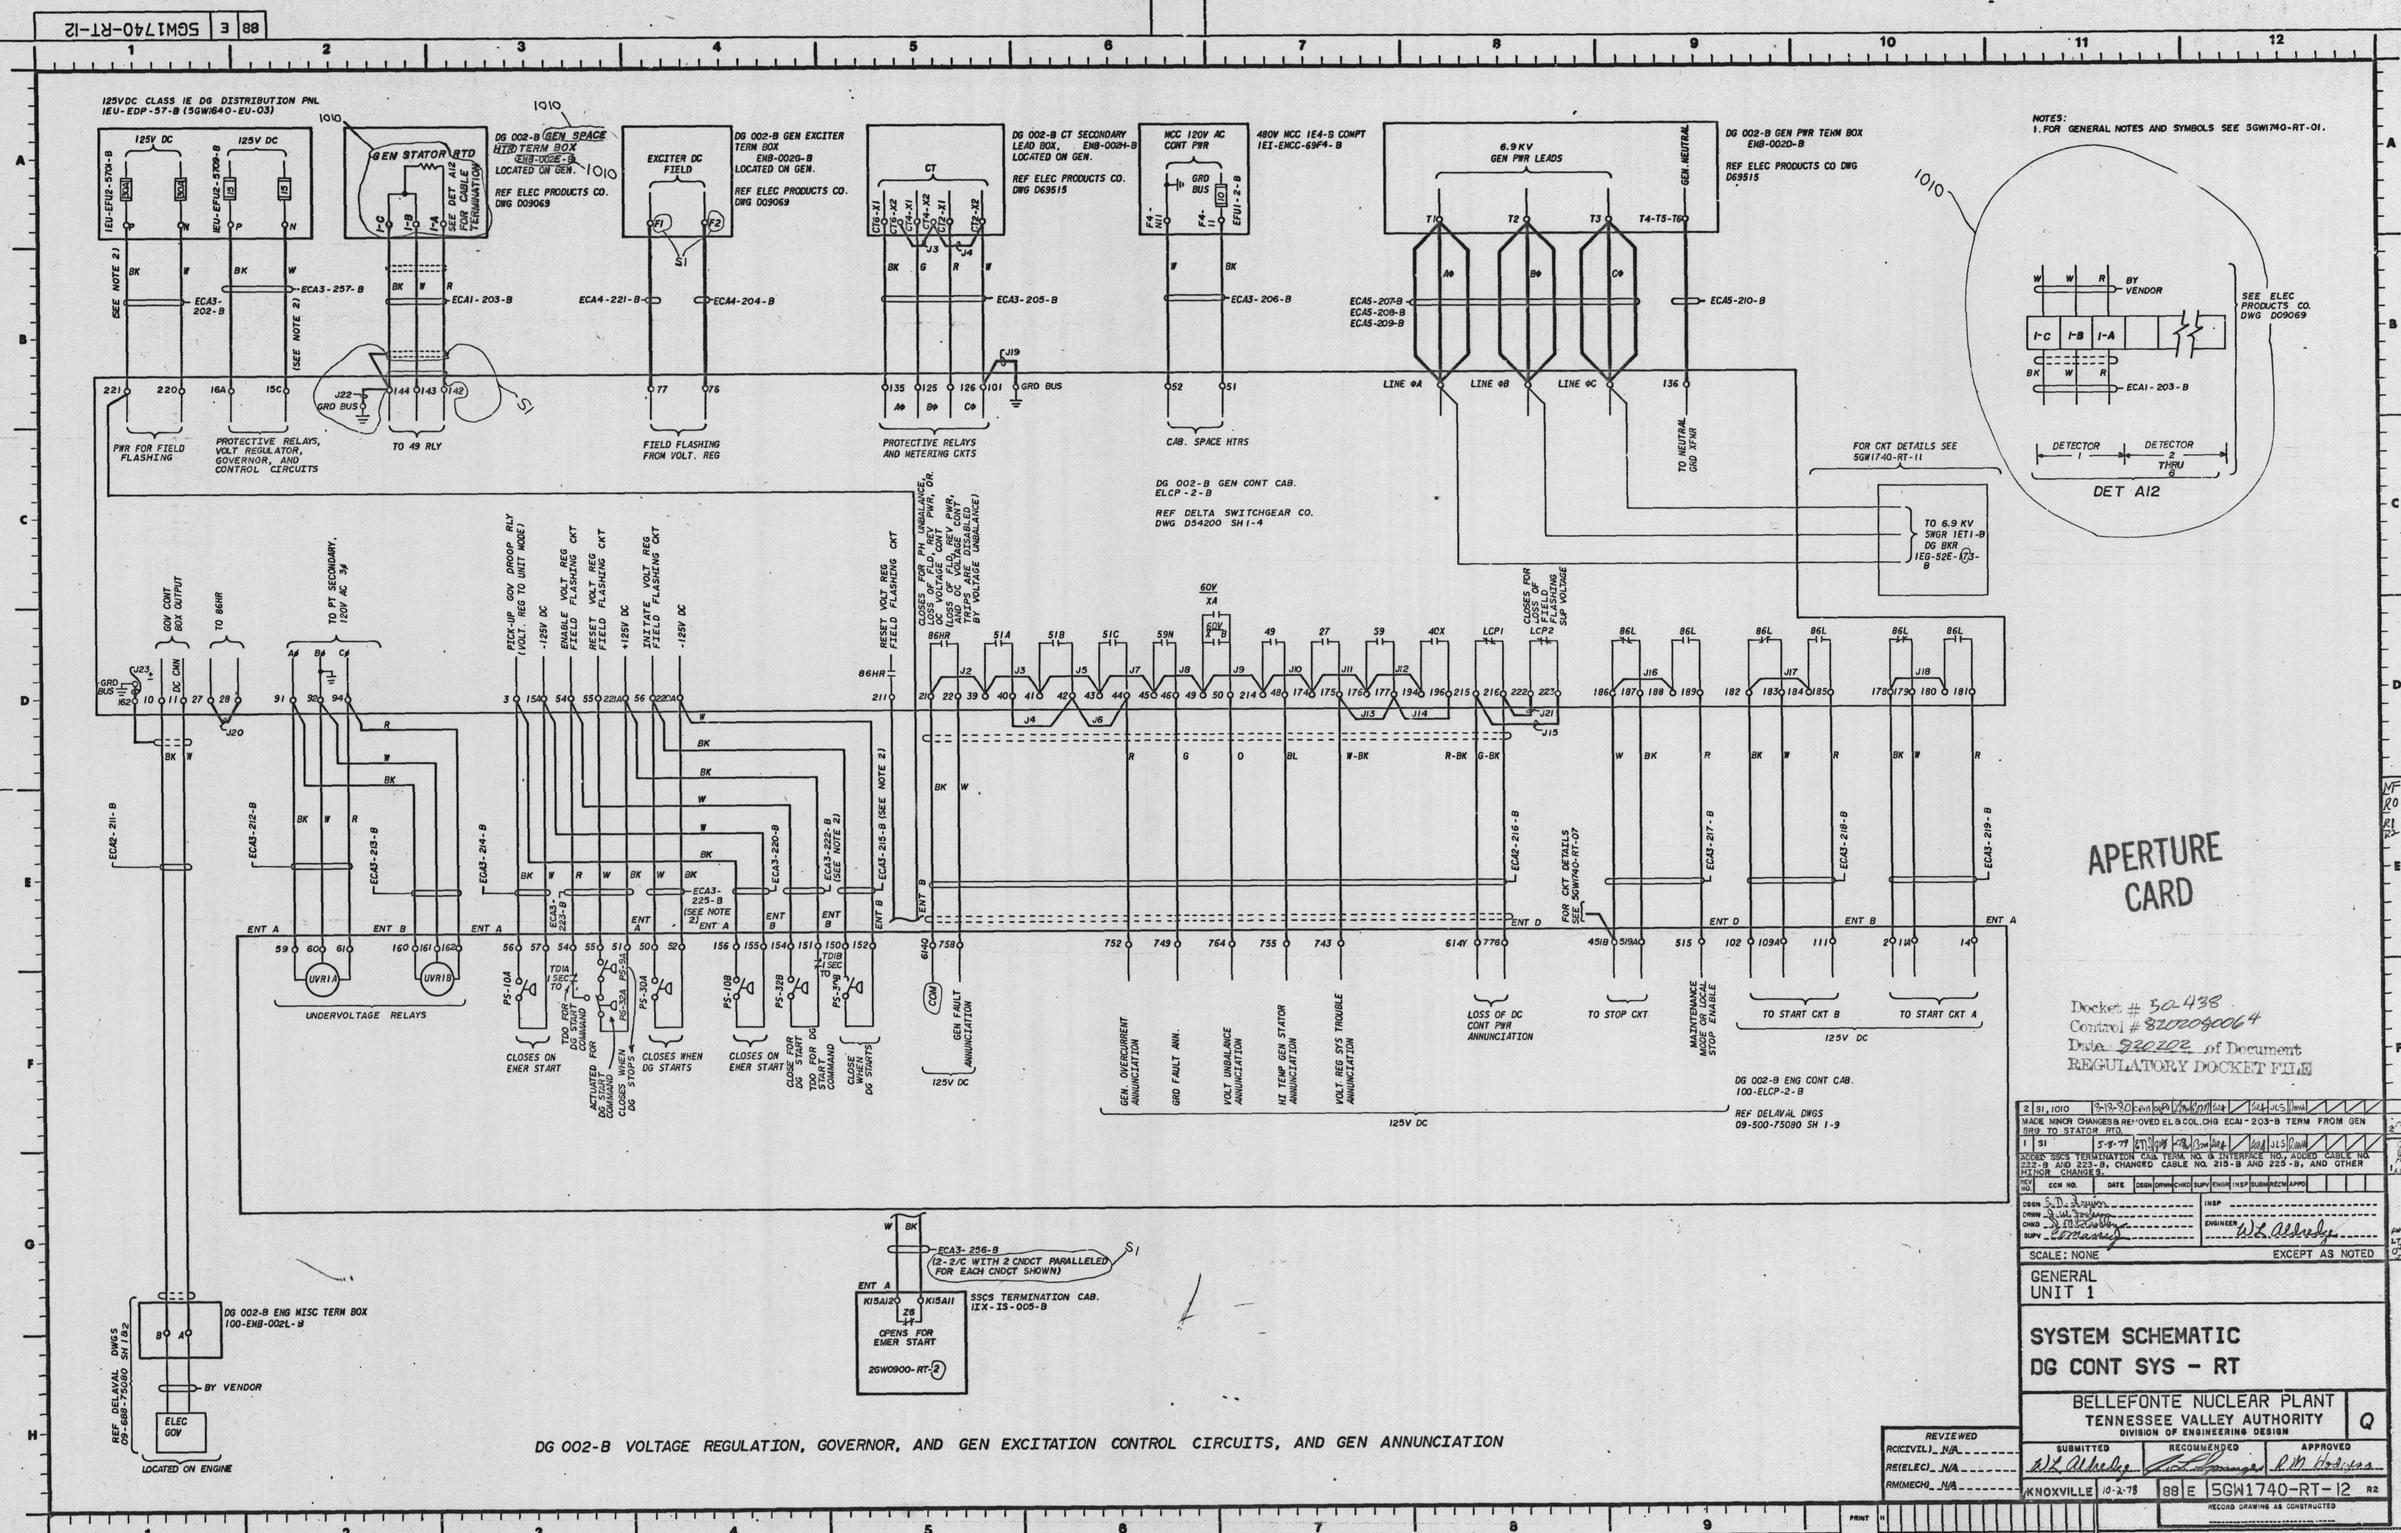

DG 002-B VOLTAGE REGULATION, GOVERNOR, AND GEN EXCITATION CONTROL CIRCUITS, AND GEN ANNUNCIATION

APERTURE CARD

Docket # 50-438
Control # 8202080064
Date 820202 of Document
REGULATORY DOCKET FILE

REV NO.	ECN NO.	DATE	DSGN	DRWN	CHKD	SUPV	ENGR	INSP	SUBM	RECM	APPD
2	S1, 1010	8-18-80									
MADE MINOR CHANGES & REMOVED EL & COL. CHG ECA1-203-B TERM FROM GEN BRG TO STATOR RTD.											
1	S1	5-8-79									
ADDED SSCS TERMINATION CAB. TERM. NO. & INTERFACE NO., ADDED CABLE NO. 222-B AND 223-B, CHANGED CABLE NO. 215-B AND 225-B, AND OTHER MINOR CHANGES.											

DSGN S. D. Arwin
DRWN J. W. Foxley
CHKD J. M. Hodges
SUPV Comanzo
INSP
ENGINEER W. L. Aldredge

SCALE: NONE — EXCEPT AS NOTED

GENERAL UNIT 1

SYSTEM SCHEMATIC
DG CONT SYS - RT

BELLEFONTE NUCLEAR PLANT
TENNESSEE VALLEY AUTHORITY
DIVISION OF ENGINEERING DESIGN

Q

SUBMITTED	RECOMMENDED	APPROVED
W. L. Aldredge	R. L. Springer	R. M. Hodges

KNOXVILLE 10-2-78 88 E 5GW1740-RT-12 R2

RECORD DRAWING AS CONSTRUCTED

REVIEWED
RC(CIVIL) N/A
RE(ELEC) N/A
RM(MECH) N/A

PRINT H
SIZE F
BR OR PROJ ME EE CE AD CD ED MD SW SL HA
PRINTS REQD-R