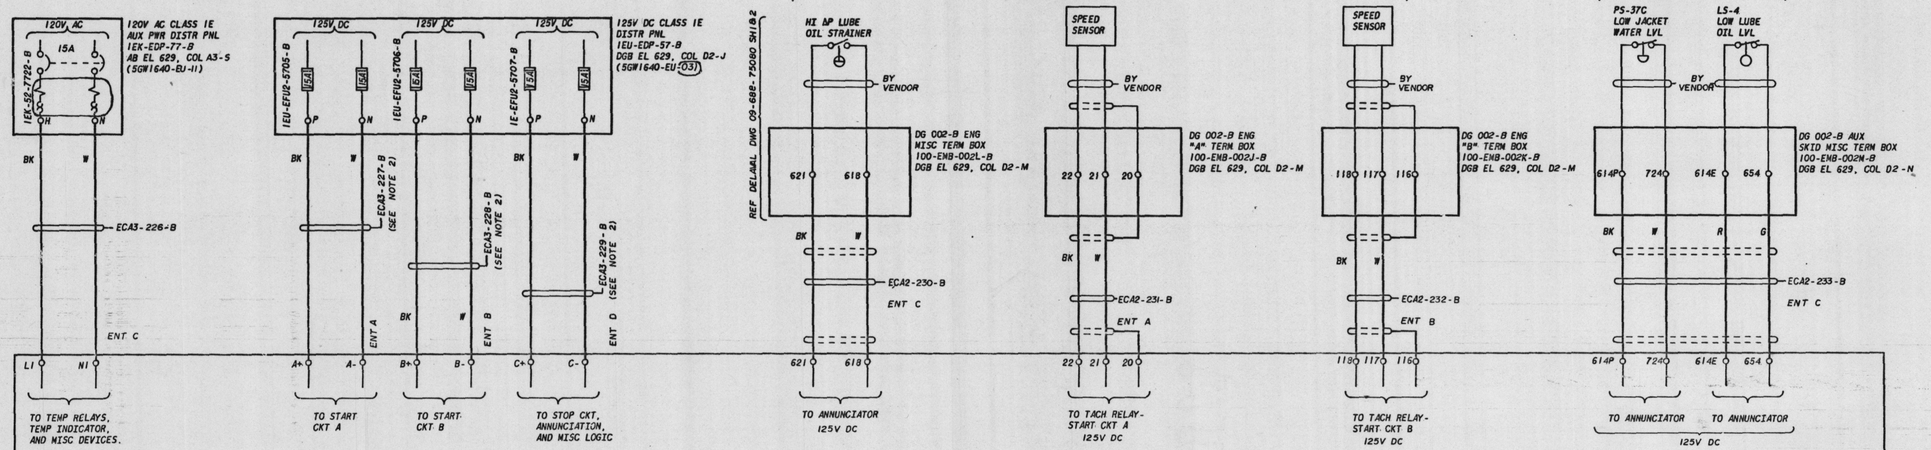

NOTES:
1. FOR GENERAL NOTES AND SYMBOLS SEE 5GW1740-RT-01.

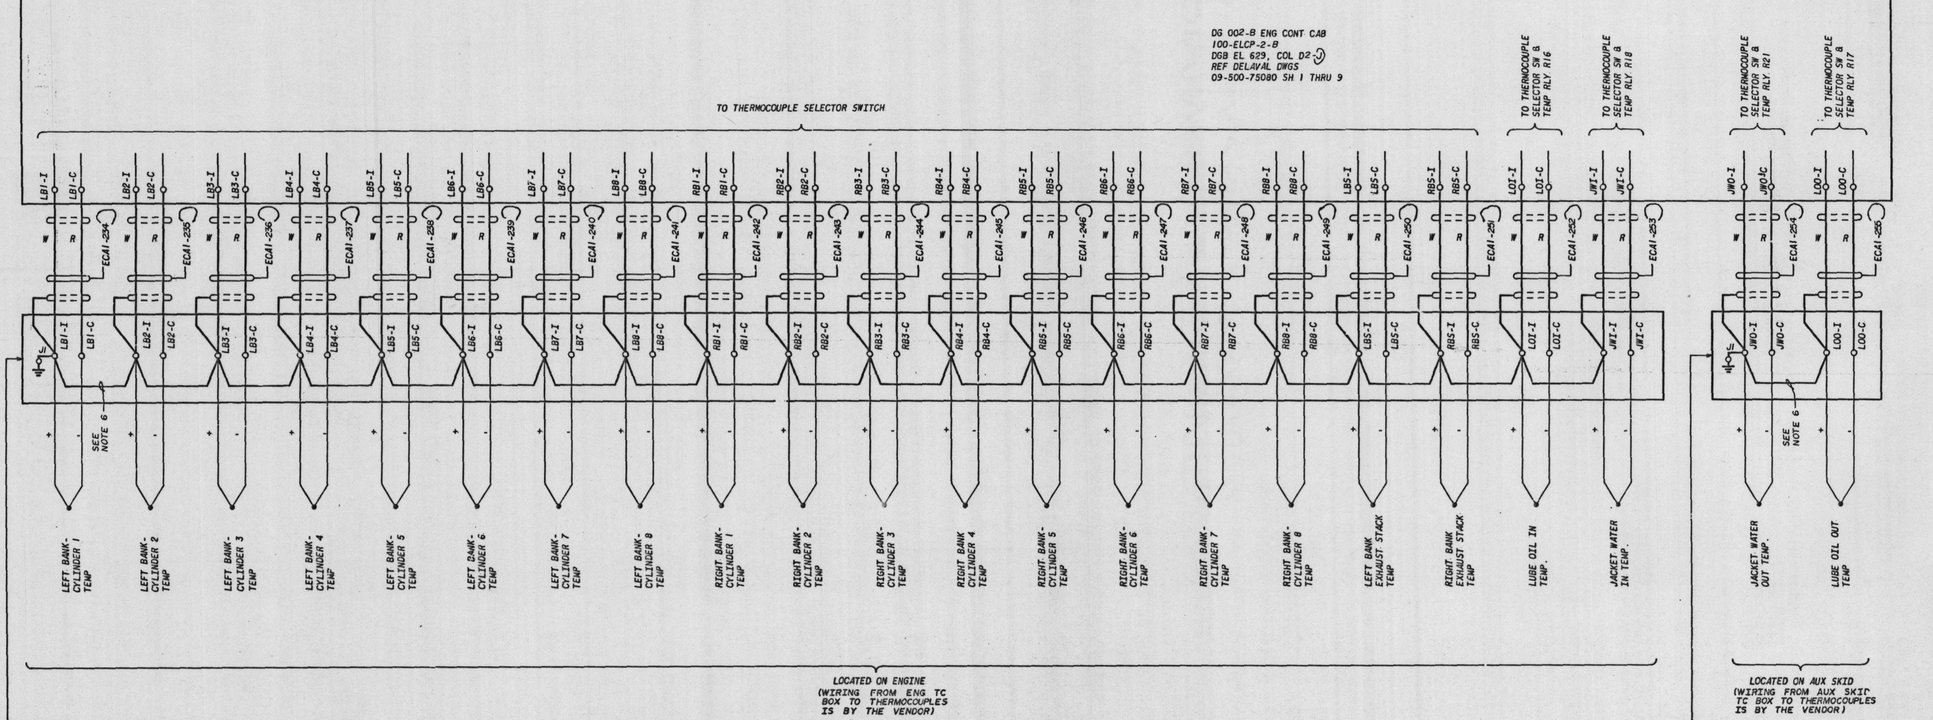

DG 002-B ENGINE THERMOCOUPLES, CONTROL POWER SUPPLIES, AND ANNUNCIATION

APERTURE CARD

Docket # 50-438
Control # 8202080064
Date 820202 of Document
REGULATORY DOCKET FILE

REV NO	ECN NO.	DATE	DSGN	DRWN	CHKD	SUPV	ENGR	INSP	LURR	RECD	APPD
1	S1	5-8-79	STW	WP	KMW						

REMOVED THE TRAINED DESIGNATION ON AUX SKID TC CABLES AND REMOVED THE TRAINED DESIGNATION ON THE UNID NO. FOR THE AUX SKID AND ENG TC BOXES AND OTHER MINOR CHANGES.

DSGN S.H. Brown
DRWN R.W. Baker
CHKD D.W. Sweeney
SUPV [illegible]
INSP
ENGINEER W.L. Aldridge

SCALE EXCEPT AS NOTED

GENERAL
UNIT 1

SYSTEM SCHEMATIC
DG CONT SYS-RT

BELLEFONTE NUCLEAR PLANT
TENNESSEE VALLEY AUTHORITY
DIVISION OF ENGINEERING DESIGN
Q

SUBMITTED	RECOMMENDED	APPROVED
W.L. Aldridge	[illegible]	R.M. Hobson

KNOXVILLE 10-2-78 | 88 E 5GW1740-RT-13 R1

RECORD DRAWING AS CONSTRUCTED

REVIEWED
RC(CIVIL) N/A
RE(ELEC) N/A
RM(MECH) N/A

PRINT
SIZE
BA OR PROJ WE EE CE AD CO ED MD SW BL PA
PRINTS REQD-A