NOTES:
1. FOR GENERAL NOTES AND REFERENCE DRAWINGS SEE 5GW1740-EG-01.
2. FOR MONITORING SYSTEM DEVELOPMENT SEE 5GW1740-EG-05.

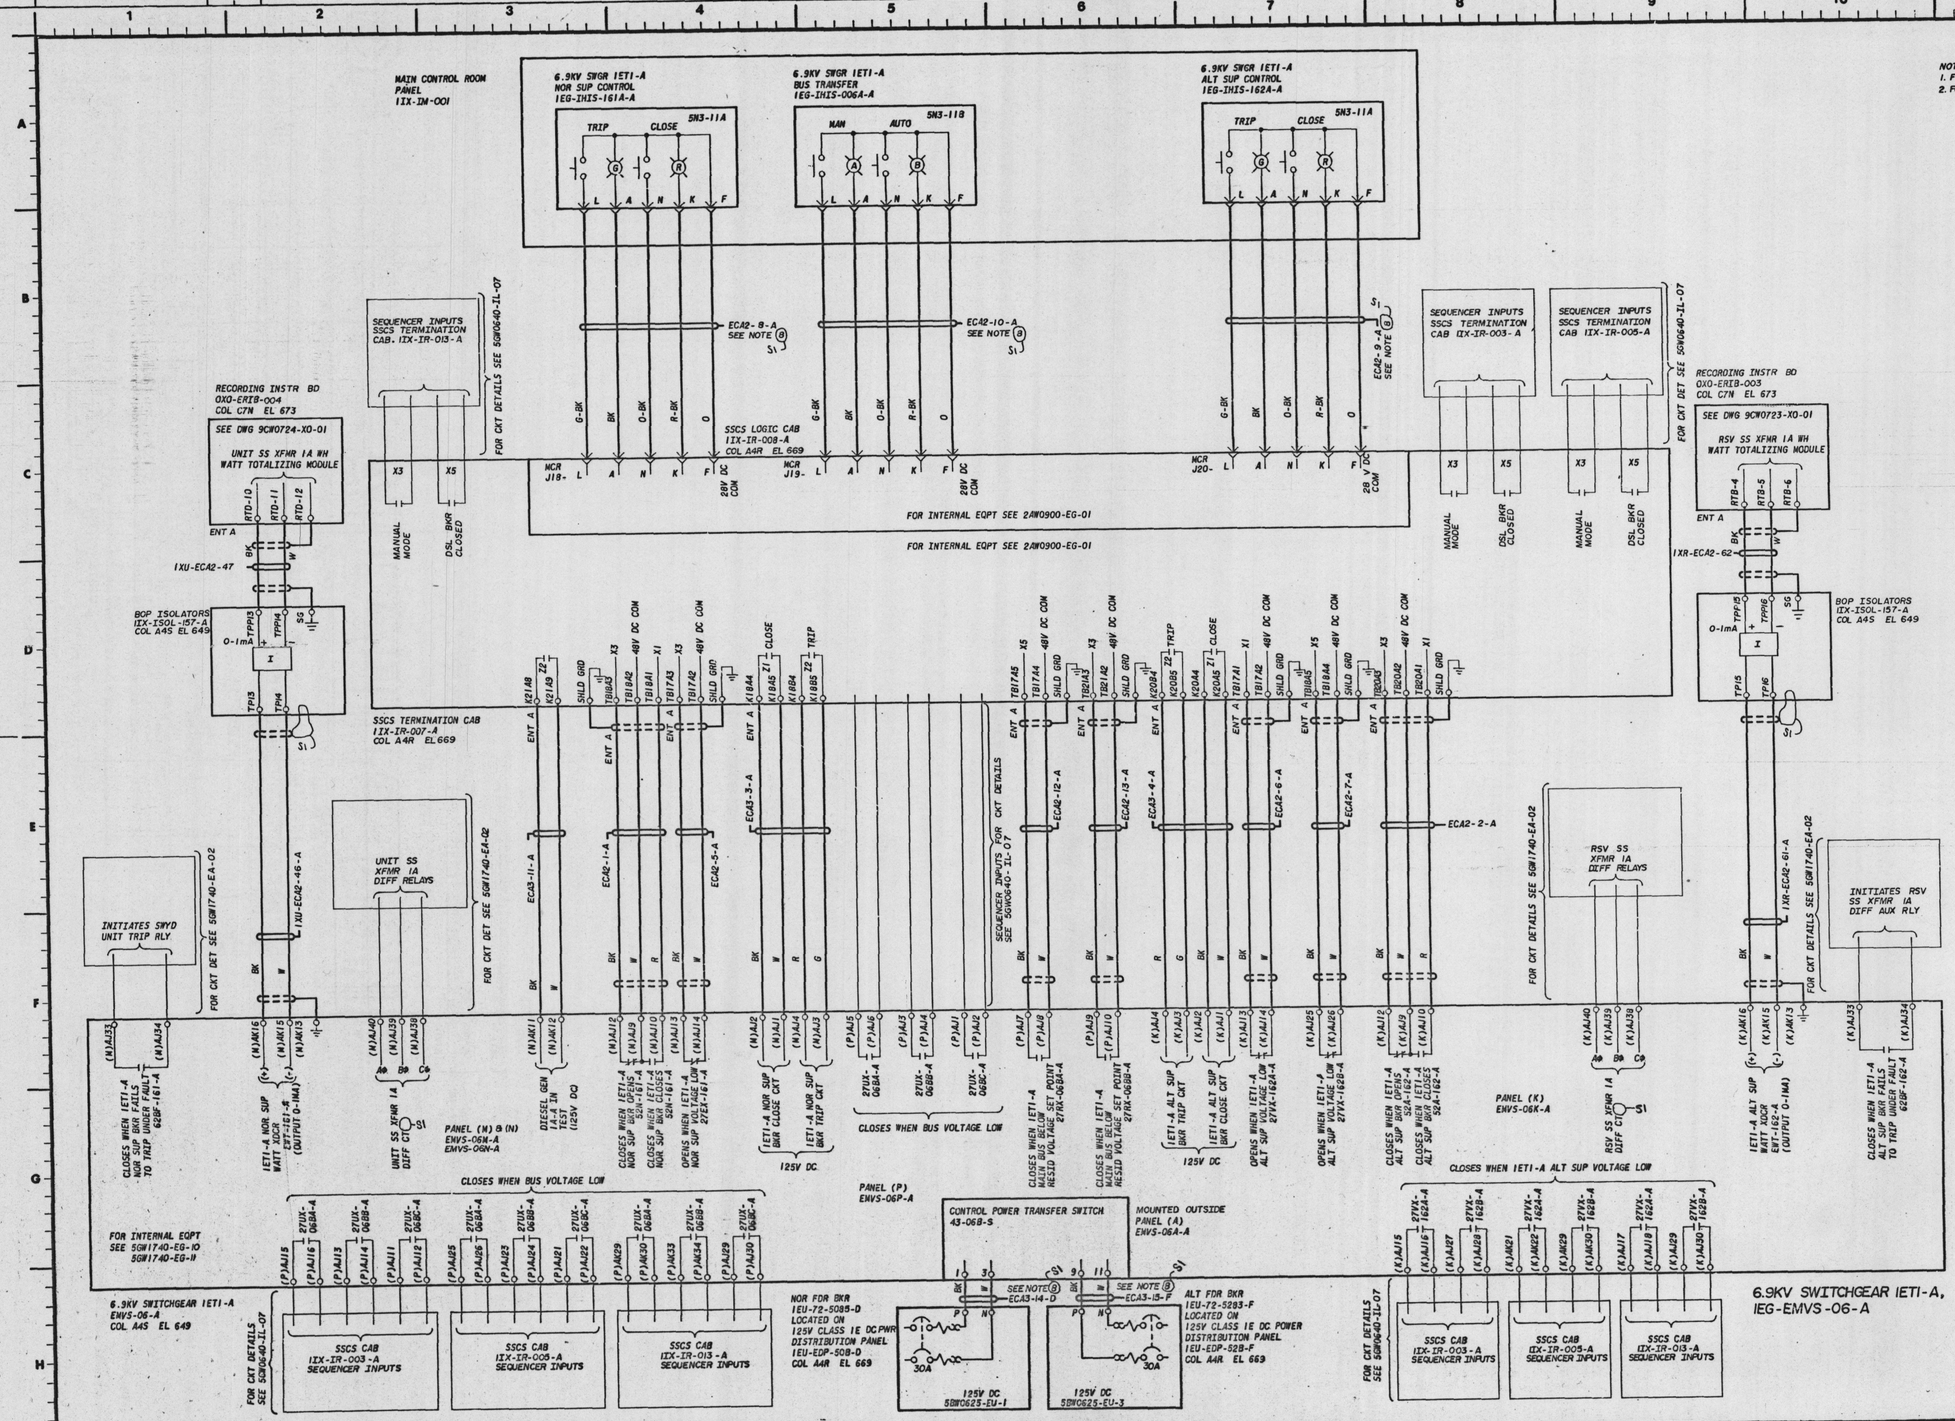

APERTURE CARD

Docket # 50-438
Control # 820208 0064
Date 820202 of Document
REGULATORY DOCKET FILE

REV	ECN NO.	DATE	DSGN	DRWN	CHKD	SUPV	ENGR	INSP	SUBM	RECM	APPD
2	S1	1-31-79									
	ADDED BOP ISOLATOR TERMINAL POINTS & SIGNAL PATHS. MINOR CHANGES.										
1	S1	7-19-78									
	MINOR REVISIONS PER S1										

DSGN J.C. HILL
DRWN J.W. JACKSON
CHKD L.E. WOOLLEY
SUPV
INSP
ENGINEER
SCALE EXCEPT AS NOTED

GENERAL
UNIT 1

SYSTEM SCHEMATIC 6.9KV CLASS 1E AC AUX PWR DISTRIBUTION SYSTEM

BELLEFONTE NUCLEAR PLANT
TENNESSEE VALLEY AUTHORITY
DIVISION OF ENGINEERING DESIGN

Q

SUBMITTED | RECOMMENDED | APPROVED

KNOXVILLE 11-29-77 | 88 | E | 5GW1740-EG-02 R2

RECORD DRAWING AS CONSTRUCTED