NOTES.
1. FOR GENERAL NOTES AND REFERENCE DRAWINGS SEE 5GW1740-EG-01.

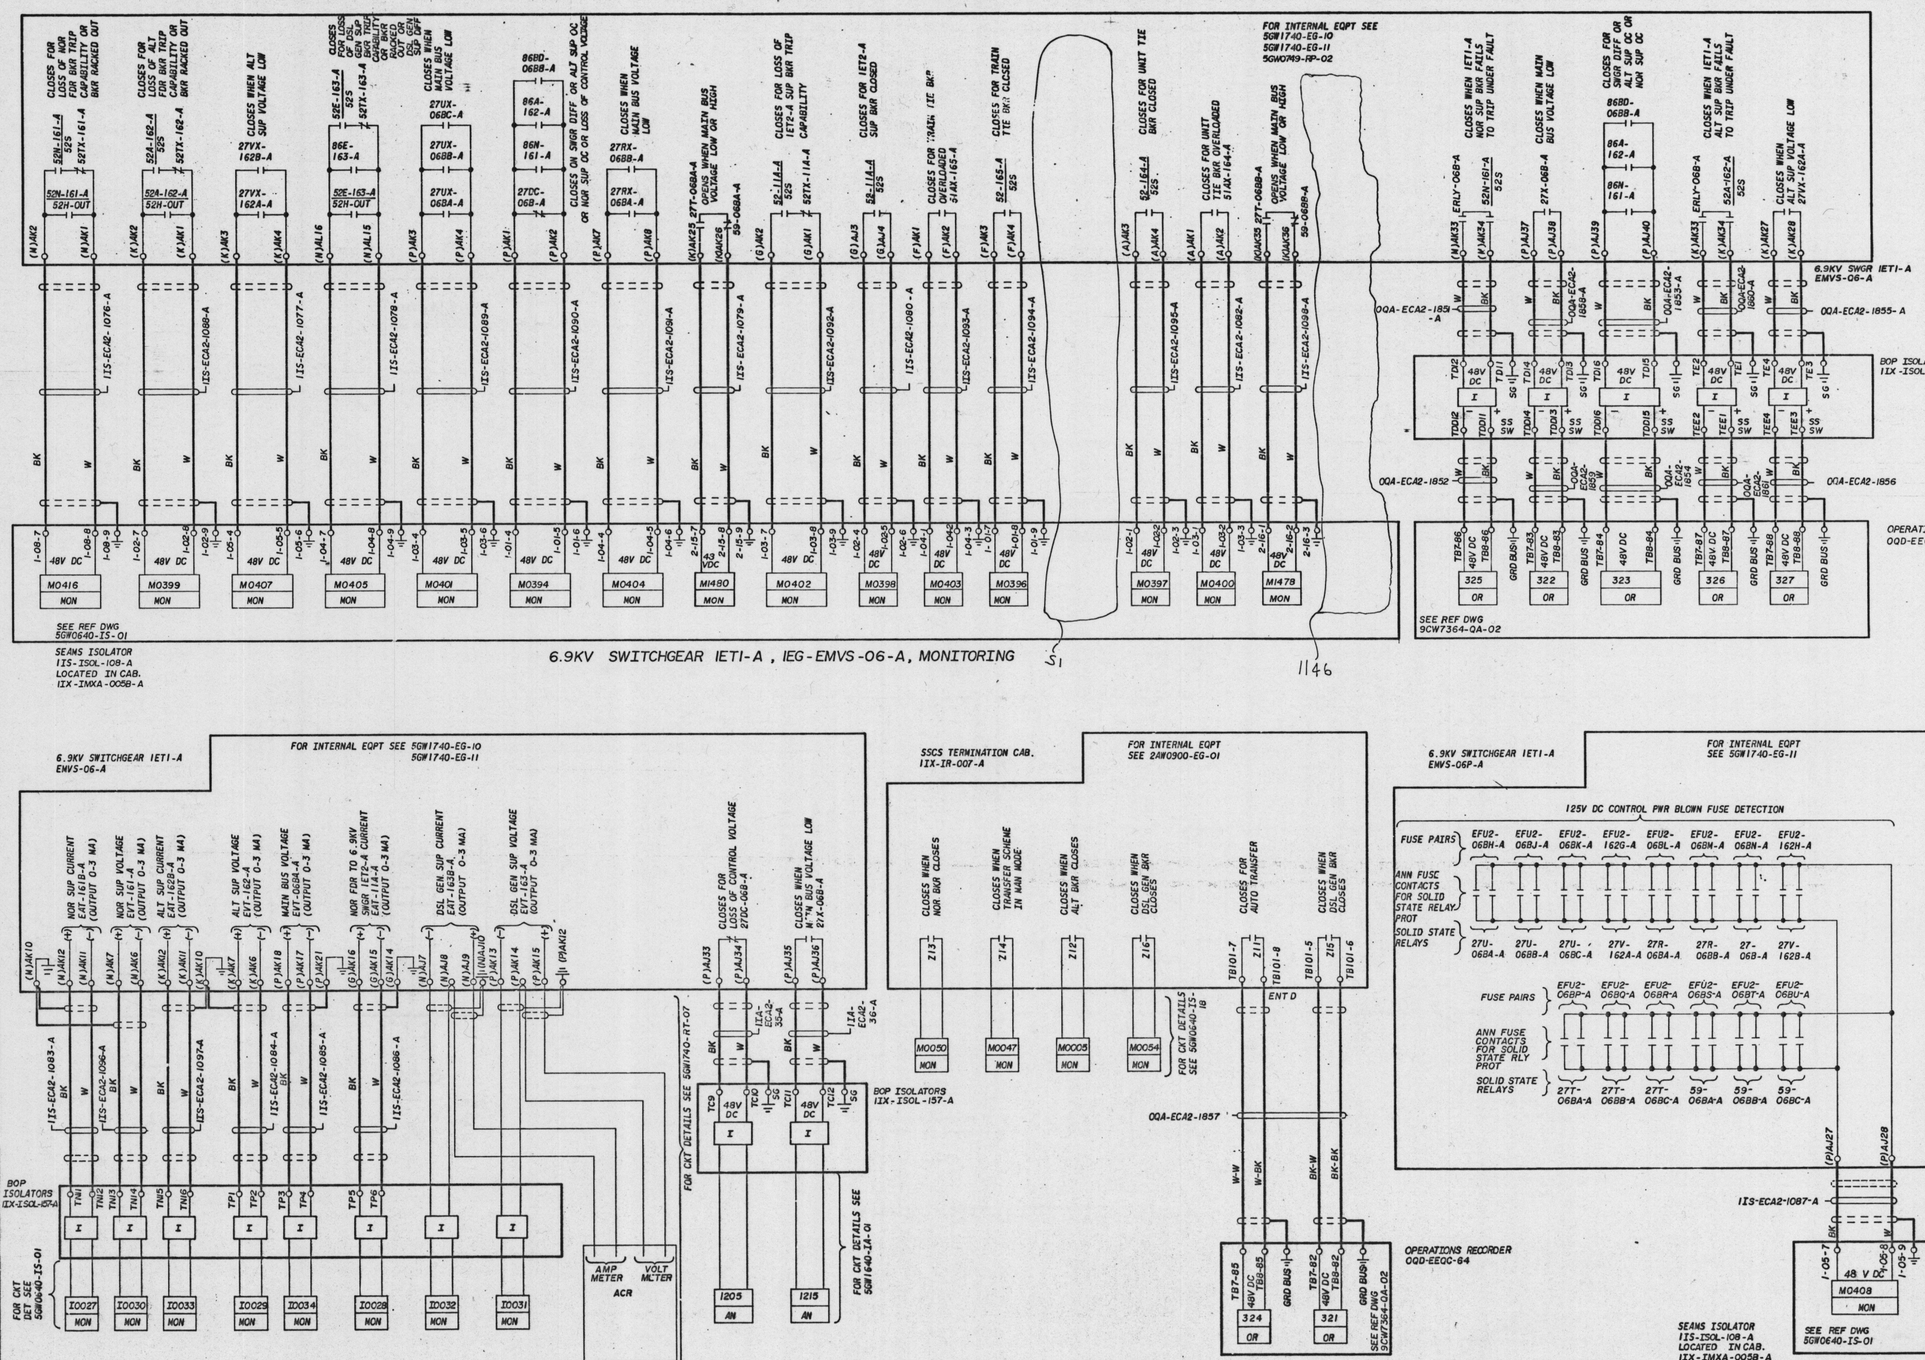

Docket # 50-438
Control # 8202090064
Date 8 20 82 of Document
REGULATORY DOCKET FILE

APERTURE CARD
Docket #
Control #
Date of Document
REGULATORY DOCKET FILE

REV NO.	ECN NO.	DATE	DSGN	DRWN	CHKD	SUPV	ENGR	INSP	SUBM	RECM	APPD	RE	RC	RM	RV
5	1146,S1	5-7-81	GCB	DLC											
DELETED SEAMS MONITORING POINTS.															
4	773	12-11-79													
CHANGED 628F CONTACT TO ERLY CONTACT & ADDED 523 AUX CONTACT.															
3	467,S1	5-18-79													
INCORPORATED THE NEW & MODIFIED DESIGN REQUIREMENTS FOR BUS TRANSFERS & VOLTAGE ANN POINTS, AND MINOR CHANGES.															
2	S1	1-31-77													
ADDED SEAMS AND BOP ISOLATOR TERMINAL POINTS, BOP ISOLATOR SIGNAL PATHS. REMOVED COL & EL. MINOR CHANGES.															
1	S1	1-19-78													
ADDED MONITORING PT NO., OPERATIONS RCER NOTATION AND TERMINAL PT, CABLE COLOR CODES, AND MINOR REVISIONS PER S1.															

DSGN J.C. HILL
DRWN
CHKD
SUPV
INSP
ENGINEER

SCALE EXCEPT AS NOTED

GENERAL
UNIT 1

SYSTEM SCHEMATIC
6.9KV CLASS 1E AC AUX PWR DISTRIBUTION SYSTEM

BELLEFONTE NUCLEAR PLANT
TENNESSEE VALLEY AUTHORITY
DIVISION OF ENGINEERING DESIGN

Q

SUBMITTED | RECOMMENDED | APPROVED

KNOXVILLE 11-29-77 88 E 5GW1740-EG-05 R5

RECORD DRAWING AS CONSTRUCTED