5DW2732-EI-03

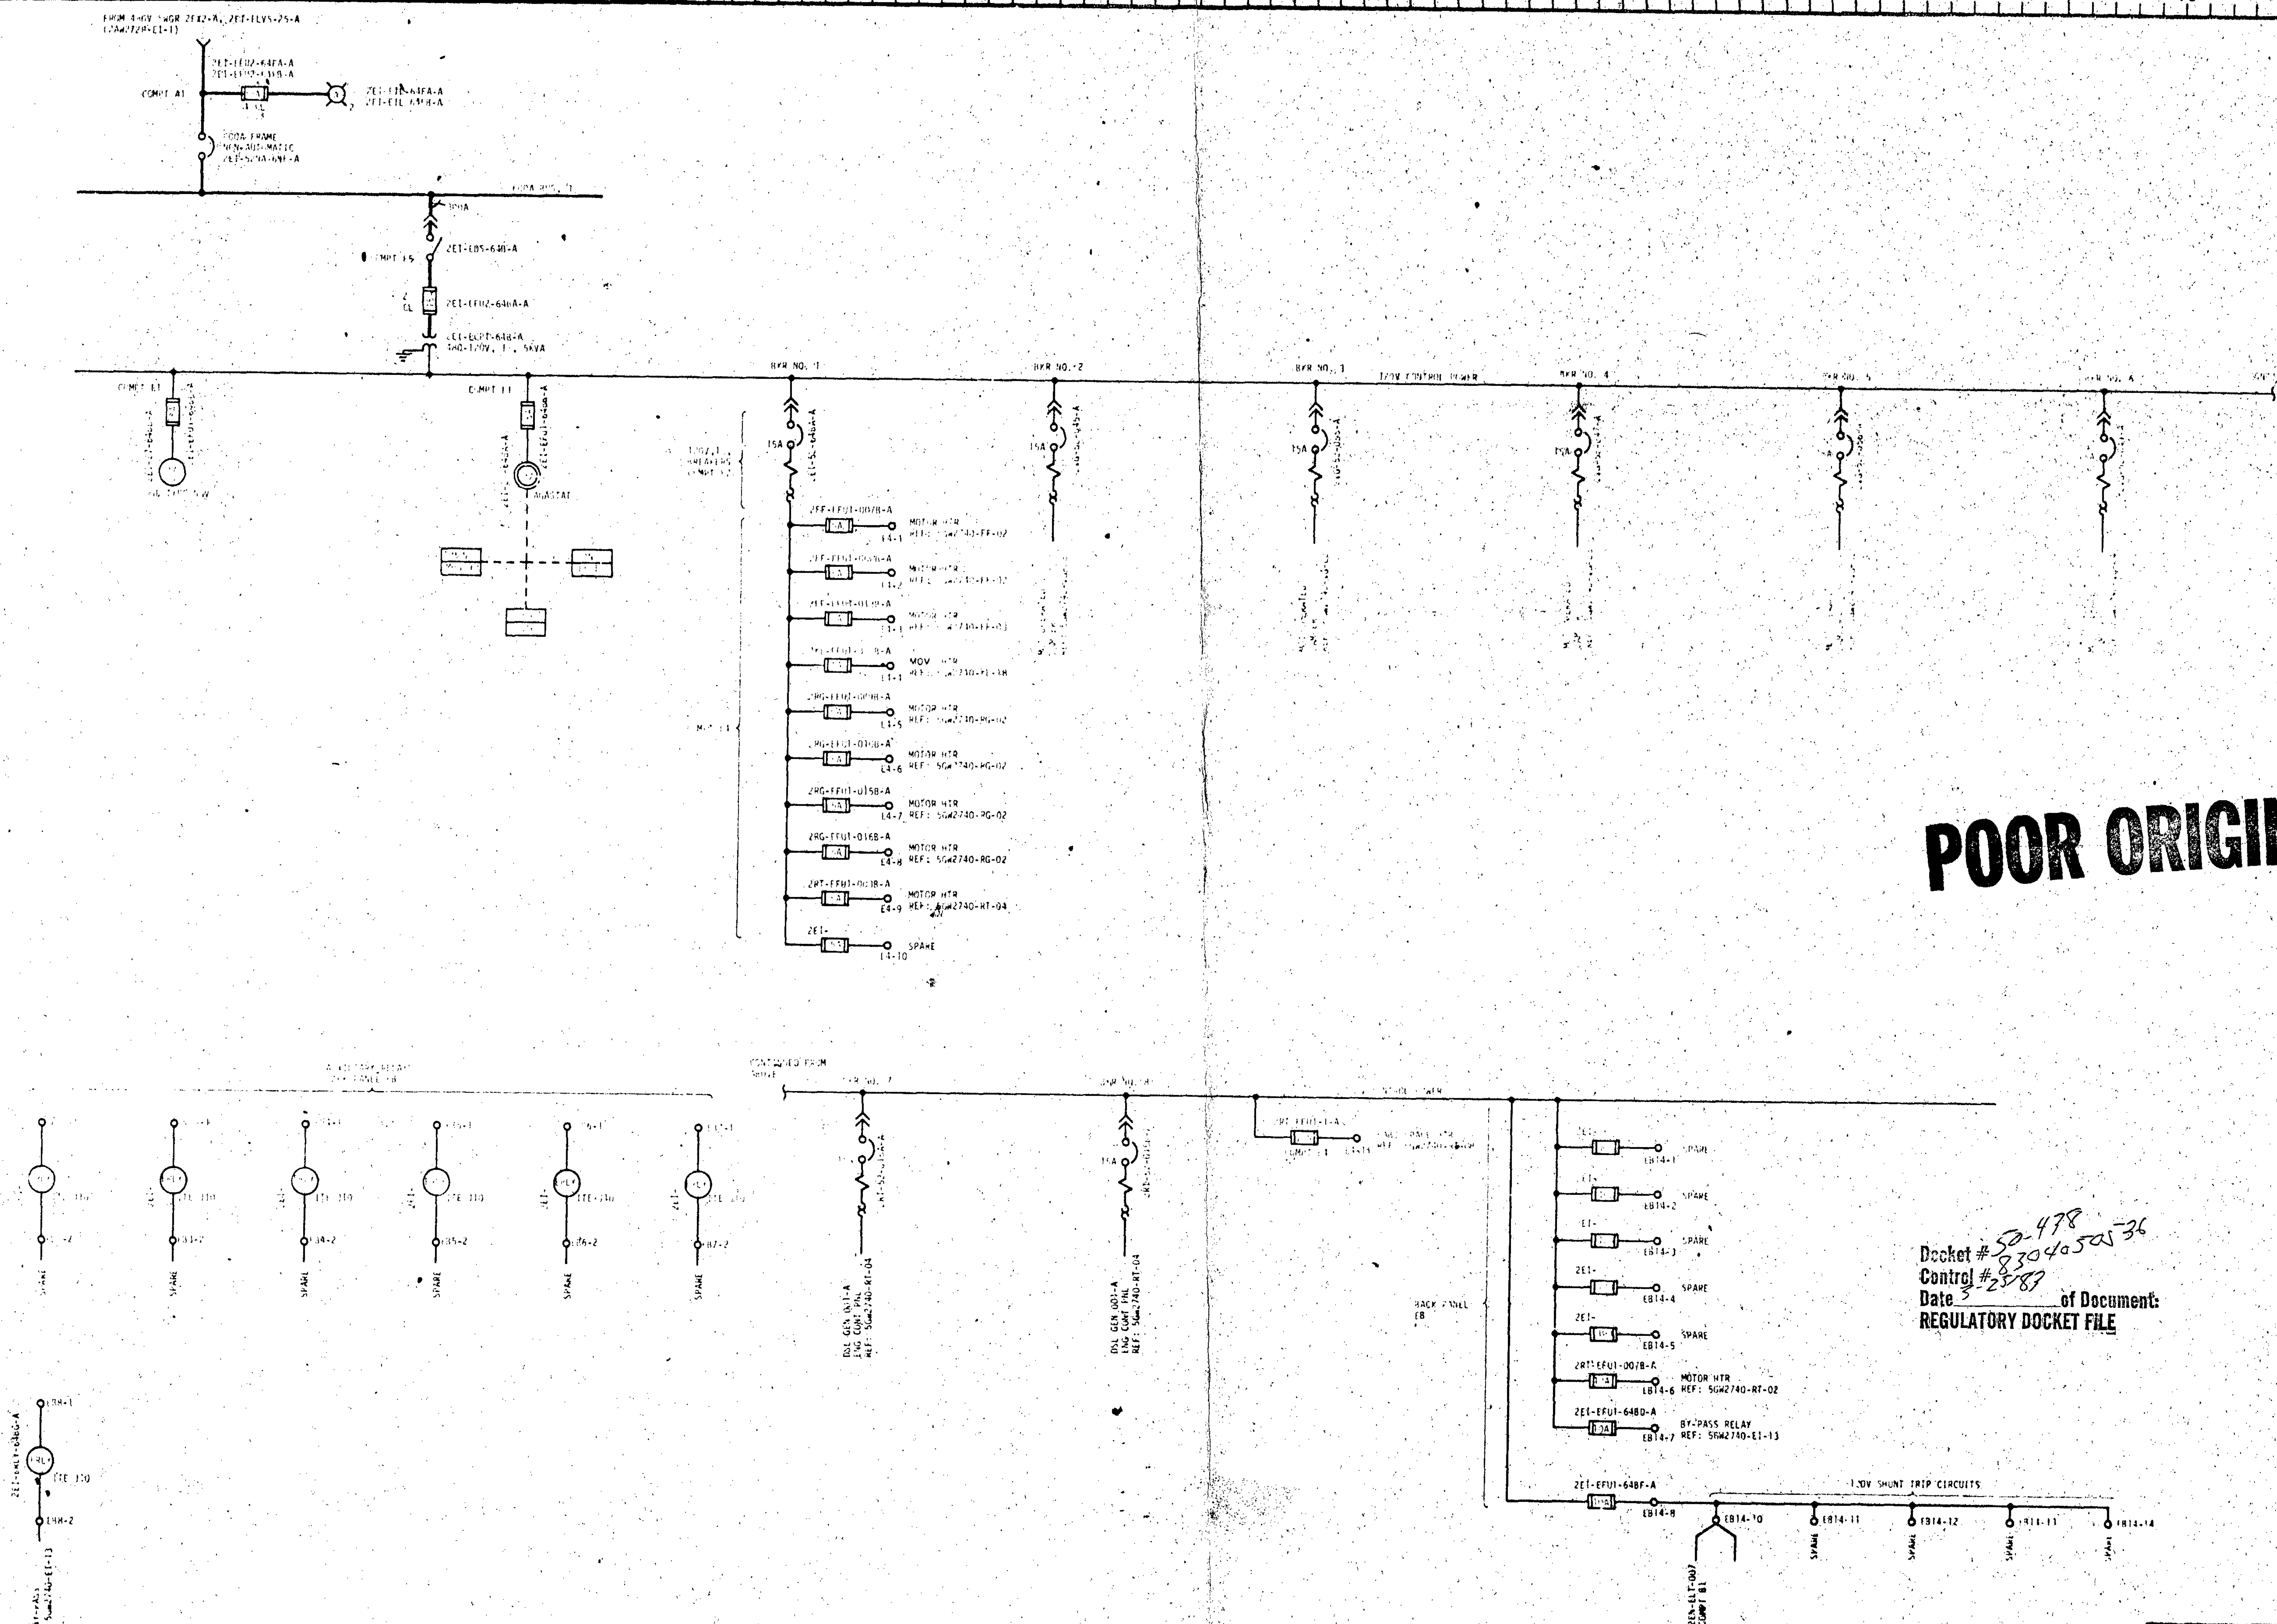


POOR ORIGINAL

Docket # 50-478
Control # 8304050536
Date 3-23-83 of Document:
REGULATORY DOCKET FILE

PRC APERTURE CARD

| RE NO | ECN NO | DATE | DSGN | DRWN | CHKD | SUPV | ENGR | INSP | SUBM | RECM | APPD |
|---|---|---|---|---|---|---|---|---|---|---|---|

DSGN / DRWN / CHKD / SUPV / INSP / ENGINEER (signatures)

SCALE: NTS — EXCEPT AS NOTED

DIESEL GENERATOR BUILDING
UNIT 2

SINGLE LINE
480V MCC 2E4-A
2EI-EMCC-64-A

REVIEWED
EEB. / CEB. / MEB. / NEB.

INSPECTED AND APPROVED FOR ISSUE

BELLEFONTE NUCLEAR PLANT
TENNESSEE VALLEY AUTHORITY
DIVISION OF ENGINEERING DESIGN
Q

SUBMITTED — RECOMMENDED — APPROVED

KNOXVILLE 9 3 82 | 88 | E | 5DW2732-EI-03 R0

RECORD DRAWING AS CONSTRUCTED