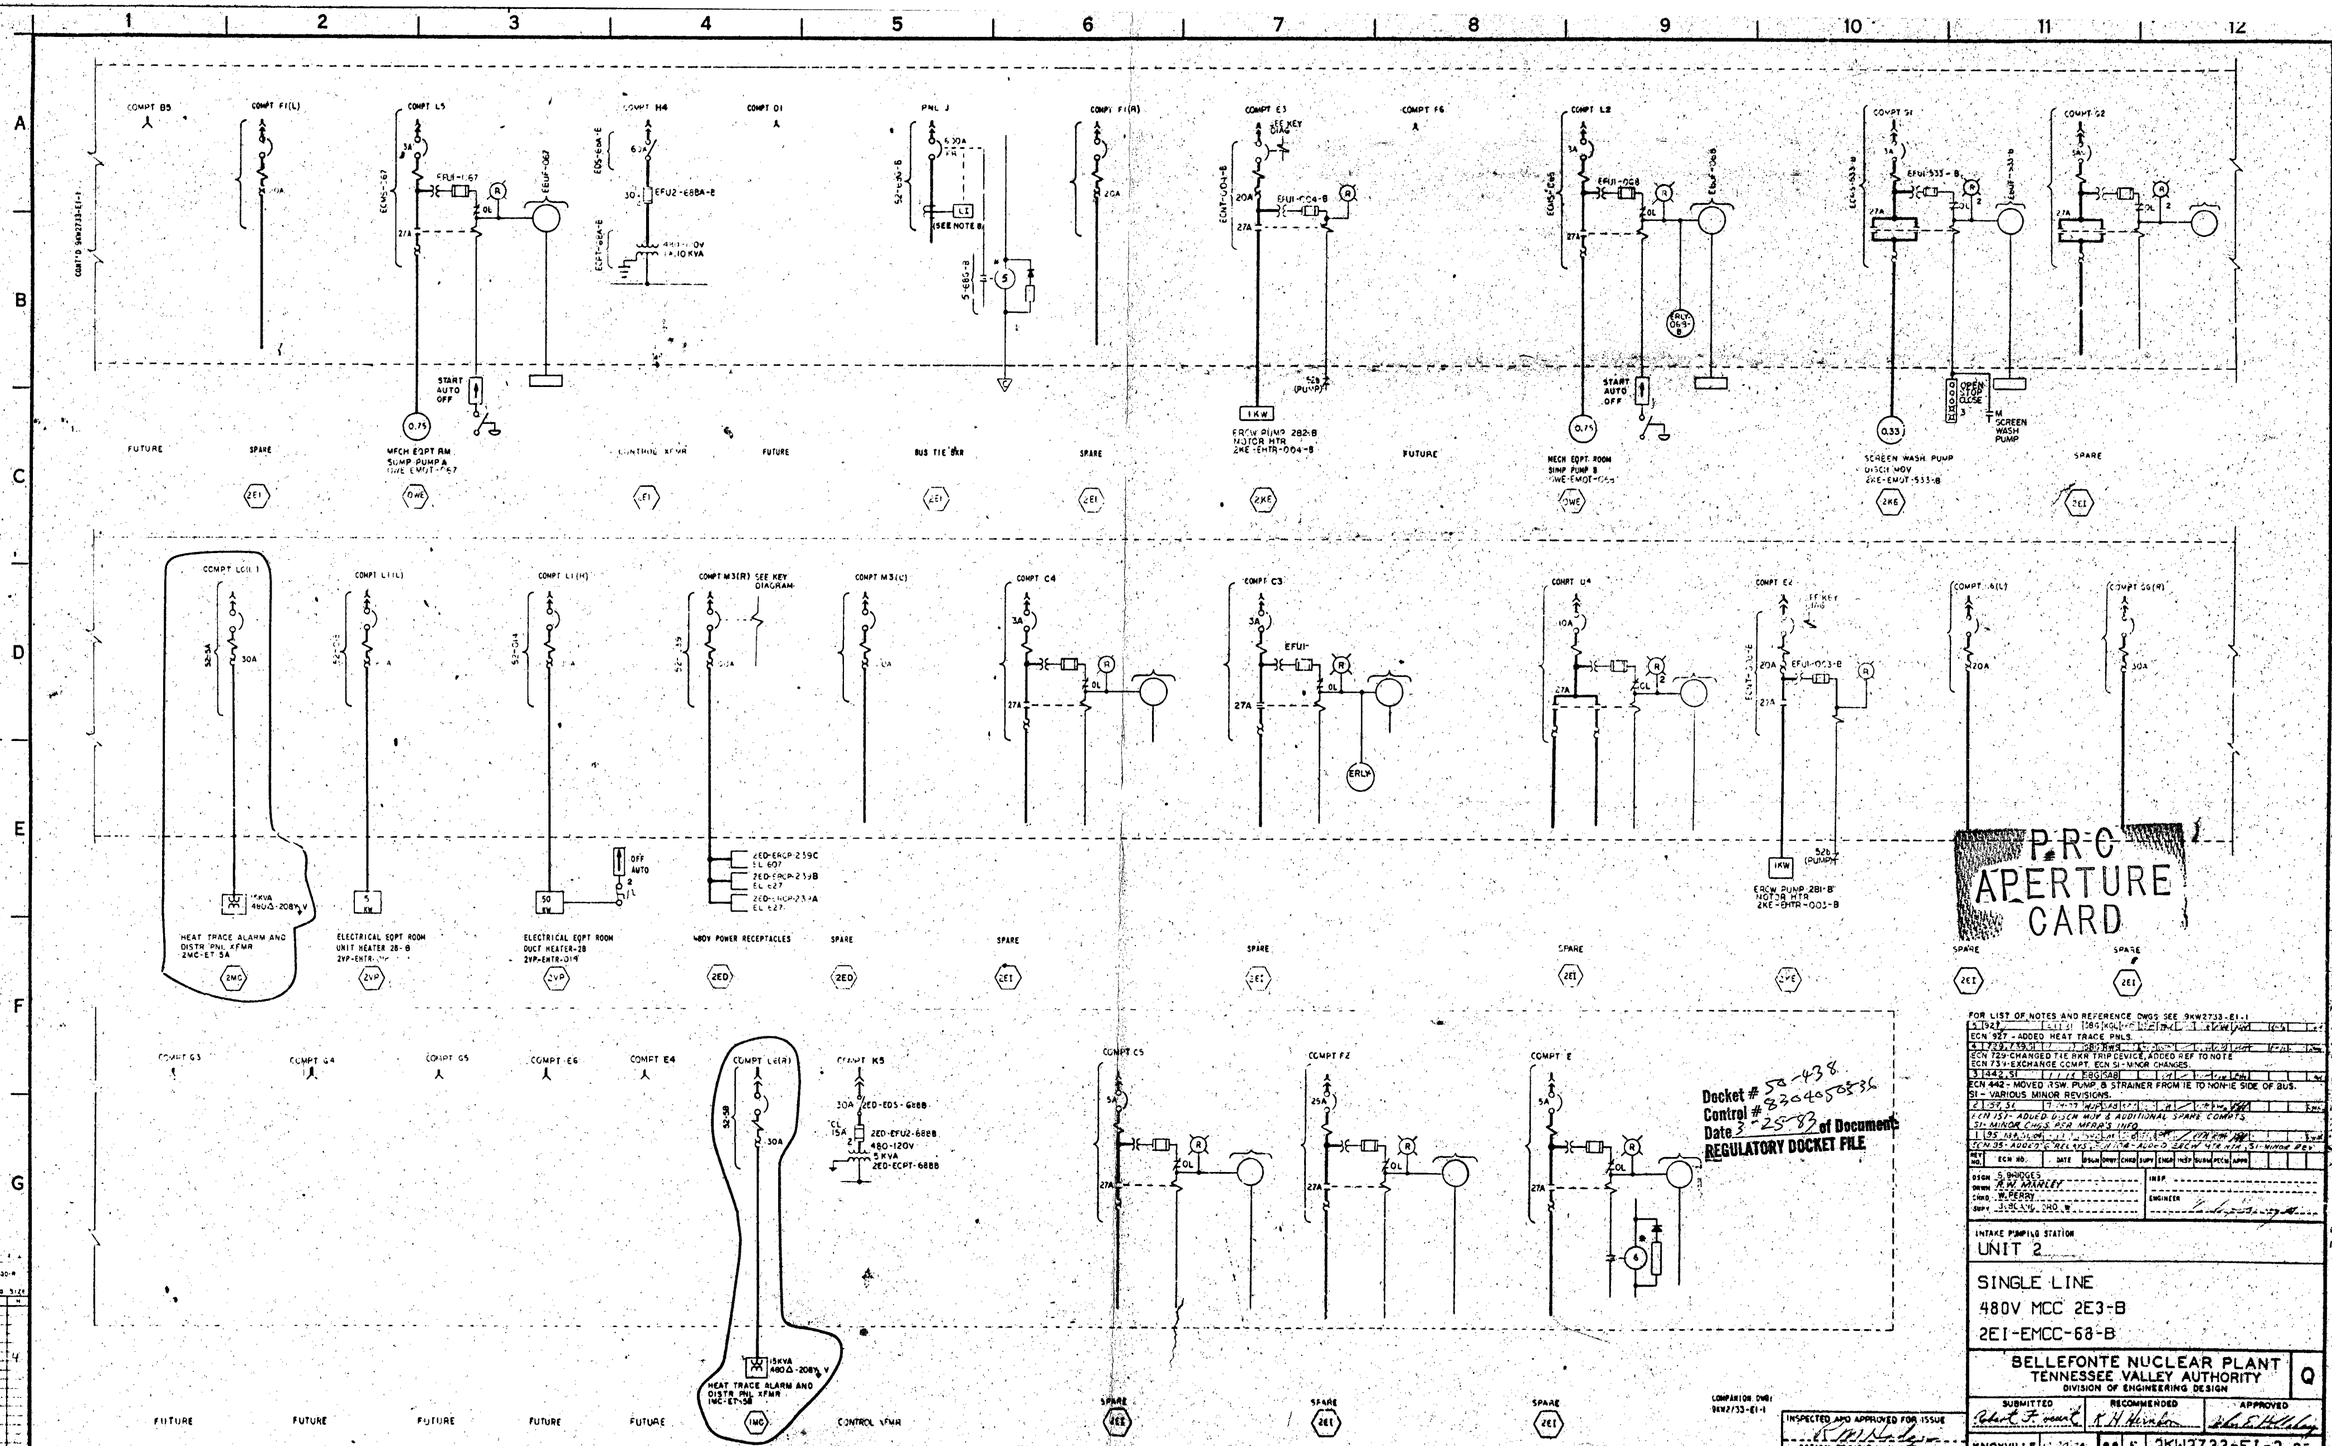

PRC APERTURE CARD

Docket # 50-438
Control # 8304050536
Date 3-25-83 of Document
REGULATORY DOCKET FILE

FOR LIST OF NOTES AND REFERENCE DWGS SEE 9KW2733-E1-1

5	927														
ECN 927 - ADDED HEAT TRACE PNLS.															
4	729, 739, S1														
ECN 729-CHANGED TIE BKR TRIP DEVICE, ADDED REF TO NOTE ECN 739-EXCHANGE COMPT. ECN S1-MINOR CHANGES.															
3	442, S1														
ECN 442 - MOVED RSW. PUMP, & STRAINER FROM IE TO NON-IE SIDE OF BUS. S1 - VARIOUS MINOR REVISIONS.															
2	95, S1														
ECN 157 - ADDED DISCH MOV & ADDITIONAL SPARE COMPTS. S1-MINOR CHGS PER MFRR'S INFO.															
1	95														
ECN 95 - ADDED 2 RELAYS, ECN 104 - ADDED 2ERCW HTR HTR, S1-MINOR REV															
REV NO.	ECN NO.	DATE	DSGN	DRWN	CHKD	SUPV	ENGR	INSP	SUBM	PECN	APPR				

DSGN S. BRIDGES
DRWN R.W. MANLEY
CHKD W. PERRY
SUPV J. BLANCHARD, JR.
INSP.
ENGINEER

INTAKE PUMPING STATION
UNIT 2

SINGLE LINE
480V MCC 2E3-B
2EI-EMCC-68-B

BELLEFONTE NUCLEAR PLANT
TENNESSEE VALLEY AUTHORITY
DIVISION OF ENGINEERING DESIGN

Q

SUBMITTED	RECOMMENDED	APPROVED
Robert F. Vaught	K.H. Hirsch	John E. Hillsley

INSPECTED AND APPROVED FOR ISSUE
DESIGN PROJECT MANAGER

KNOXVILLE 12-20-74 | 88 | E | 9KW2733-EI-2 R5

RECORD DRAWING AS CONSTRUCTED