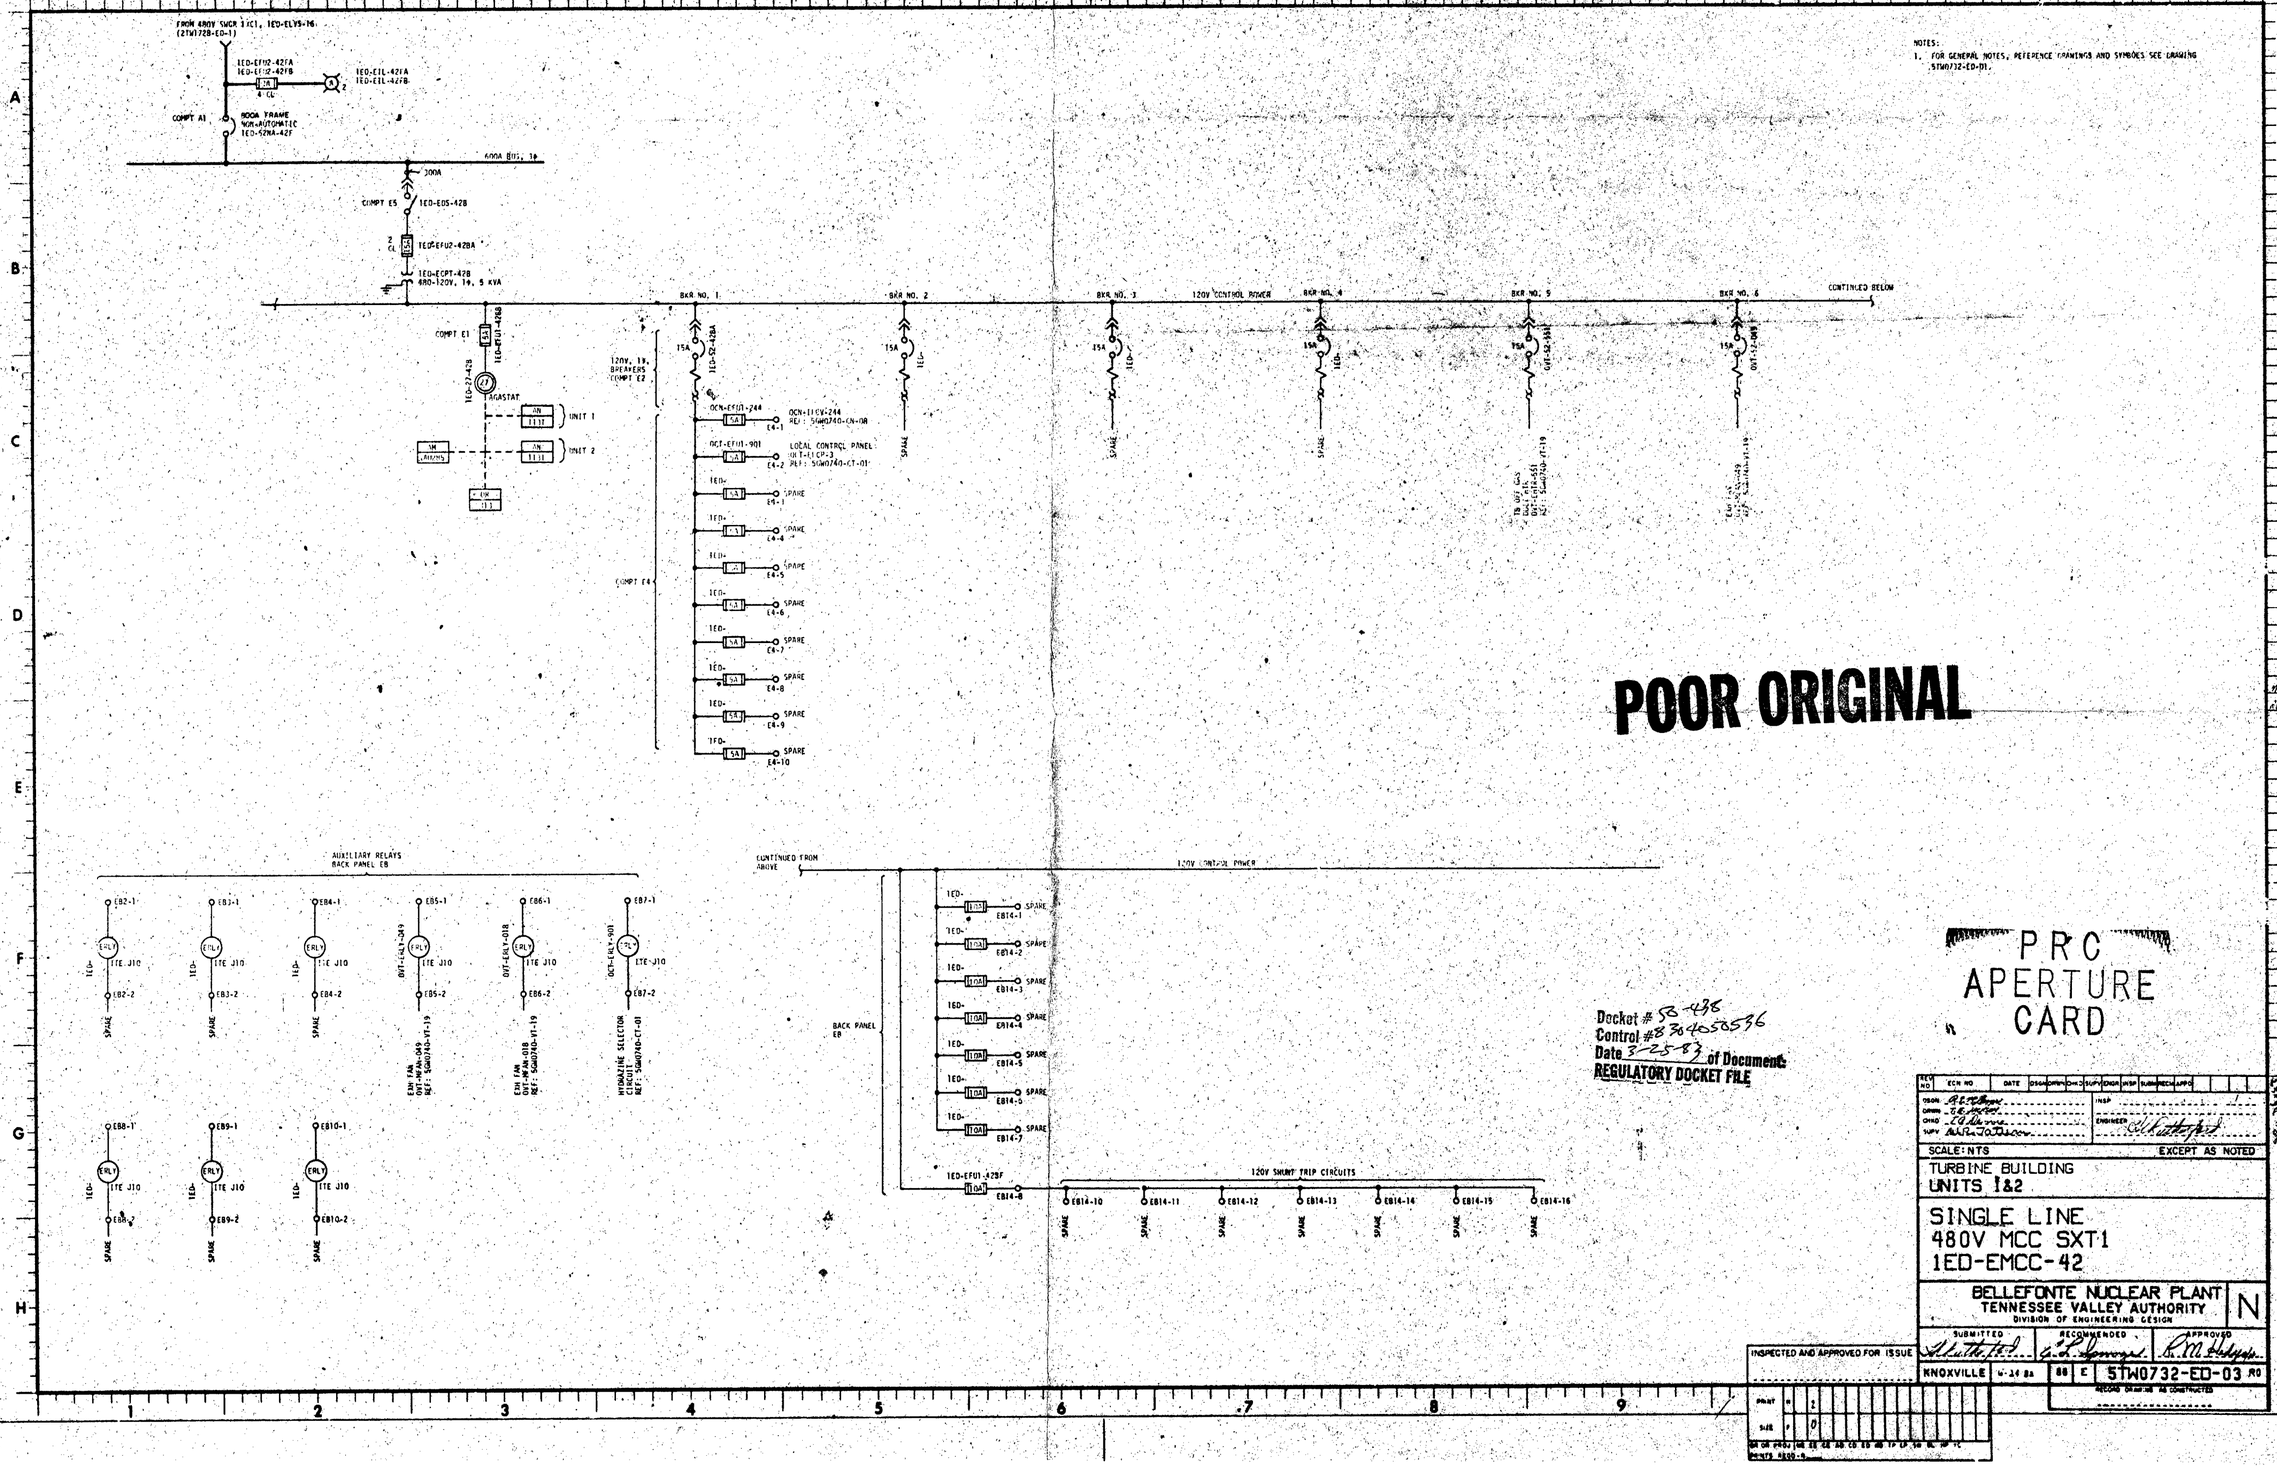

NOTES:
1. FOR GENERAL NOTES, REFERENCE DRAWINGS AND SYMBOLS SEE DRAWING 5TW0732-ED-01.

POOR ORIGINAL

Docket # 50-438
Control # 8304050536
Date 3-25-83 of Document
REGULATORY DOCKET FILE

PRC APERTURE CARD

REV NO	ECN NO	DATE	DSGN	DRWN	CHK'D	SUPV	ENGR	INSP	SUBM	MECH	APPD
DSGN							INSP				
DRWN							ENGINEER				
CHKD											
SUPV											

SCALE: NTS EXCEPT AS NOTED

TURBINE BUILDING
UNITS 1&2

SINGLE LINE
480V MCC SXT1
1ED-EMCC-42

BELLEFONTE NUCLEAR PLANT
TENNESSEE VALLEY AUTHORITY
DIVISION OF ENGINEERING DESIGN

N

SUBMITTED | RECOMMENDED | APPROVED

KNOXVILLE | 4-24-84 | 00 | E | 5TW0732-ED-03 | R0

RECORD DRAWING AS CONSTRUCTED

INSPECTED AND APPROVED FOR ISSUE

PRINT # 1
SUB # 0

QA OR PROJ | NE | EE | CE | AD | CD | ES | MB | TP | LP | SB | BL | JP | TC

DR NTS 4800-9