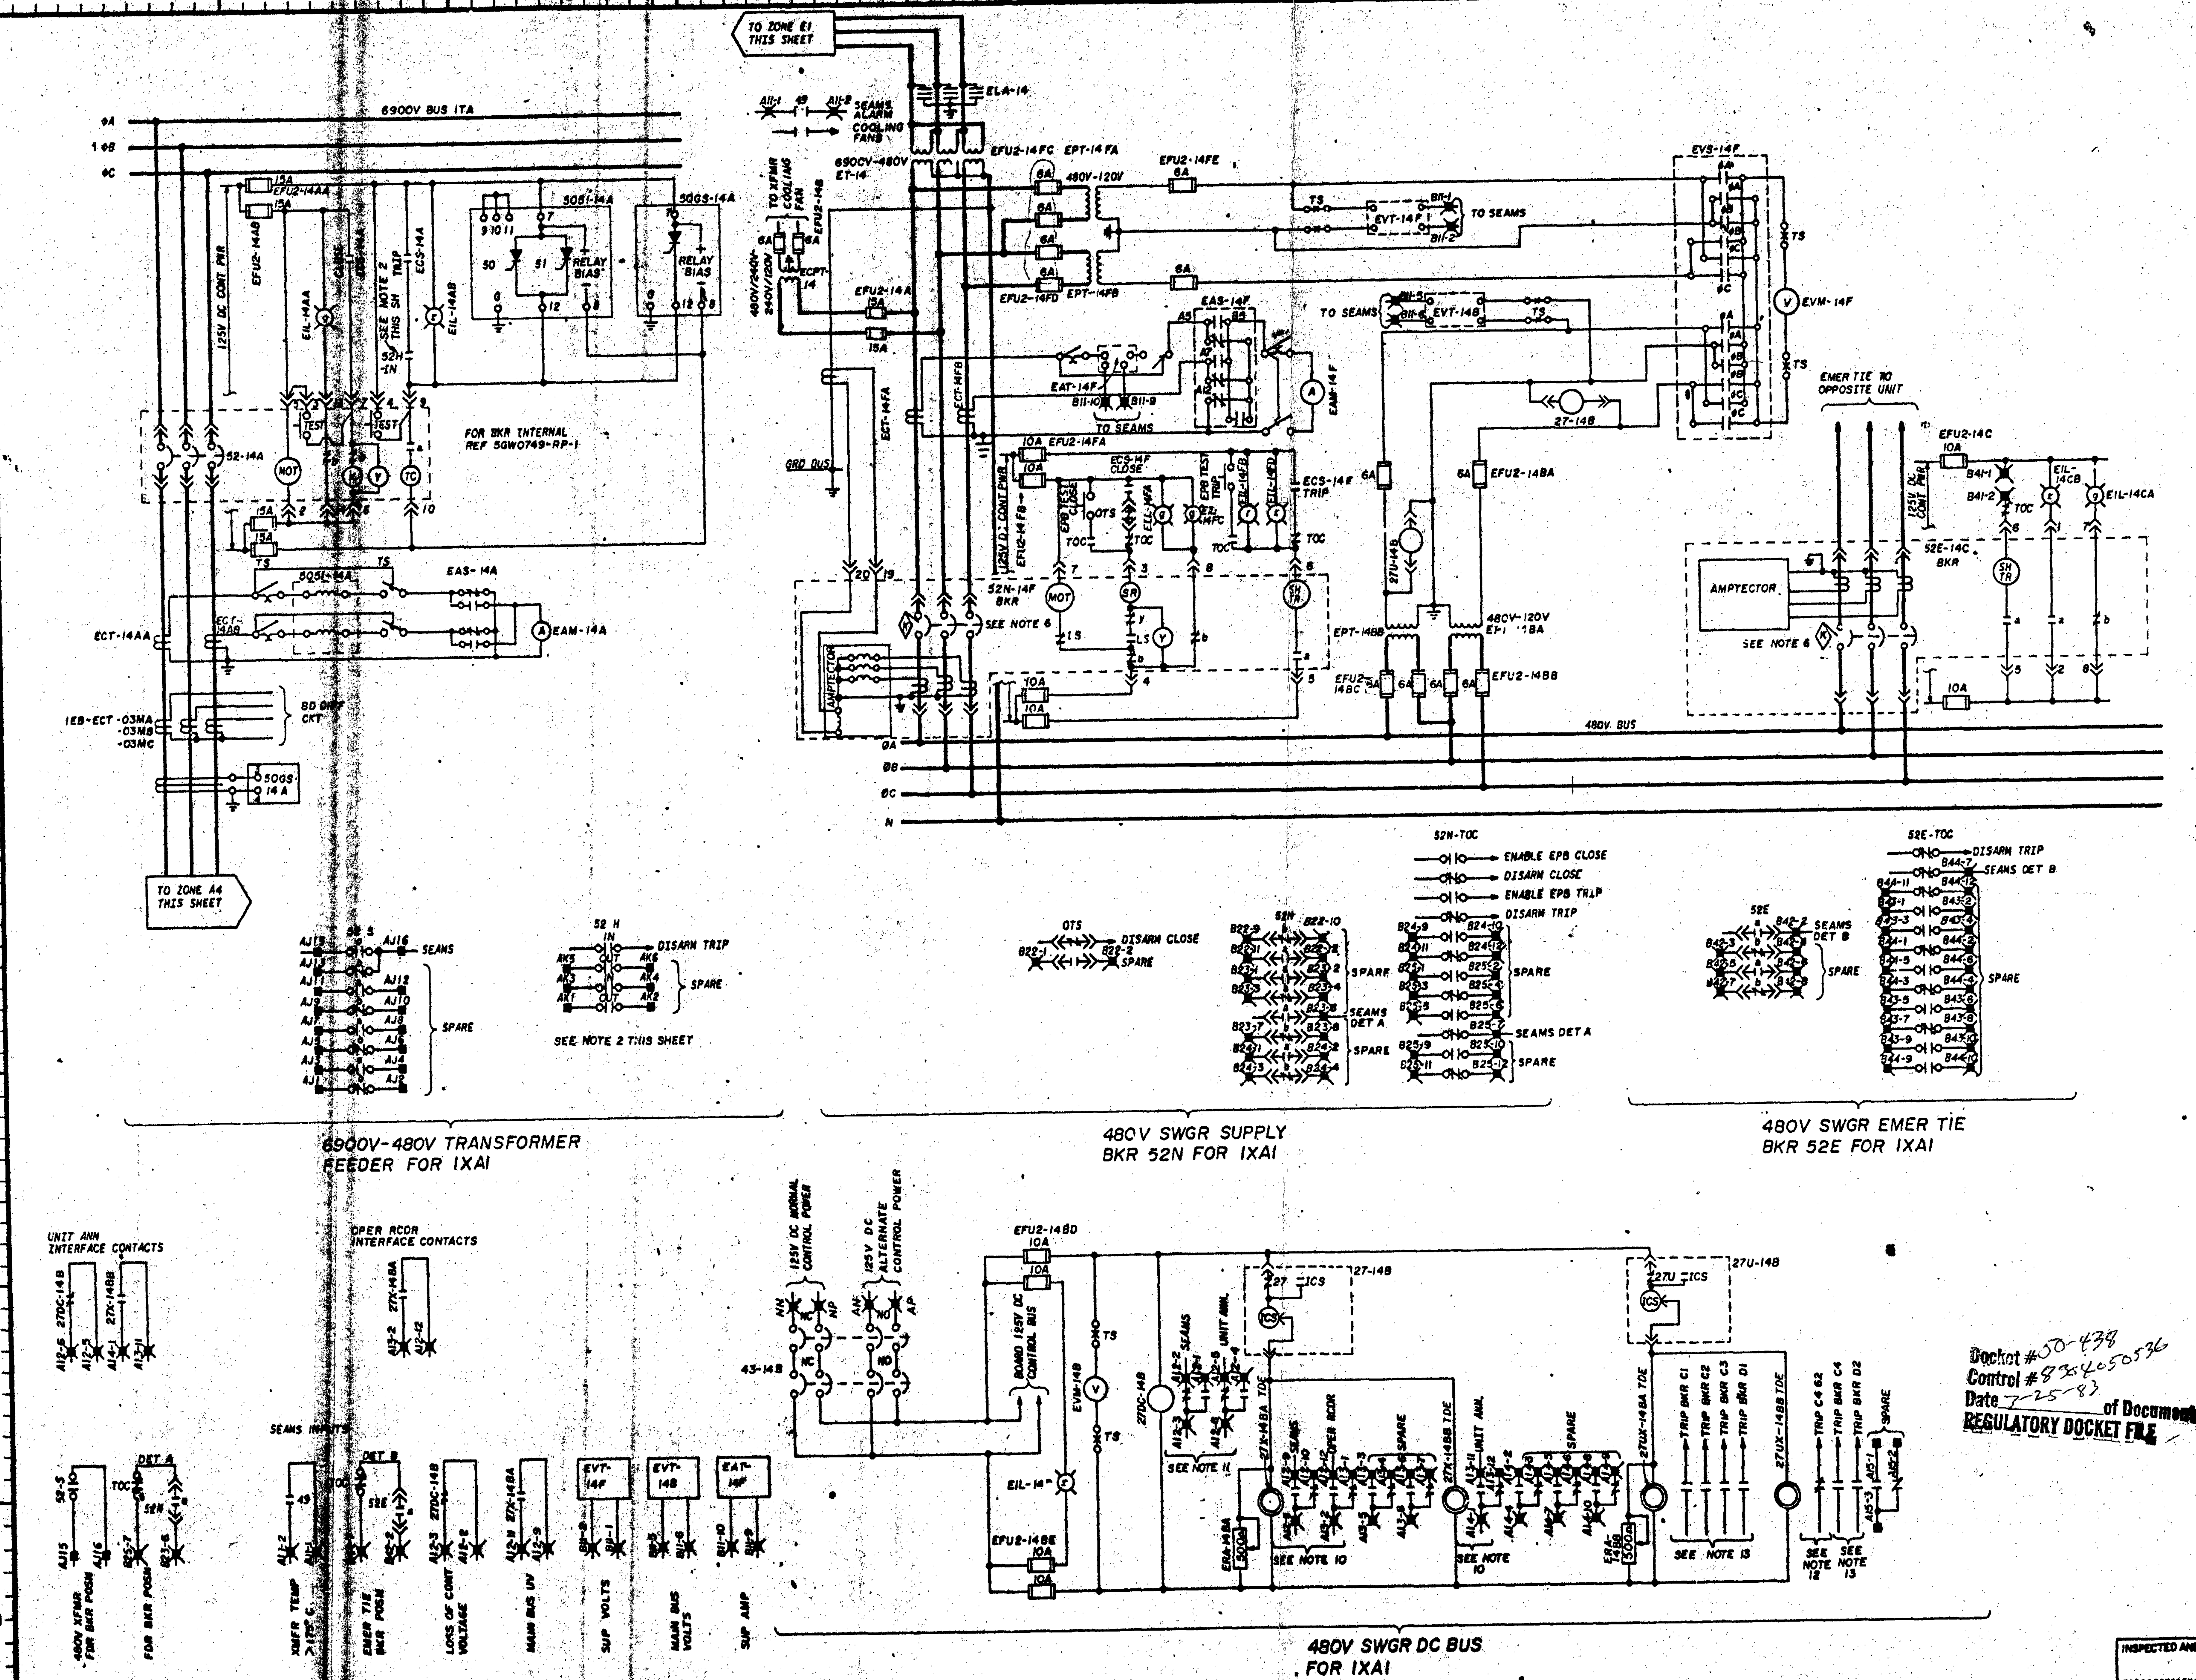

NOTES:
1. FOR SYMBOLS & ADDITIONAL NOTES, SEE SHEET 01.
2. 52H CONTACTS ARE SHOWN IN THEIR OPEN POSITION AND THEIR DESIGNATION IS SUFFIXED WITH -IN OR -OUT TO INDICATE THEY ARE CLOSED WHEN THE BREAKER IS RACKED IN OR RACKED OUT RESPECTIVELY.

SYMBOLS:
✕ — LOW VOLTAGE SWITCHGEAR TERMINAL
■ — MEDIUM VOLTAGE SWITCHGEAR TERMINAL

PRC APERTURE CARD

Docket # 50-438
Control # 8308050536
Date 7-25-83 of Document
REGULATORY DOCKET FILE

REV NO.	ECN NO.	DATE									
3	1133	3-2-81									
REPLACED 3 AMP FUSES WITH 8 AMP FUSES											
2	SI	3-31-79									
CHANGED LOW VOLTAGE SWGR TERM. SYMBOL & MINOR CHANGES.											
1	SI	9-12-78									
ADDED INFORMATION ON TIME DELAY RELAYS, REPOSITION FUSE UNIDS AND GENERAL REVISION PER ECN SI.											

ENGINEER W L Aldredge

SCALE: EXCEPT AS NOTED

GENERAL
UNIT I

SYSTEM SCHEMATIC
480V NORMAL AC AUXILIARY
POWER DISTRIBUTION SYSTEM

BELLEFONTE NUCLEAR PLANT
TENNESSEE VALLEY AUTHORITY
DIVISION OF ENGINEERING DESIGN
N

SUBMITTED W L Aldredge | RECOMMENDED | APPROVED R M Hodges

INSPECTED AND APPROVED FOR ISSUE

KNOXVILLE 1-11-78 | 88 | E | 5GW1740-ED-13 | R3

RECORD DRAWING AS CONSTRUCTED

PRINT | SIZE