NOTES:
1. FOR GENERAL NOTES AND REFERENCE DRAWINGS SEE 5GW1740-EA-01
2. FOR MONITORING SYSTEMS DEVELOPMENT SEE 5GW1740-EA-04

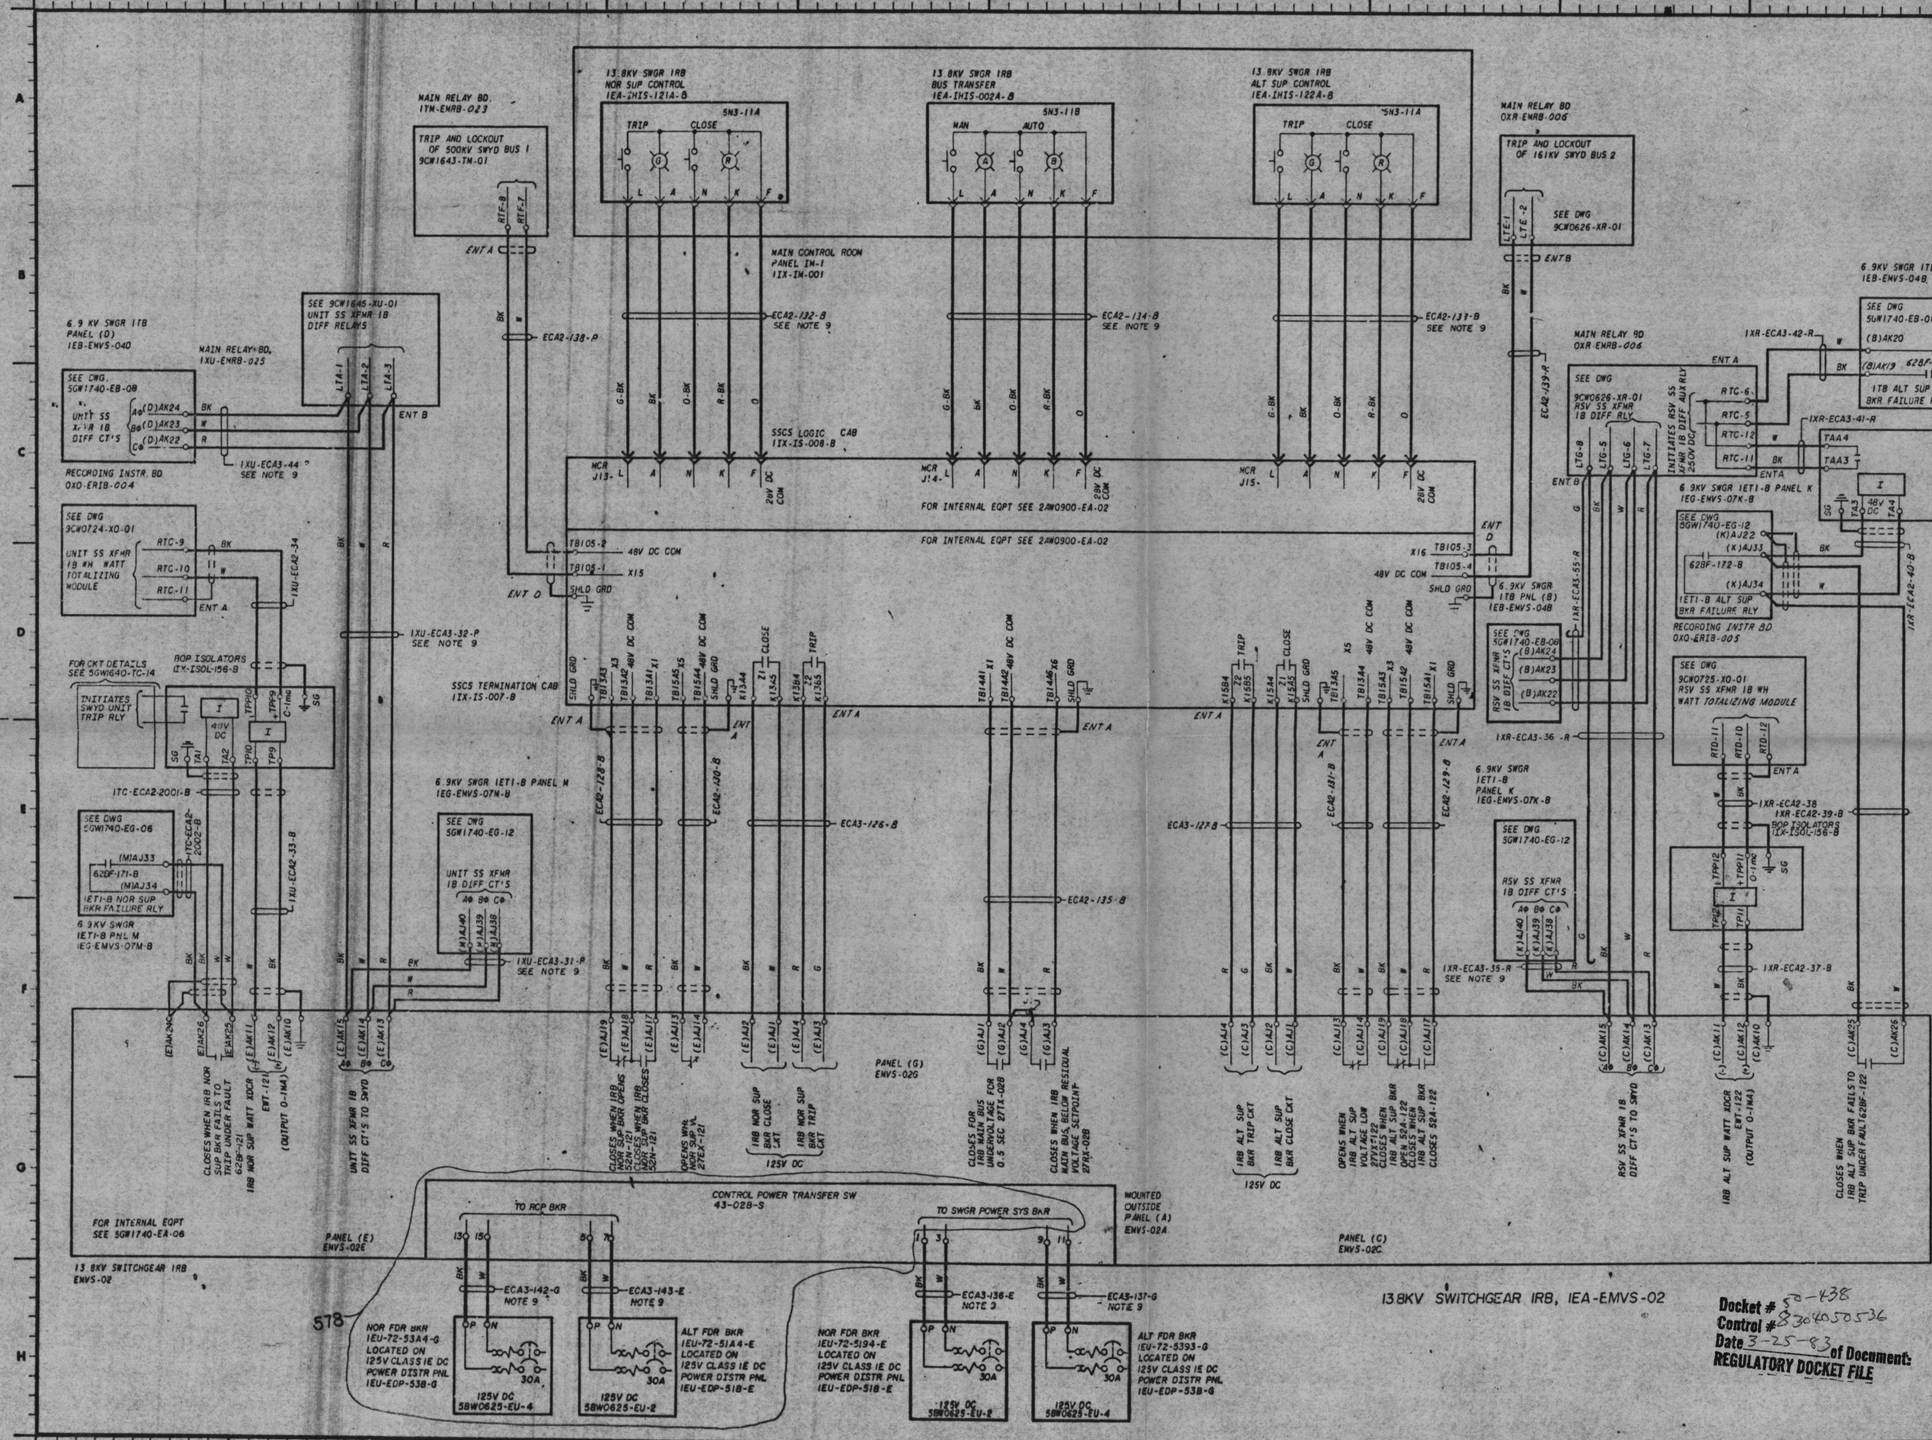

PRC APERTURE CARD

REV	ECN NO.	DATE	DESN	DRWN	CHKD	SUPV	CHNG	INSP	SUBM	RECD	APPD
3	578	5-1-91									
2	S1										
1	403,S1										

3 — PROVIDED SEPARATE 125V DC CONT PWR FOR RCP MOTOR & OTHER SWGR BOARD FUNCTIONS.

2 — ADDED REF DWG NO. & BOP ISOLATOR TERM. PT, REMOVED COL & EL AND MINOR REVISIONS PER ECN S1.

1 — REVISED TERMINAL POINTS AND CABLE ENT OF MN RLY BD PER ECN 403 ADD ISOLATOR NOTATION AND MINOR REVISIONS PER S1.

DESN J.C. HILL
DRWN Hancock L.W. JACKSON
CHKD R.D. WASSEY
SUPV W.R. TATUM
INSP
ENGINEER W.E. Aldridge
SCALE: EXCEPT AS NOTED

GENERAL
UNIT 1

SYSTEM SCHEMATIC 13.8KV. NORMAL AC AUX POWER DISTRIBUTION SYSTEM

BELLEFONTE NUCLEAR PLANT
TENNESSEE VALLEY AUTHORITY
DIVISION OF ENGINEERING DESIGN

Q

SUBMITTED	RECOMMENDED	APPROVED
W.E. Aldridge	J.S. Lawrence	R.M. Hodges

KNOXVILLE 9-13-77 88E 5GW1740-EA-03 R3

RECORD DRAWING AS CONSTRUCTED

THIS DRAWING IS UNDER CONFIGURATION CONTROL

Docket # 50-438
Control # 830405036
Date 3-25-83
of Document:
REGULATORY DOCKET FILE