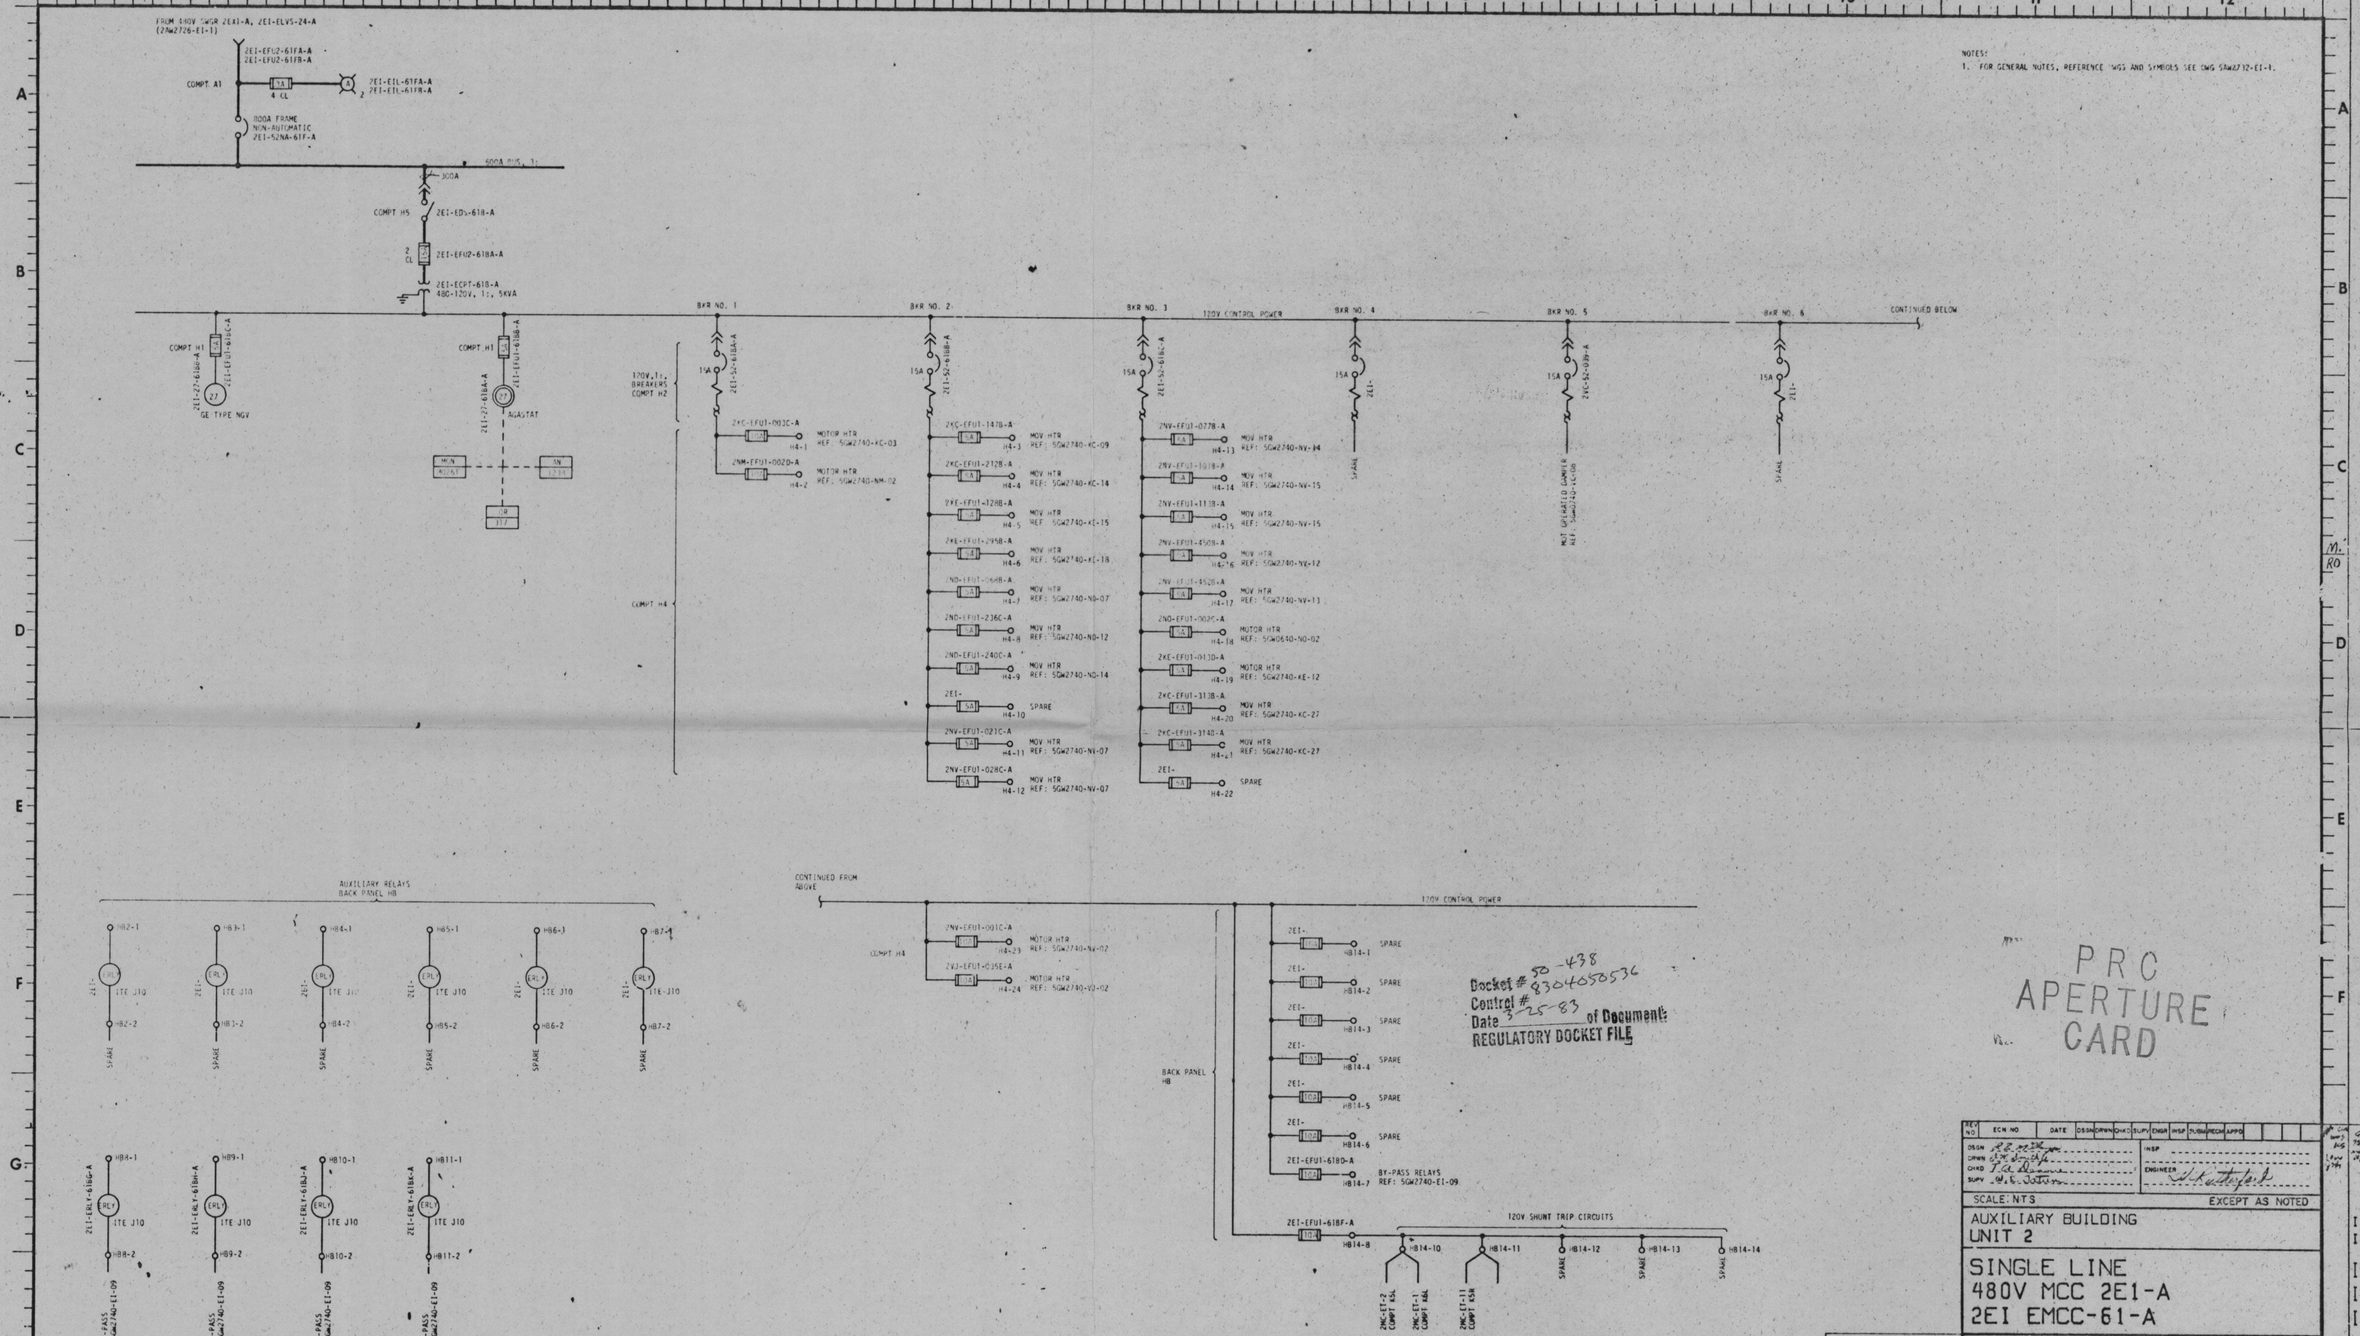

NOTES:
1. FOR GENERAL NOTES, REFERENCE DWGS AND SYMBOLS SEE DWG 5AW2732-EI-1.

Docket # 50-438
Control # 8304050536
Date 3-25-83 of Document:
REGULATORY DOCKET FILE

PRC APERTURE CARD

REV NO	ECN NO	DATE	DSGN	DRWN	CHKD	SUPV	ENGR	INSP	PLBM	RECM	APPD

DSGN
DRWN
CHKD
SUPV
INSP
ENGINEER

SCALE: NTS — EXCEPT AS NOTED

AUXILIARY BUILDING
UNIT 2

SINGLE LINE
480V MCC 2E1-A
2EI EMCC-61-A

BELLEFONTE NUCLEAR PLANT
TENNESSEE VALLEY AUTHORITY
DIVISION OF ENGINEERING DESIGN

Q

REVIEWED
EEB. Full Checklist/pre
CEB.
MEB.
NEB.

INSPECTED AND APPROVED FOR ISSUE

SUBMITTED — RECOMMENDED — APPROVED

KNOXVILLE 9-30-83

98 | E | 5AW2732-EI-03 | R0

RECORD DRAWING AS CONSTRUCTED