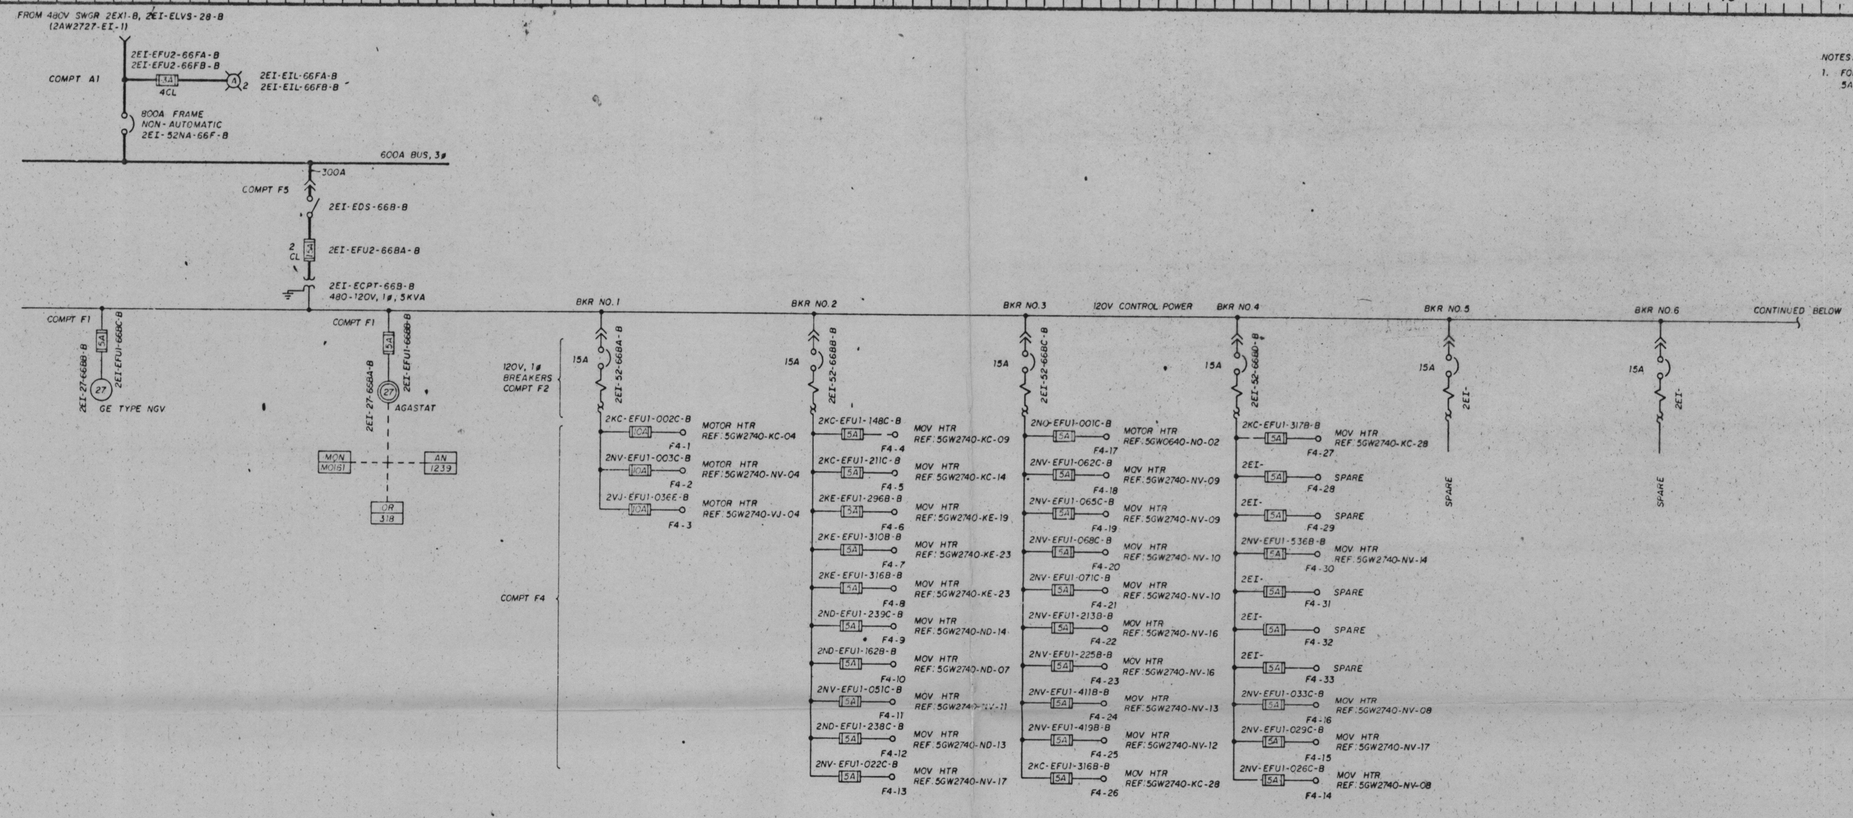

NOTES:

1. FOR GENERAL NOTES, REFERENCE DWGS AND SYMBOLS SEE DWG 5AW2733-EI-1.

Docket # 50-438
Control # 8304050036
Date 3-25-83 of Document:
REGULATORY DOCKET FILE

PRC APERTURE CARD

REV NO	ECN NO	DATE	DSGN	DRWN	CHKD	SUPV	ENGR	INSP	SUBM	RECM	APPD

DSGN R.S. Wilson
DRWN J.T. Smith
CHKD J.A. Brown
SUPV N. Winston
INSP
ENGINEER W. Wittenfeld

SCALE: NTS — EXCEPT AS NOTED

AUXILIARY BUILDING
UNIT 2

SINGLE LINE
480V MCC 2E1-B
2EI-EMCC-66-B

REVIEWED
EEB E.W. Chandler/JWK
CEB
MEB
NEB

INSPECTED AND APPROVED FOR ISSUE

BELLEFONTE NUCLEAR PLANT
TENNESSEE VALLEY AUTHORITY
DIVISION OF ENGINEERING DESIGN

Q

SUBMITTED W. Wittenfeld
RECOMMENDED R.L. Spangler
APPROVED G.M. Hickman

KNOXVILLE 1-20-82 | 88 | E | 5AW2733-EI-03 RO

RECORD DRAWING AS CONSTRUCTED

PRINT
SIZE