NOTES:

1. FOR GENERAL NOTES, REFERENCE DWGS AND SYMBOLS SEE DWG 5AW2735-EI-1.

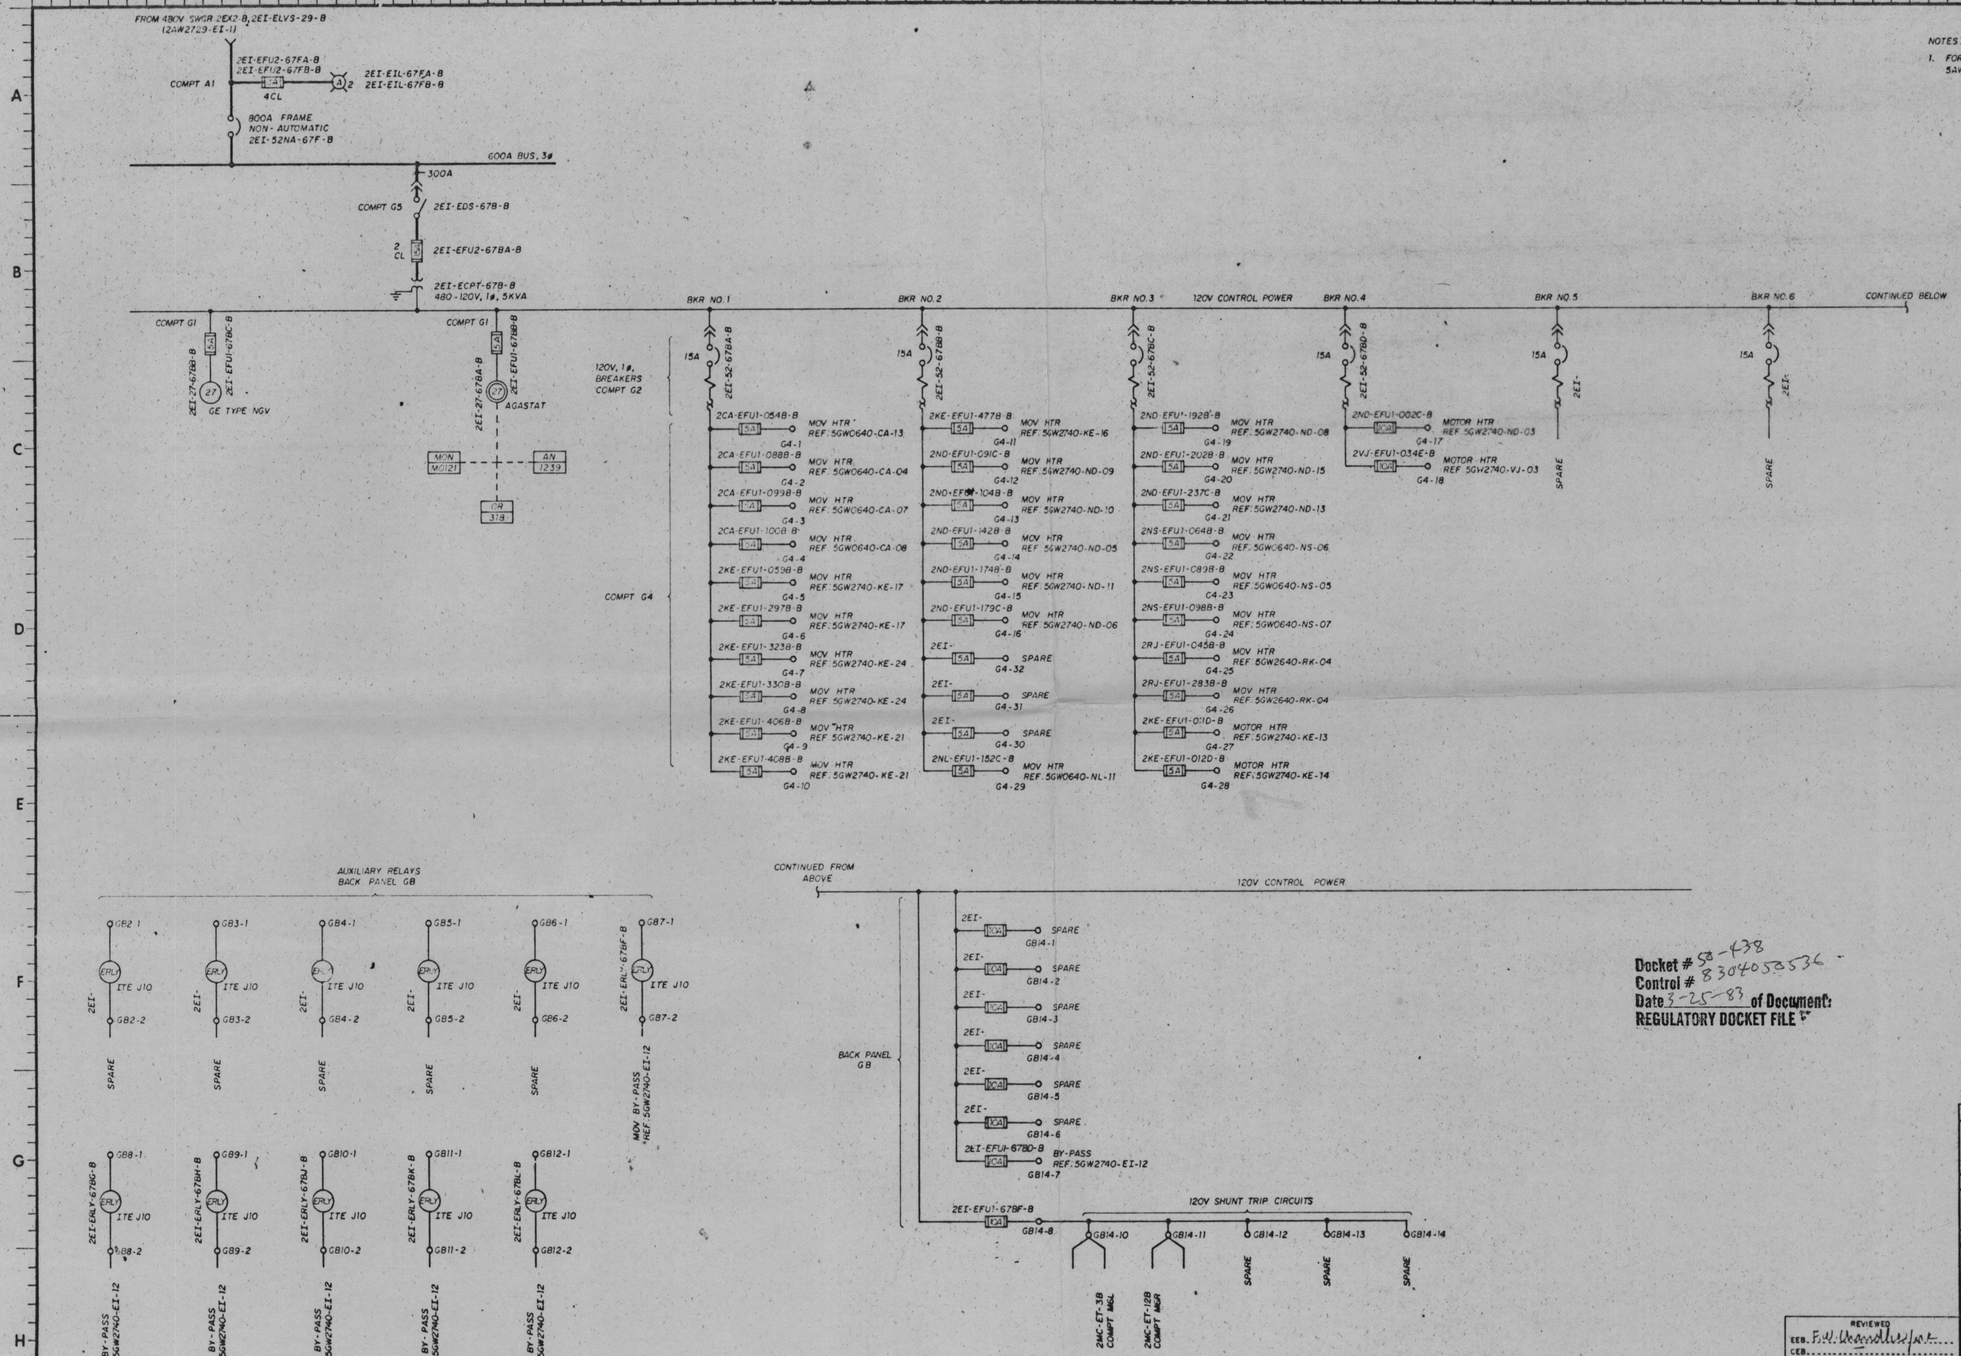

Docket # 50-438
Control # 8304050536
Date 3-25-83 of Document:
REGULATORY DOCKET FILE

PRC APERTURE CARD

REV NO	ECN NO	DATE	DSGN	DRWN	CHK	SUP	CHGR	INSP	SUBM	RECM	APPD

DSGN R.S. Wagner
DRWN J.F. Lindsey
CHKD T.G. Wagner
SUPV W.R. Gates
INSP
ENGINEER

SCALE: NTS EXCEPT AS NOTED

AUXILIARY BUILDING
UNIT 2

SINGLE LINE
480V MCC 2E2-B
2EI-EMCC-67-B

REVIEWED
EEB. F.W. Wanschlies/jpt
CEB.
MEB.
NEB.
INSPECTED AND APPROVED FOR ISSUE

BELLEFONTE NUCLEAR PLANT
TENNESSEE VALLEY AUTHORITY
DIVISION OF ENGINEERING DESIGN

Q

SUBMITTED W.R. Gates | RECOMMENDED J.R. Sponsler | APPROVED R.M. Hodges

KNOXVILLE 7-20-82 | 00 | E | 5AW2735-EI-03 | R0

RECORD DRAWING AS CONSTRUCTED

PRINT H
SIZE F