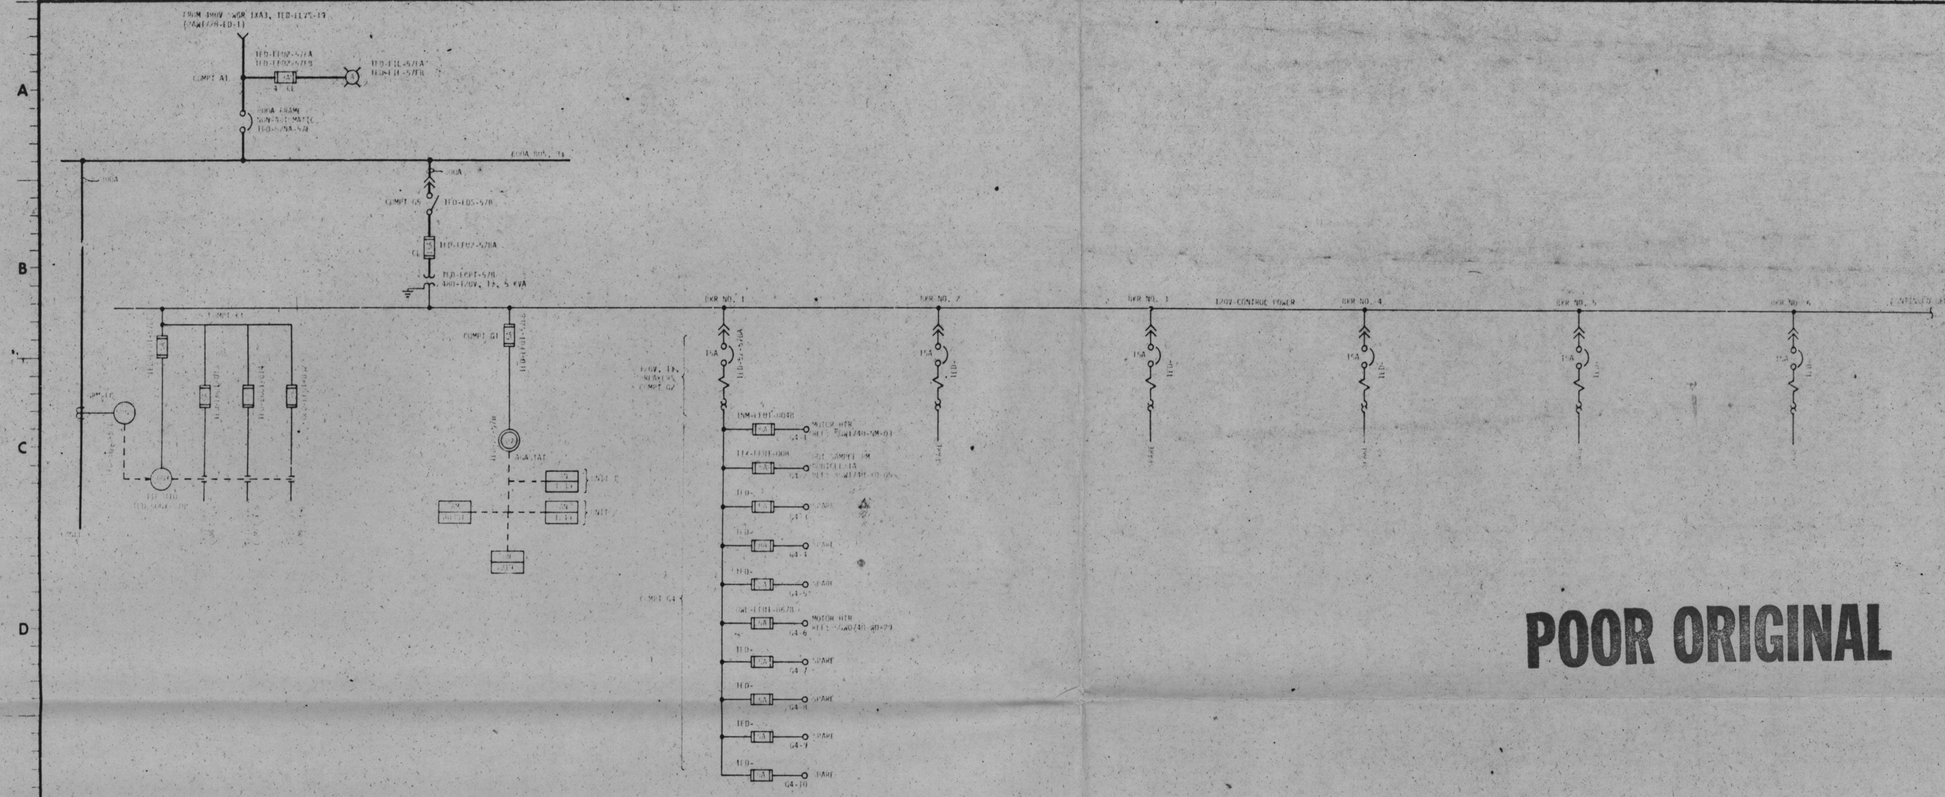

POOR ORIGINAL

PRC APERTURE CARD

Docket # 50-438
Control # 8309050536
Date 7-25-83 of Document:
REGULATORY DOCKET FILE

AUXILIARY BUILDING
UNIT 1

SINGLE LINE
480V MCC SXF3
1ED-EMCC-57

SCALE: NTS EXCEPT AS NOTED

BELLEFONTE NUCLEAR PLANT
TENNESSEE VALLEY AUTHORITY
DIVISION OF ENGINEERING DESIGN

N

SUBMITTED | RECOMMENDED | APPROVED

KNOXVILLE 8-4-82

88 E SAW0734-ED-03 R0

INSPECTED AND APPROVED FOR ISSUE

RECORD DRAWING AS CONSTRUCTED