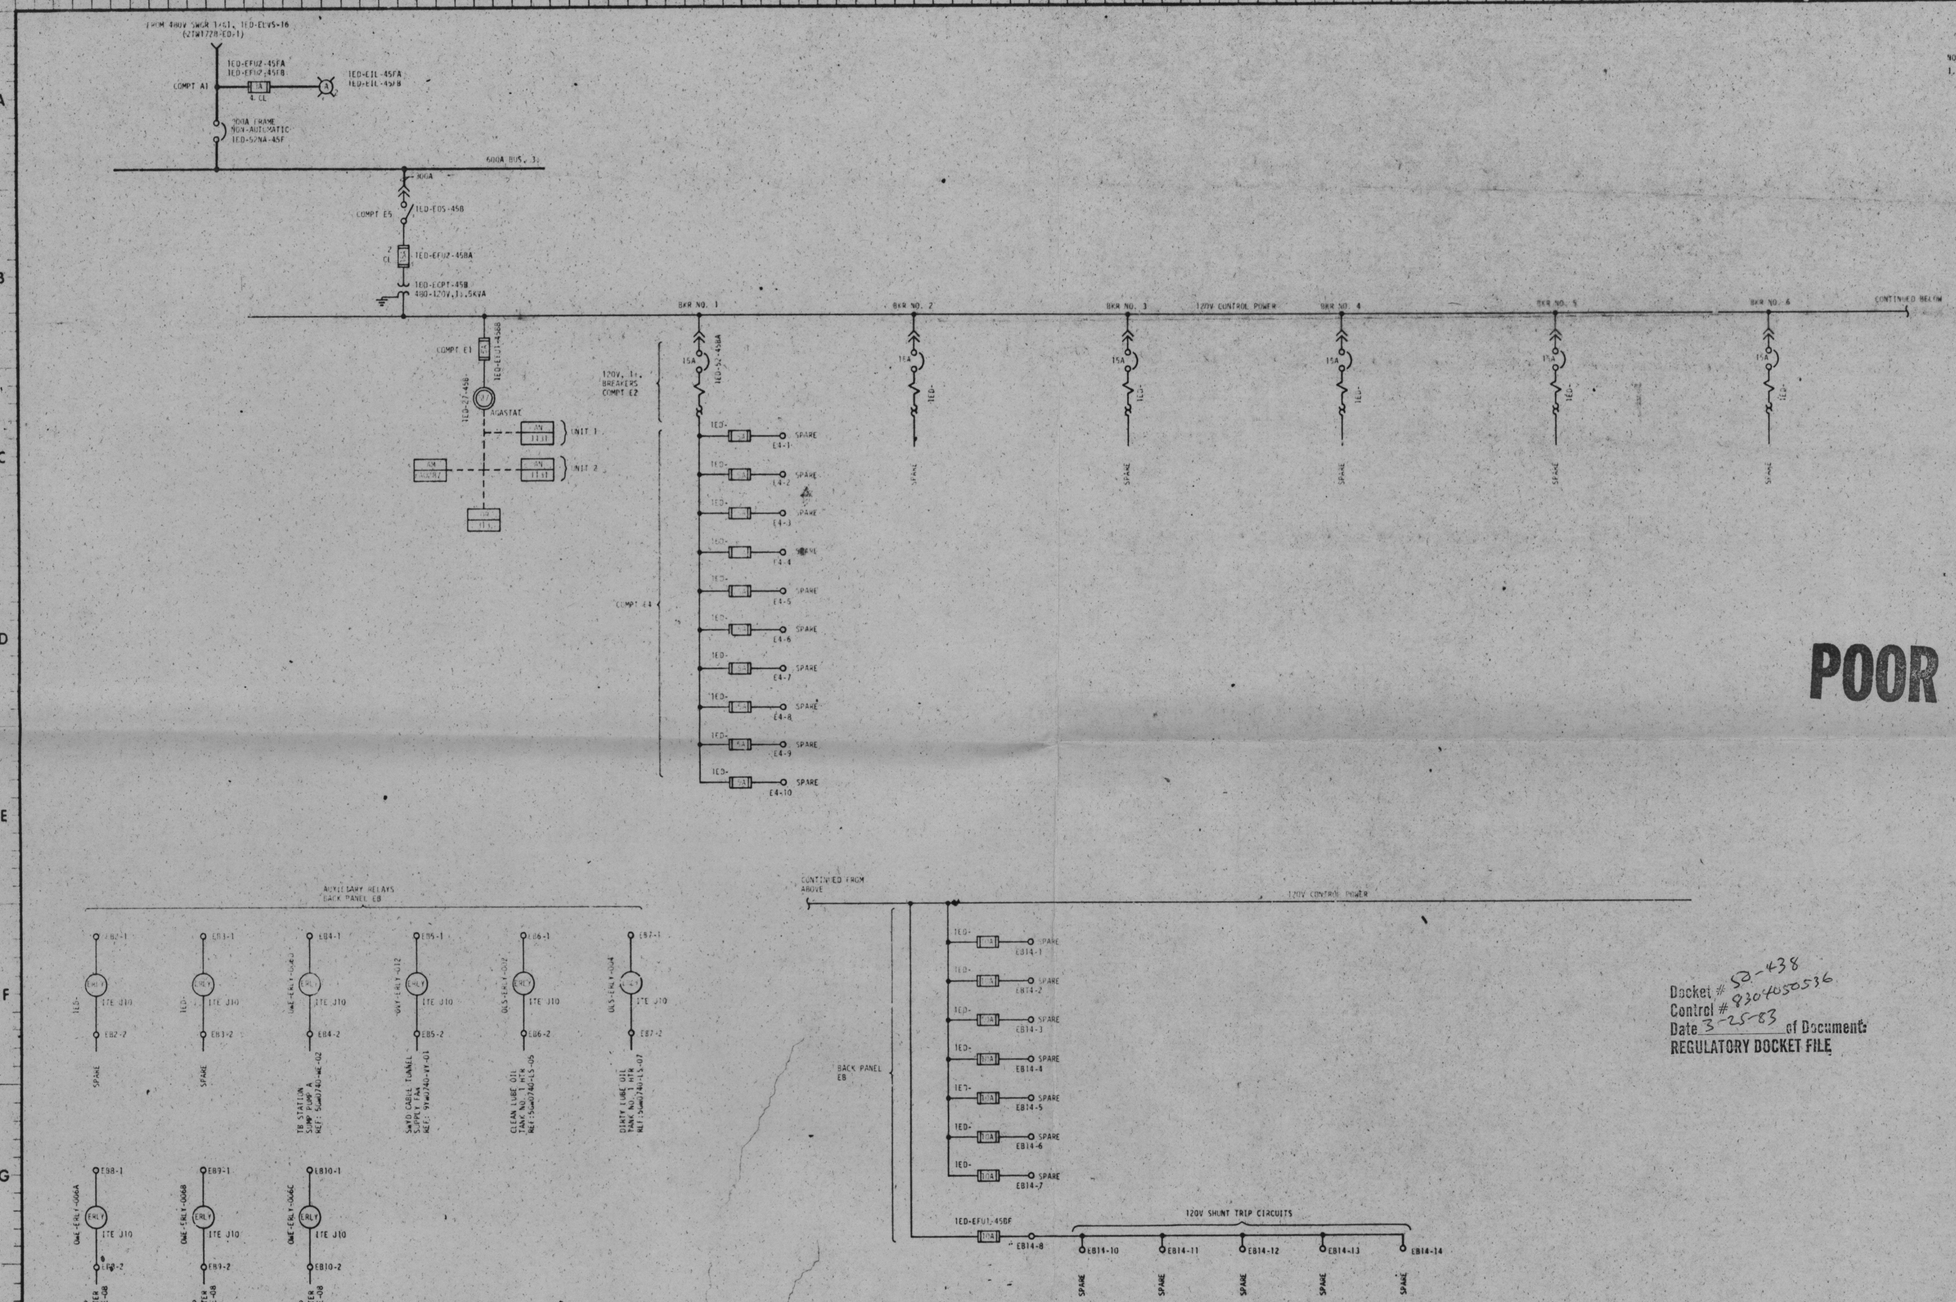

NOTES:
1. FOR GENERAL NOTES, REFERENCE DWGS AND SYMBOLS SEE DWG STW0735-ED-01.

POOR ORIGINAL

Docket # 50-438
Control # 8304050536
Date 3-25-83 of Documents
REGULATORY DOCKET FILE

PRC APERTURE CARD

REV NO	ECN NO	DATE	DSGN	DRWN	CHKD	SUPV	CHGN	INSP	SUBM	RECM	APPD

DSGN R.E. Hilliard
DRWN R.A. Hibbitt
CHKD T.A. Thomas
SUPV W.H. Watts
INSP
ENGINEER

SCALE: NTS — EXCEPT AS NOTED

TURBINE BUILDING
UNITS 1&2

SINGLE LINE
480V MCC SXT4
1ED-EMCC-45

BELLEFONTE NUCLEAR PLANT
TENNESSEE VALLEY AUTHORITY
DIVISION OF ENGINEERING DESIGN
N

SUBMITTED — RECOMMENDED — APPROVED

KNOXVILLE | 4-29-82 | 88 | E | STW0735-ED-03 | R0

RECORD DRAWING AS CONSTRUCTED

INSPECTED AND APPROVED FOR ISSUE

PRINT H Z
SIZE V D