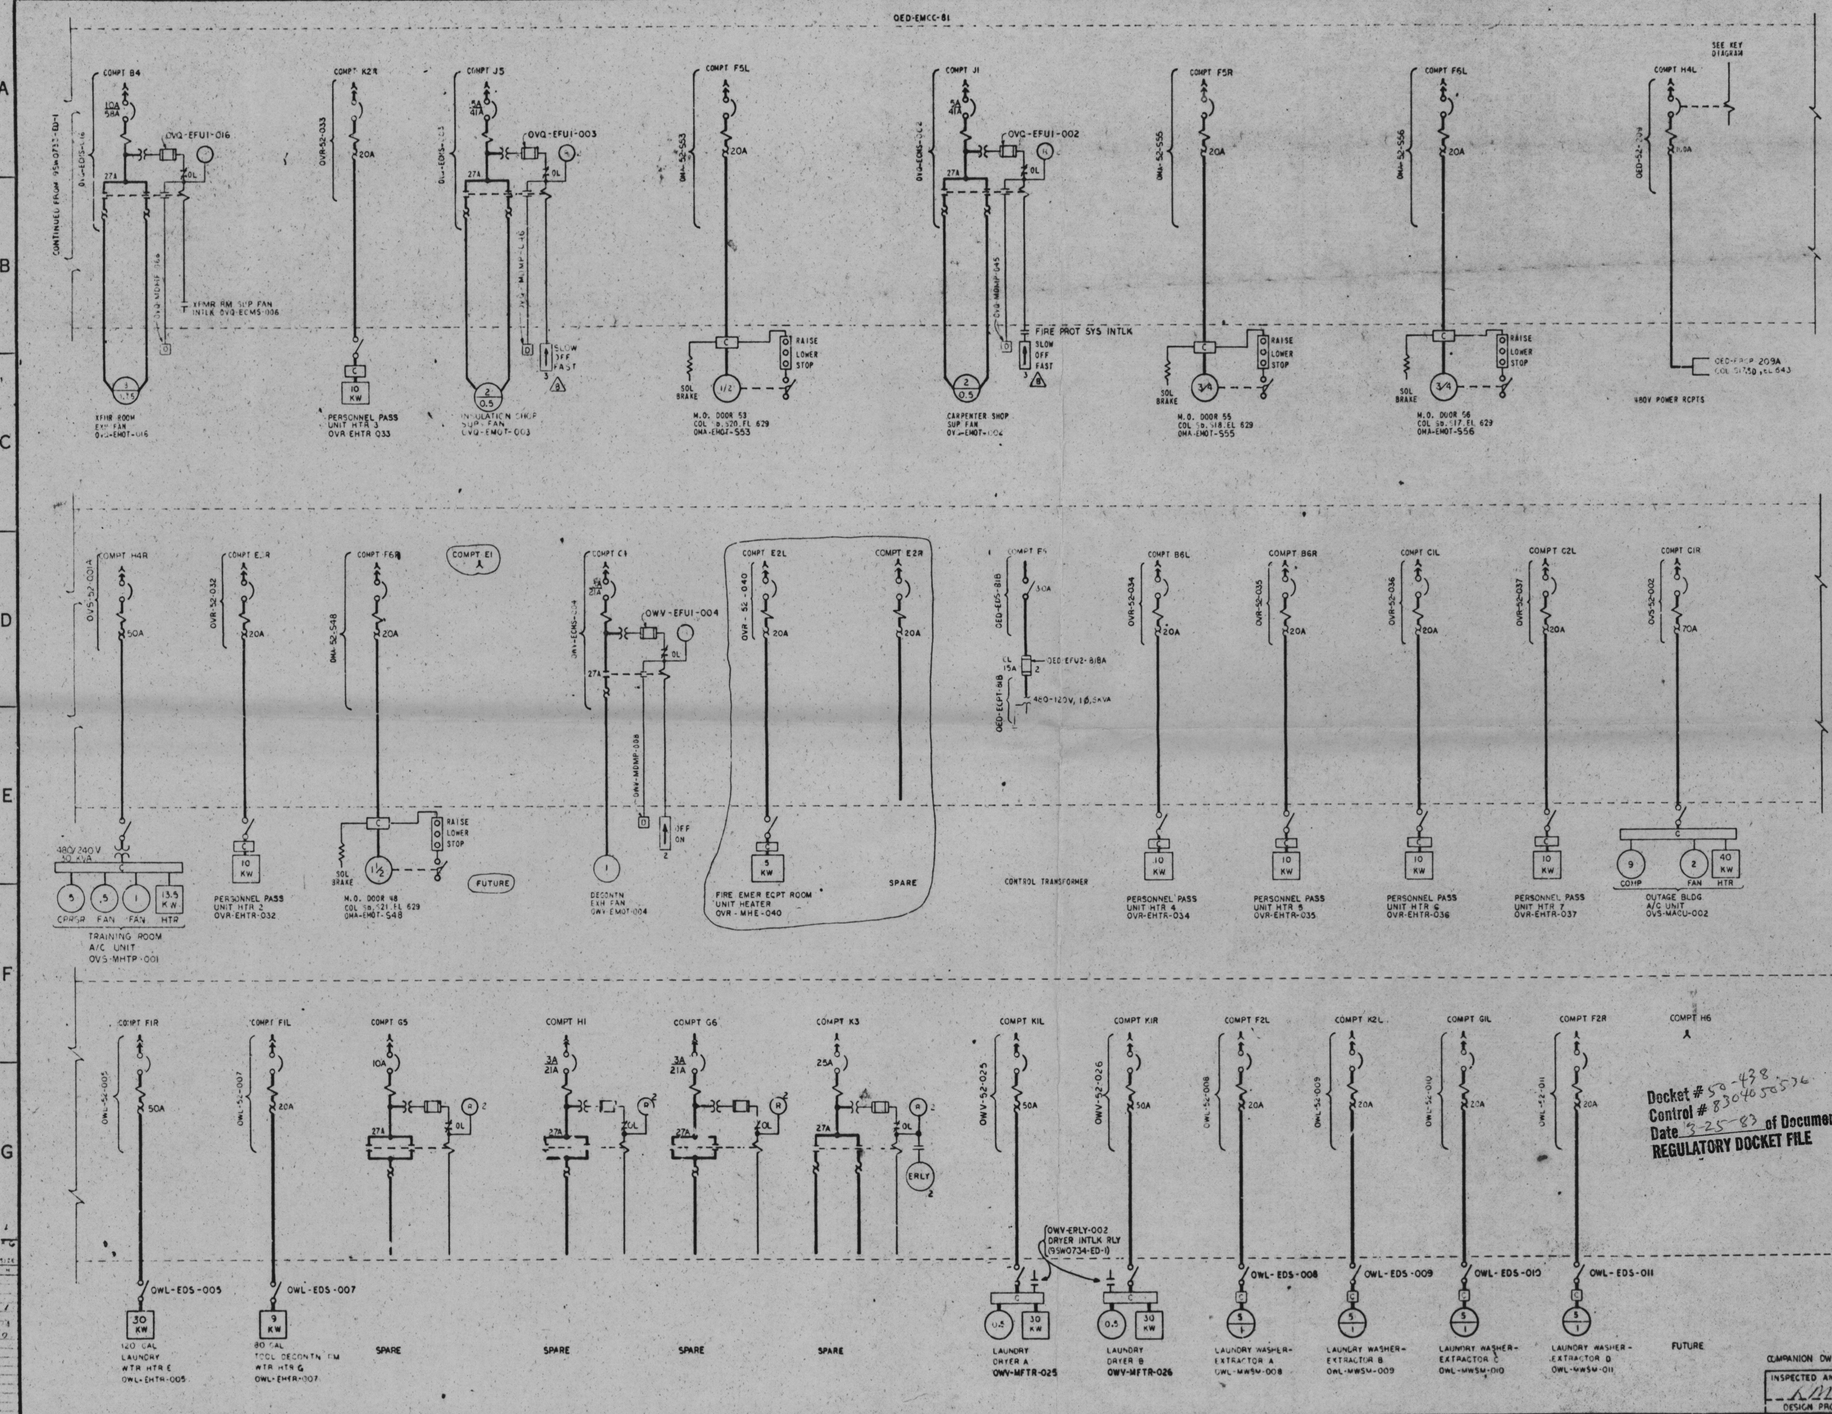

PRC APERTURE CARD

NO.	ECN NO.	DATE	DSGN	DFTMN	CHKD	SUPV	ENGR	INSP	SUBM	RECM	APPR
6	1941	11-24-82	KMH	JT							
	ECN-1341 ADD UNIT HTR TO FIRE EMERGENCY EQPT ROOM										
5	1104										
	ECN-704 ADD SEWAGE SYS DUPLEX SUMP PUMPS										
4	1833-S1	12-7-80	TEWM	RLC							
	ECN-833 ADD AIR CONDITIONER TO RECEPTION AREA AND TRAINING ROOM ECN-S1 MINOR CHANGES										
3	571	1-7-77	TLB	JCF							
	ECN-571, CHGS DUE TO MFRR INFO										
2	334-S1	1-7-74	WS	TMB							
	ECN-S1 MINOR CHANGES										
	UPDATE TO SHOW LATEST COMPT. ASSIGNMENTS & VENDOR AS CONST. CHGS. MINOR CHGS										
1	150-108	10-22-74	DAS	TMB							
	ECN-60 REVISE TO SHOW CHANGES IN GENERAL ARRANGEMENT & ELEV DWG & REV DWG NOS.										
	ECN-82 REVISE TO SHOW LATEST BUILDING DESIGN REQUIREMENTS. ECN-108 REVISE TO SHOW LATEST FAN HP RATINGS, DWG NOS. & BKR TRIP SETTINGS.										

DSGN S. BRIDGES — INSP
DRWN — ENGINEER
CHKD
SUPV

SERVICE AND OFFICE BUILDING
UNITS 1 & 2

SINGLE LINE
480V MCC SXW
OED-EMCC-81

BELLEFONTE NUCLEAR PLANT
TENNESSEE VALLEY AUTHORITY
DIVISION OF ENGINEERING DESIGN

N

SUBMITTED	RECOMMENDED	APPROVED

KNOXVILLE 12-20-74 | 88 | E | 9SW0733-ED-2 A6

RECORD DRAWING AS CONSTRUCTED

COMPANION DWG: 9SW0733-ED-1

INSPECTED AND APPROVED FOR ISSUE
DESIGN PROJECT MANAGER