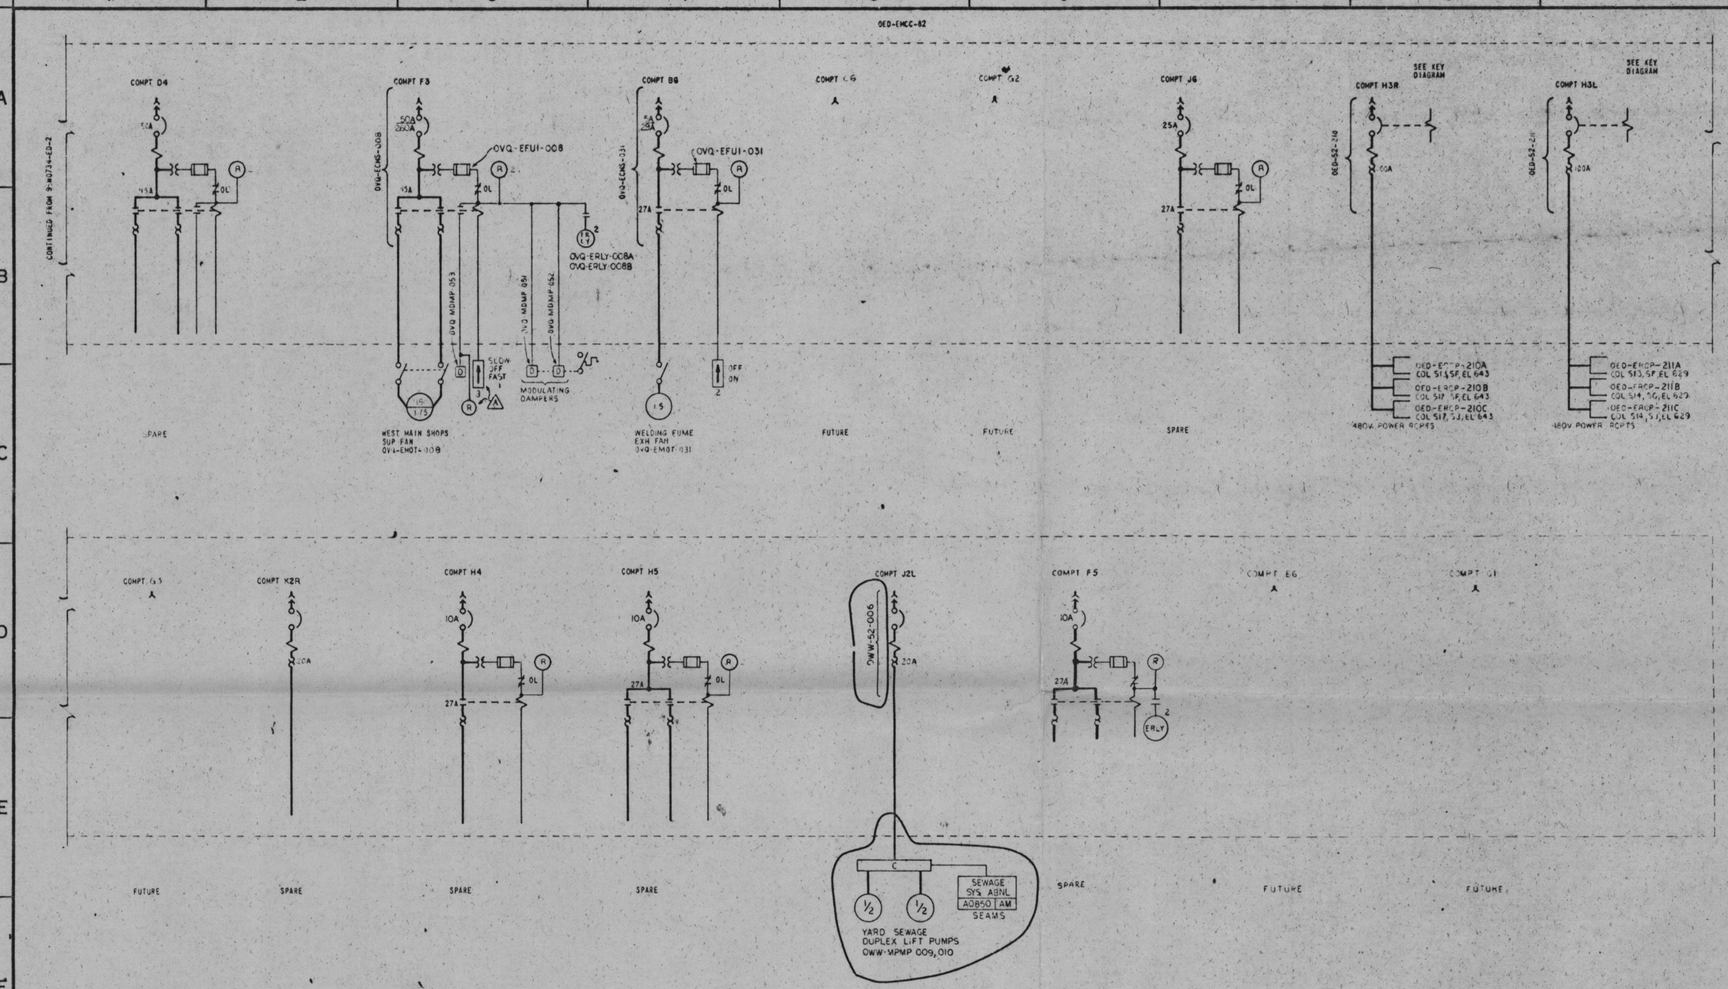

FOR LIST OF NOTES AND REFERENCE DRAWINGS SEE 9SW0734-ED-01.

PRC APERTURE CARD

Docket # 50-438
Control # 8304050536
Date 3-25-83 of Document:
REGULATORY DOCKET FILE

3	704										
ECN-704 ADDED SEWAGE SYSTEM DUPLEX SEWAGE LIFT PUMPS											
2	334,51										
ECN-51 MINOR CHANGES UPDATE TO SHOW LATEST COMPT. ASSIGNMENTS & VENDOR AS CONSTRUCTED CHANGES.											
1	60,108										
ECN 60 REV TO SHOW CHGS IN GENERAL ARRANGEMENT OF SHOPS OWNS & KEY UNID NOS. ECN 108 REVISE TO SHOW LATEST FAN HP RATINGS, UNID NOS & BNK TRIP SETTINGS.											
REV NO.	ECN NO.	DATE	DSGN	DRWN	CHKD	SUPV	ENGR	INSP	SUBM	RECM	APPR

DSGN T. A. DENNIE
DRWN R.W. MANLEY
CHKD W.H. PERRY
SUPV J.E. CLANDFORD
INSP
ENGINEER

SERVICE & OFFICE BUILDING
UNITS 1 & 2

SINGLE LINE
480V MCC SXY
OED-EMCC-82

BELLEFONTE NUCLEAR PLANT
TENNESSEE VALLEY AUTHORITY
DIVISION OF ENGINEERING DESIGN
N

SUBMITTED	RECOMMENDED	APPROVED
Robert F. Hewitt	R.H. Herndon	John E. Holladay

COMPANION DWGS: 9SW0734-ED-1, 2

INSPECTED AND APPROVED FOR ISSUE
R.M. Hodges
DESIGN PROJECT MANAGER

KNOXVILLE 12-20-74 | 88 | E | 9SW0734-ED-3 | R.S.

RECORD DRAWING AS CONSTRUCTED