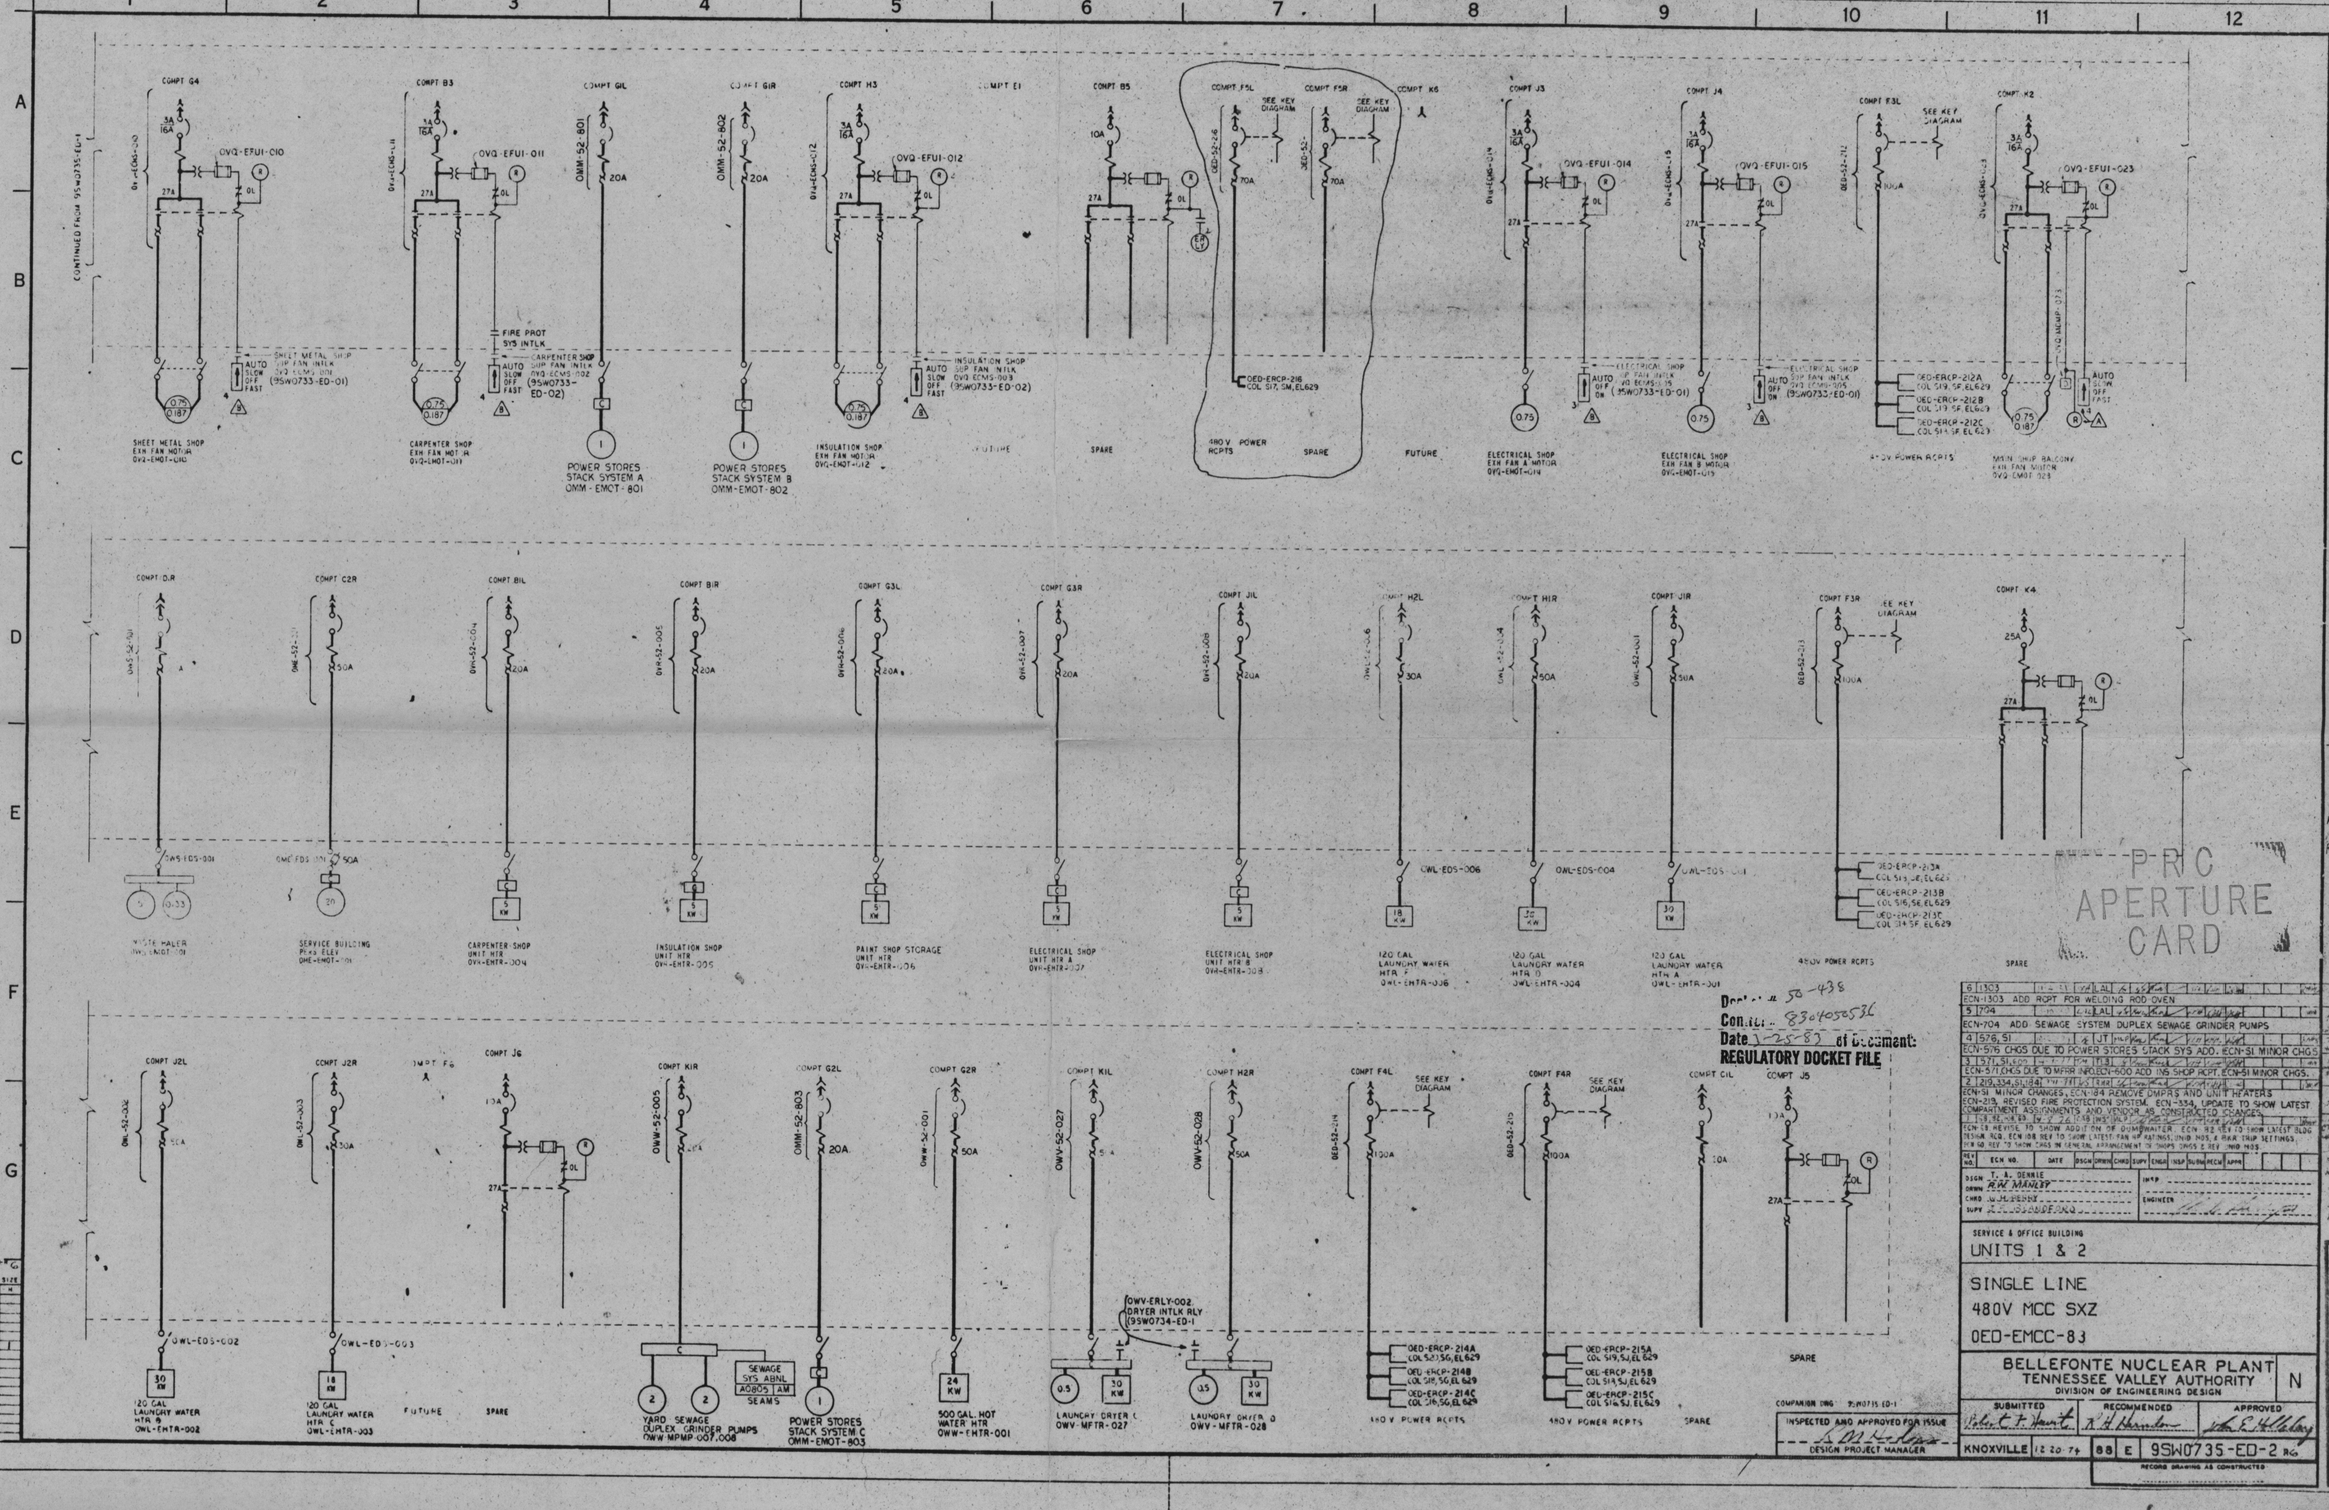

PRC APERTURE CARD

Docket # 50-438
Control # 8304050536
Date 3-25-83 of Document:
REGULATORY DOCKET FILE

REV NO.	ECN NO.	DATE	DSGN	DRWN	CHKD	SUPV	ENGR	INSP	SUBM	RECM	APPR
6	1303										
ECN-1303 ADD RCPT FOR WELDING ROD OVEN											
5	704										
ECN-704 ADD SEWAGE SYSTEM DUPLEX SEWAGE GRINDER PUMPS											
4	576, 51										
ECN-576 CHGS DUE TO POWER STORES STACK SYS ADD. ECN-51 MINOR CHGS											
3	571, 51, 600										
ECN-571 CHGS DUE TO MFRR INFO. ECN-600 ADD INS SHOP RCPT. ECN-51 MINOR CHGS.											
2	219, 334, 51, 184										
ECN-51 MINOR CHANGES, ECN-184 REMOVE DMPRS AND UNIT HEATERS ECN-219, REVISED FIRE PROTECTION SYSTEM. ECN-334, UPDATE TO SHOW LATEST COMPARTMENT ASSIGNMENTS AND VENDOR AS CONSTRUCTED CHANGES.											
1	58, 82, 108, 89										
ECN-58 REVISE TO SHOW ADDITION OF DUMPWATER. ECN-82 REV TO SHOW LATEST BLDG DESIGN REQ. ECN-108 REV TO SHOW LATEST FAN HP RATINGS, UNIT NOS. & RMR TRIP SETTINGS. ECN-89 REV TO SHOW CHGS IN GENERAL ARRANGEMENT OF DMPRS CHGS & REV UNIT NOS.											

DSGN T. A. DENNIE
DRWN R.W. MANLEY
CHKD W.H. PERRY
SUPV R.E. ISSANDFORD
INSP
ENGINEER

SERVICE & OFFICE BUILDING
UNITS 1 & 2

SINGLE LINE
480V MCC SXZ
OED-EMCC-83

BELLEFONTE NUCLEAR PLANT
TENNESSEE VALLEY AUTHORITY
DIVISION OF ENGINEERING DESIGN

N

SUBMITTED	RECOMMENDED	APPROVED
Robert F. Hewitt	R. H. Herndon	John E. Hellebery

COMPANION DWG 9SW0735-ED-1
INSPECTED AND APPROVED FOR ISSUE
DESIGN PROJECT MANAGER

KNOXVILLE 12-20-74 88 E 9SW0735-ED-2 R6
RECORD DRAWING AS CONSTRUCTED

CONFIGURATION CONTROL