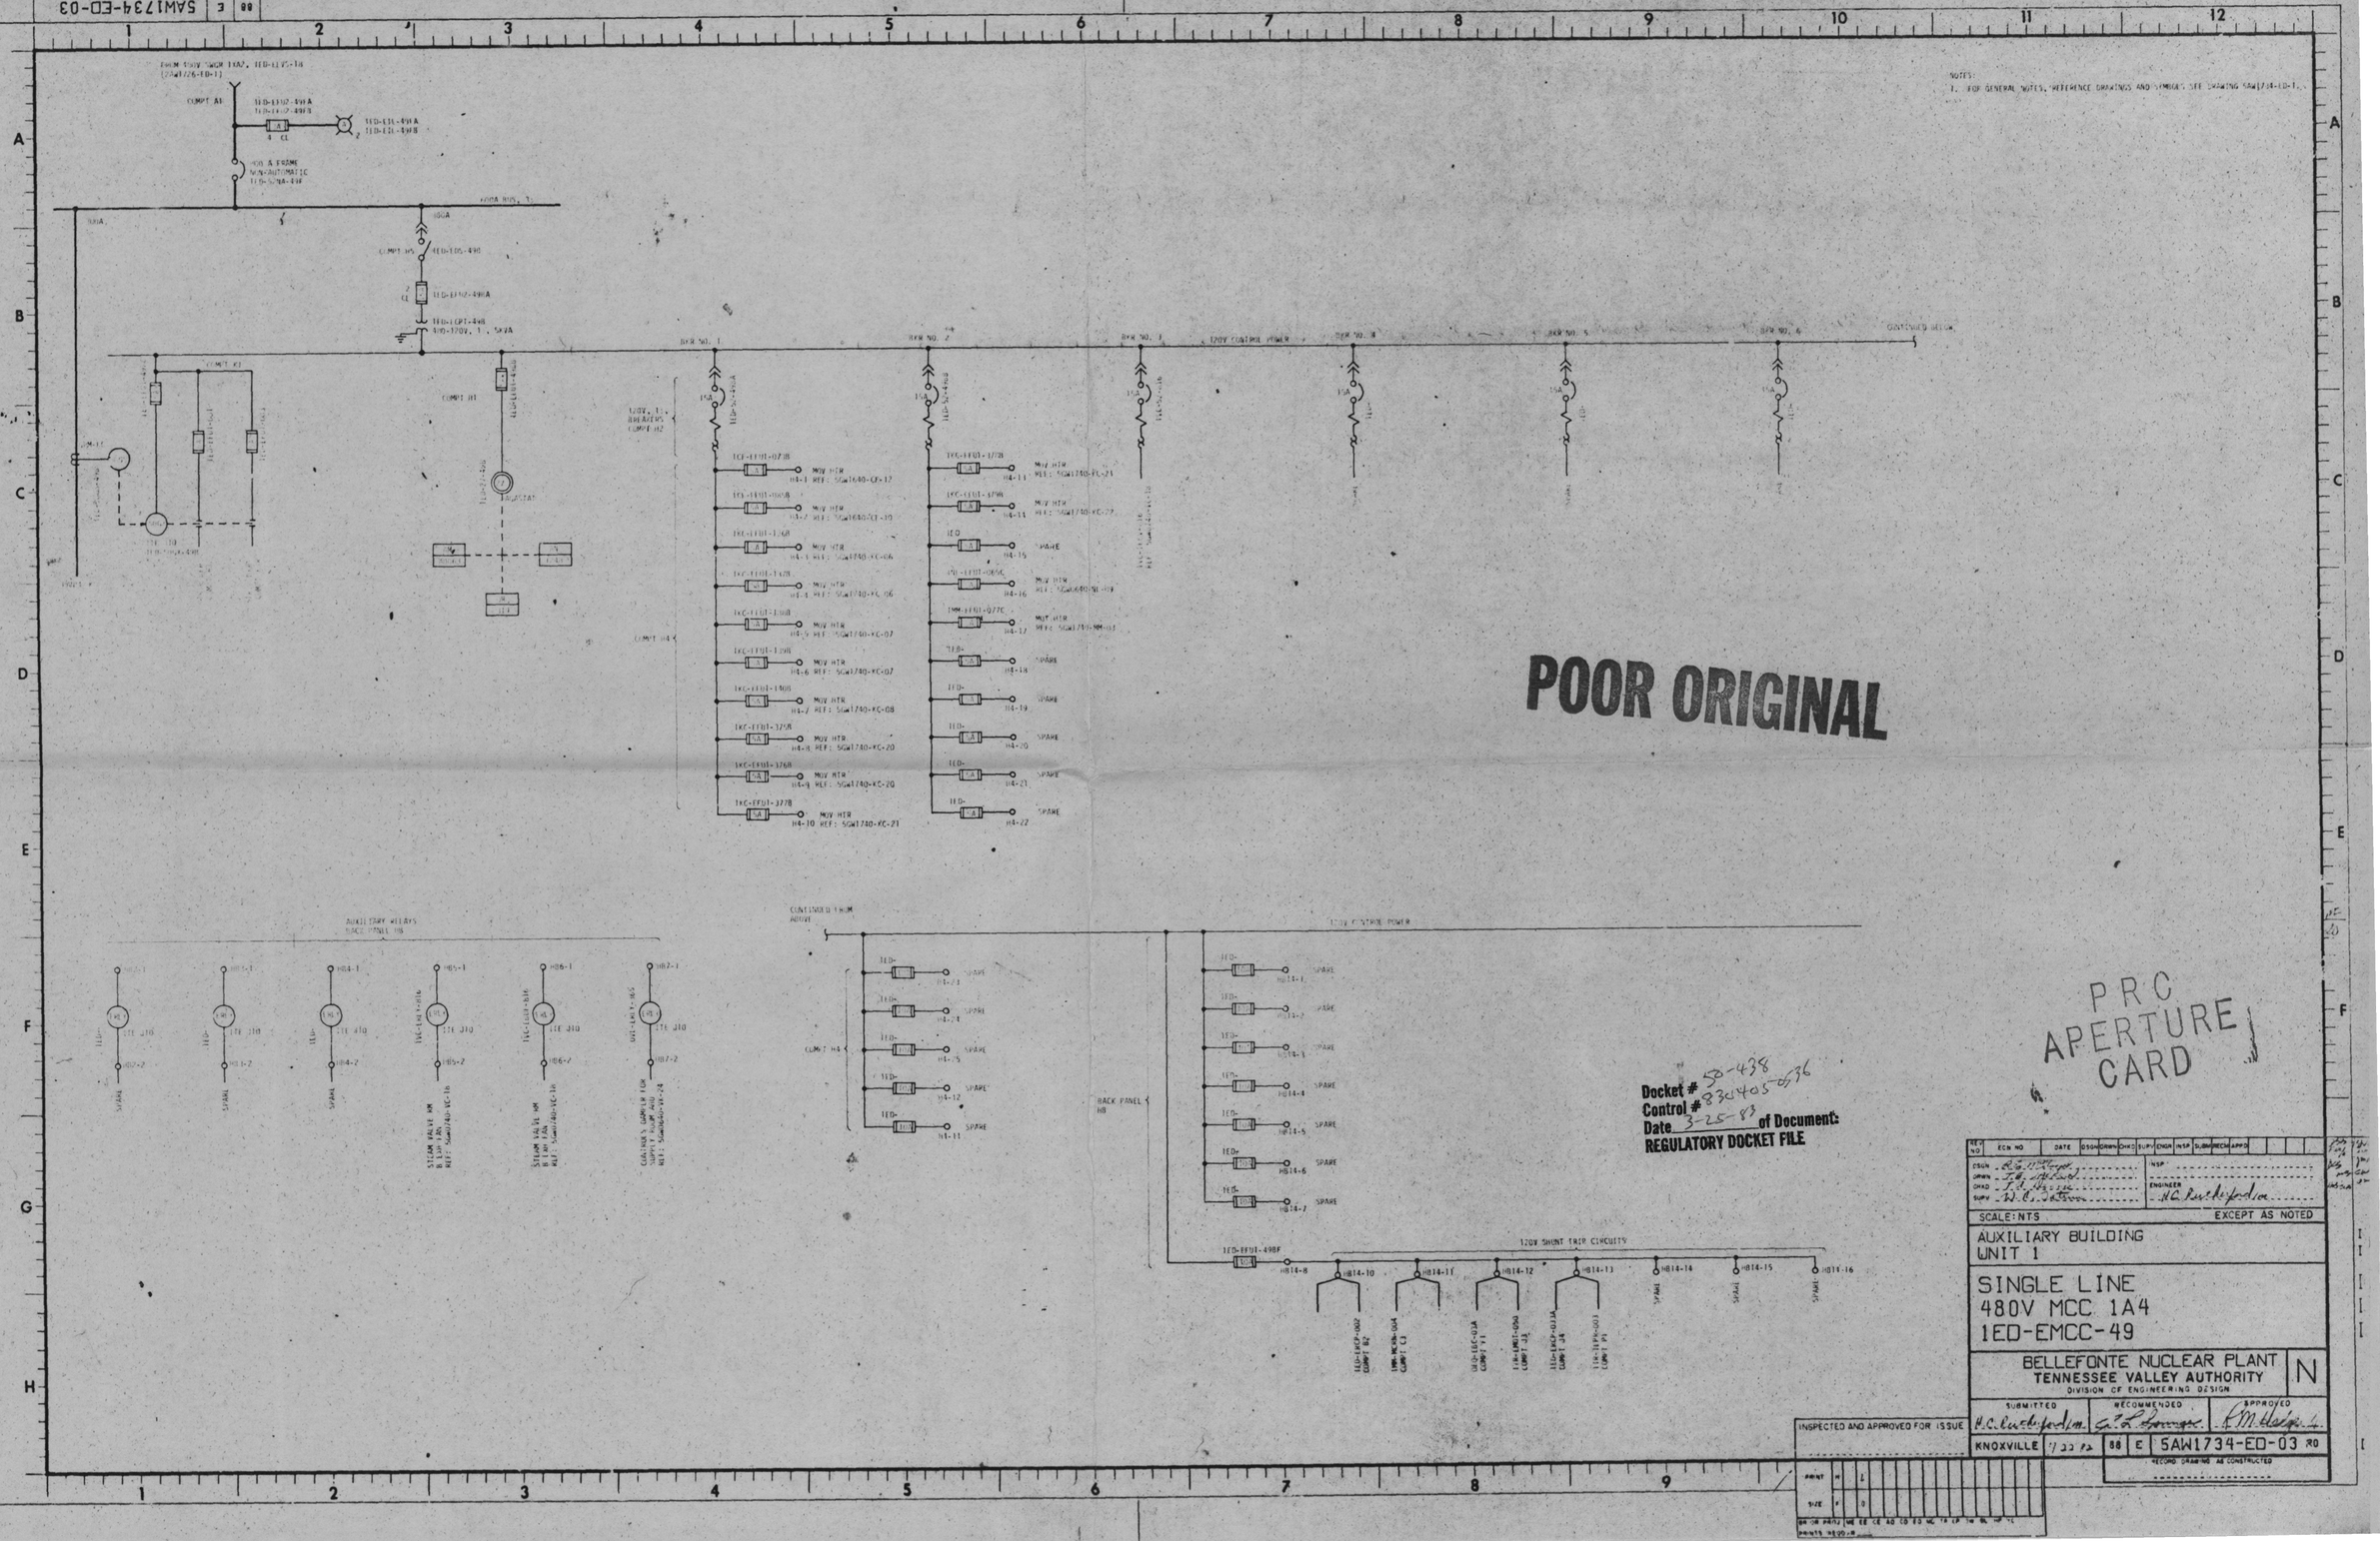


POOR ORIGINAL

PRC APERTURE CARD

Docket # 50-438
Control # 830405-0536
Date 3-25-83 of Document:
REGULATORY DOCKET FILE

| REV NO | ECN NO | DATE | DSGN | DRWN | CHKD | SUPV | ENGR | INSP | SUBM | RECM | APPD |
|---|---|---|---|---|---|---|---|---|---|---|---|

DSGN R.G. Mitchell
DRWN J.B. Mitchell
CHKD J.A. Hassell
SUPV W.C. Watson
INSP
ENGINEER H.C. Rutherford/m

SCALE: NTS EXCEPT AS NOTED

AUXILIARY BUILDING
UNIT 1

SINGLE LINE
480V MCC 1A4
1ED-EMCC-49

BELLEFONTE NUCLEAR PLANT
TENNESSEE VALLEY AUTHORITY
DIVISION OF ENGINEERING DESIGN

N

SUBMITTED H.C. Rutherford/m
RECOMMENDED G.L. Grainger
APPROVED R.M. Hedges

KNOXVILLE 7/22/82 88 E 5AW1734-ED-03 R0

RECORD DRAWING AS CONSTRUCTED

INSPECTED AND APPROVED FOR ISSUE

PRINT H L
SIZE F D