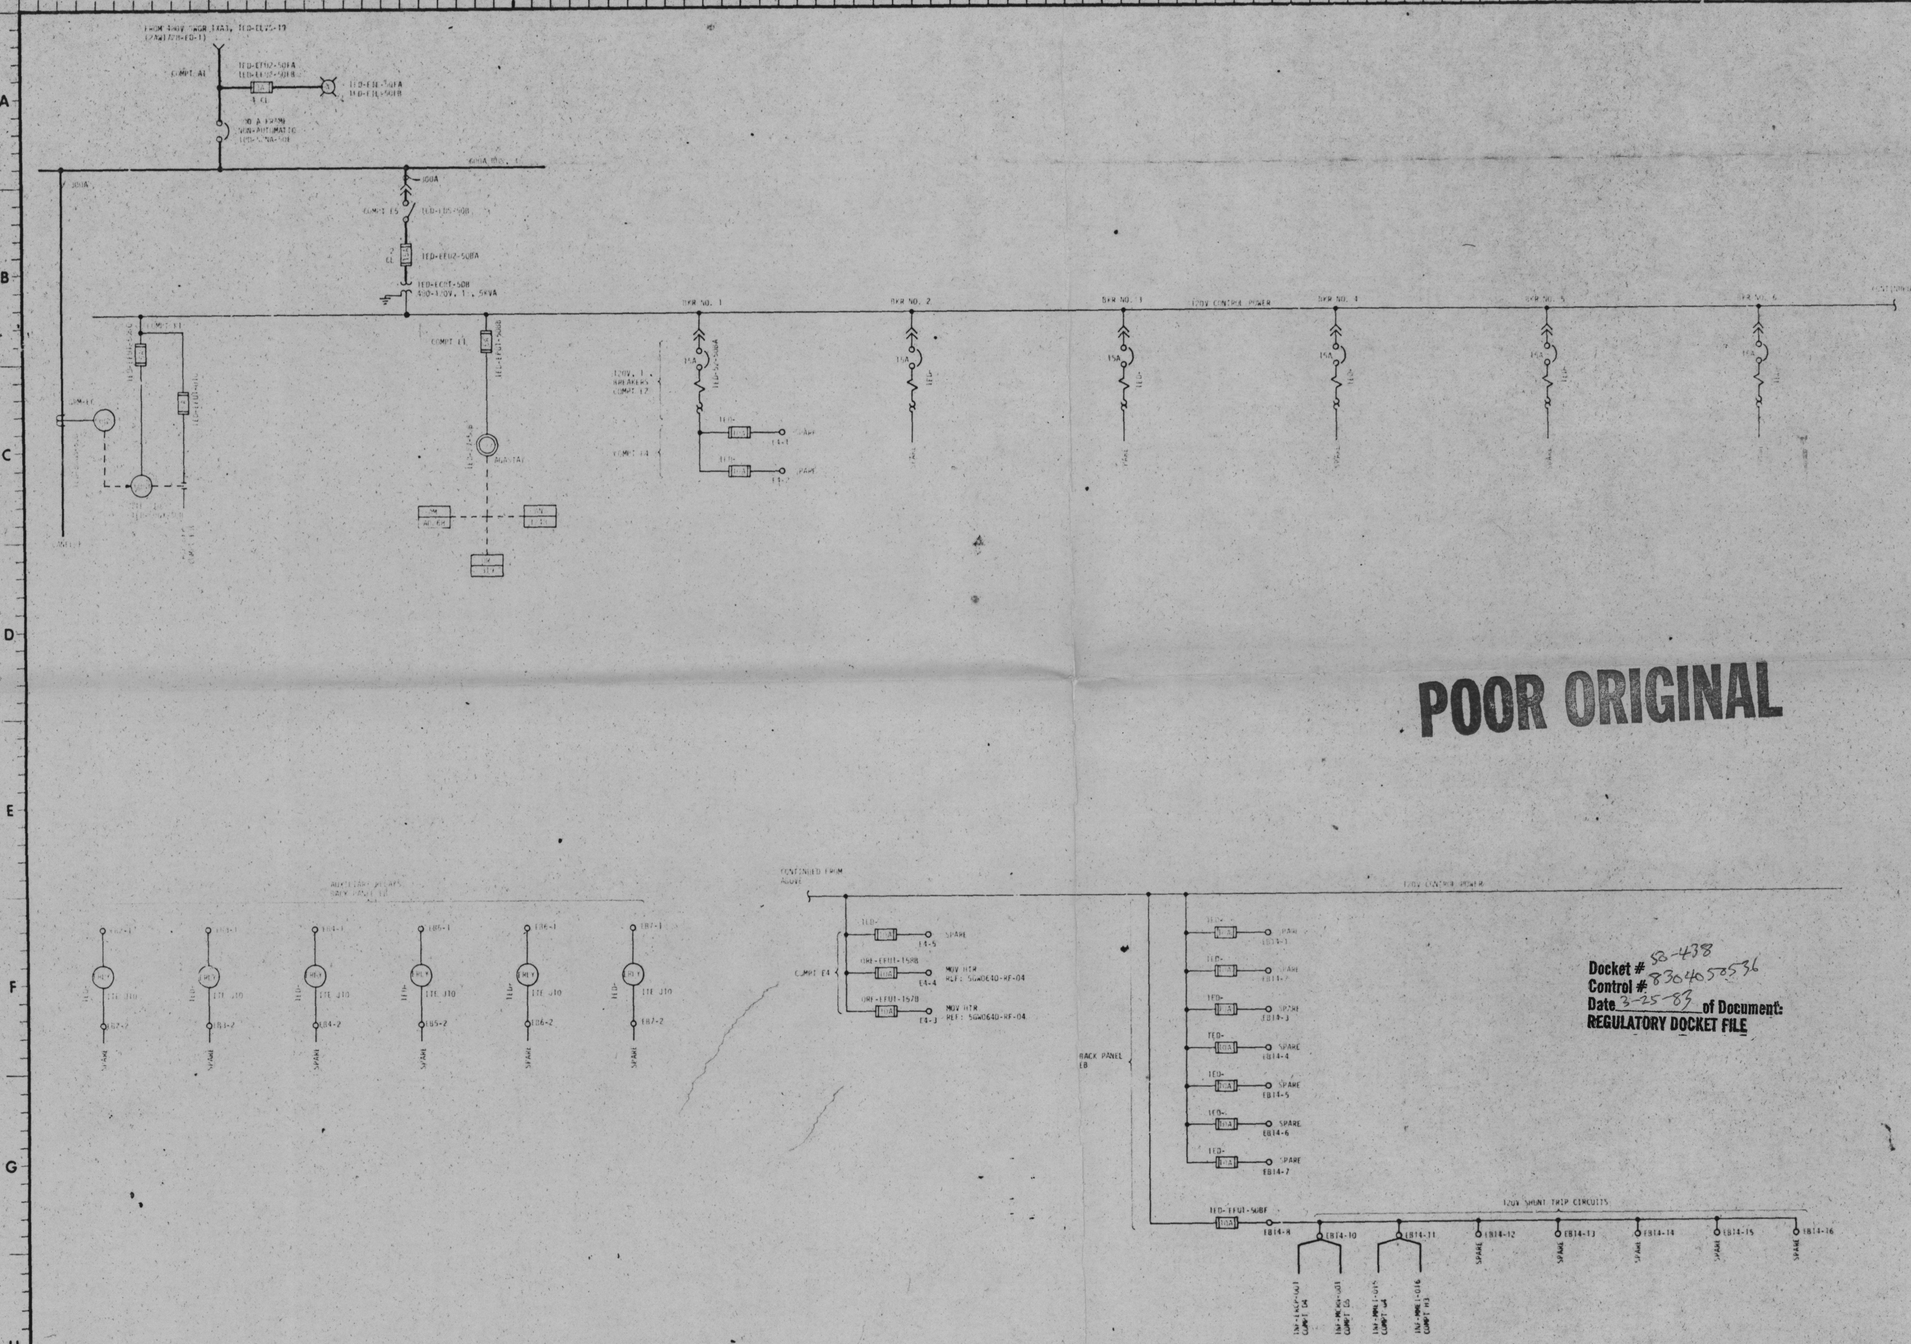

POOR ORIGINAL

Docket # 50-438
Control # 8304050536
Date 3-25-83 of Document:
REGULATORY DOCKET FILE

PRC APERTURE CARD

REV NO	ECN NO	DATE	DSGN	DRWN	CHKD	SUPV	ENGR	NSP	SUBM	RECM	APPD

DSGN
DRWN
CHKD
SUPV
NSP
ENGINEER

SCALE: NTS EXCEPT AS NOTED

AUXILIARY BUILDING
UNIT 1

SINGLE LINE
480V MCC 1A5
1ED-EMCC-50

BELLEFONTE NUCLEAR PLANT
TENNESSEE VALLEY AUTHORITY
DIVISION OF ENGINEERING DESIGN

N

SUBMITTED RECOMMENDED APPROVED

INSPECTED AND APPROVED FOR ISSUE

KNOXVILLE 88 E 5AW1736-ED-03 R0

RECORD DRAWING AS CONSTRUCTED