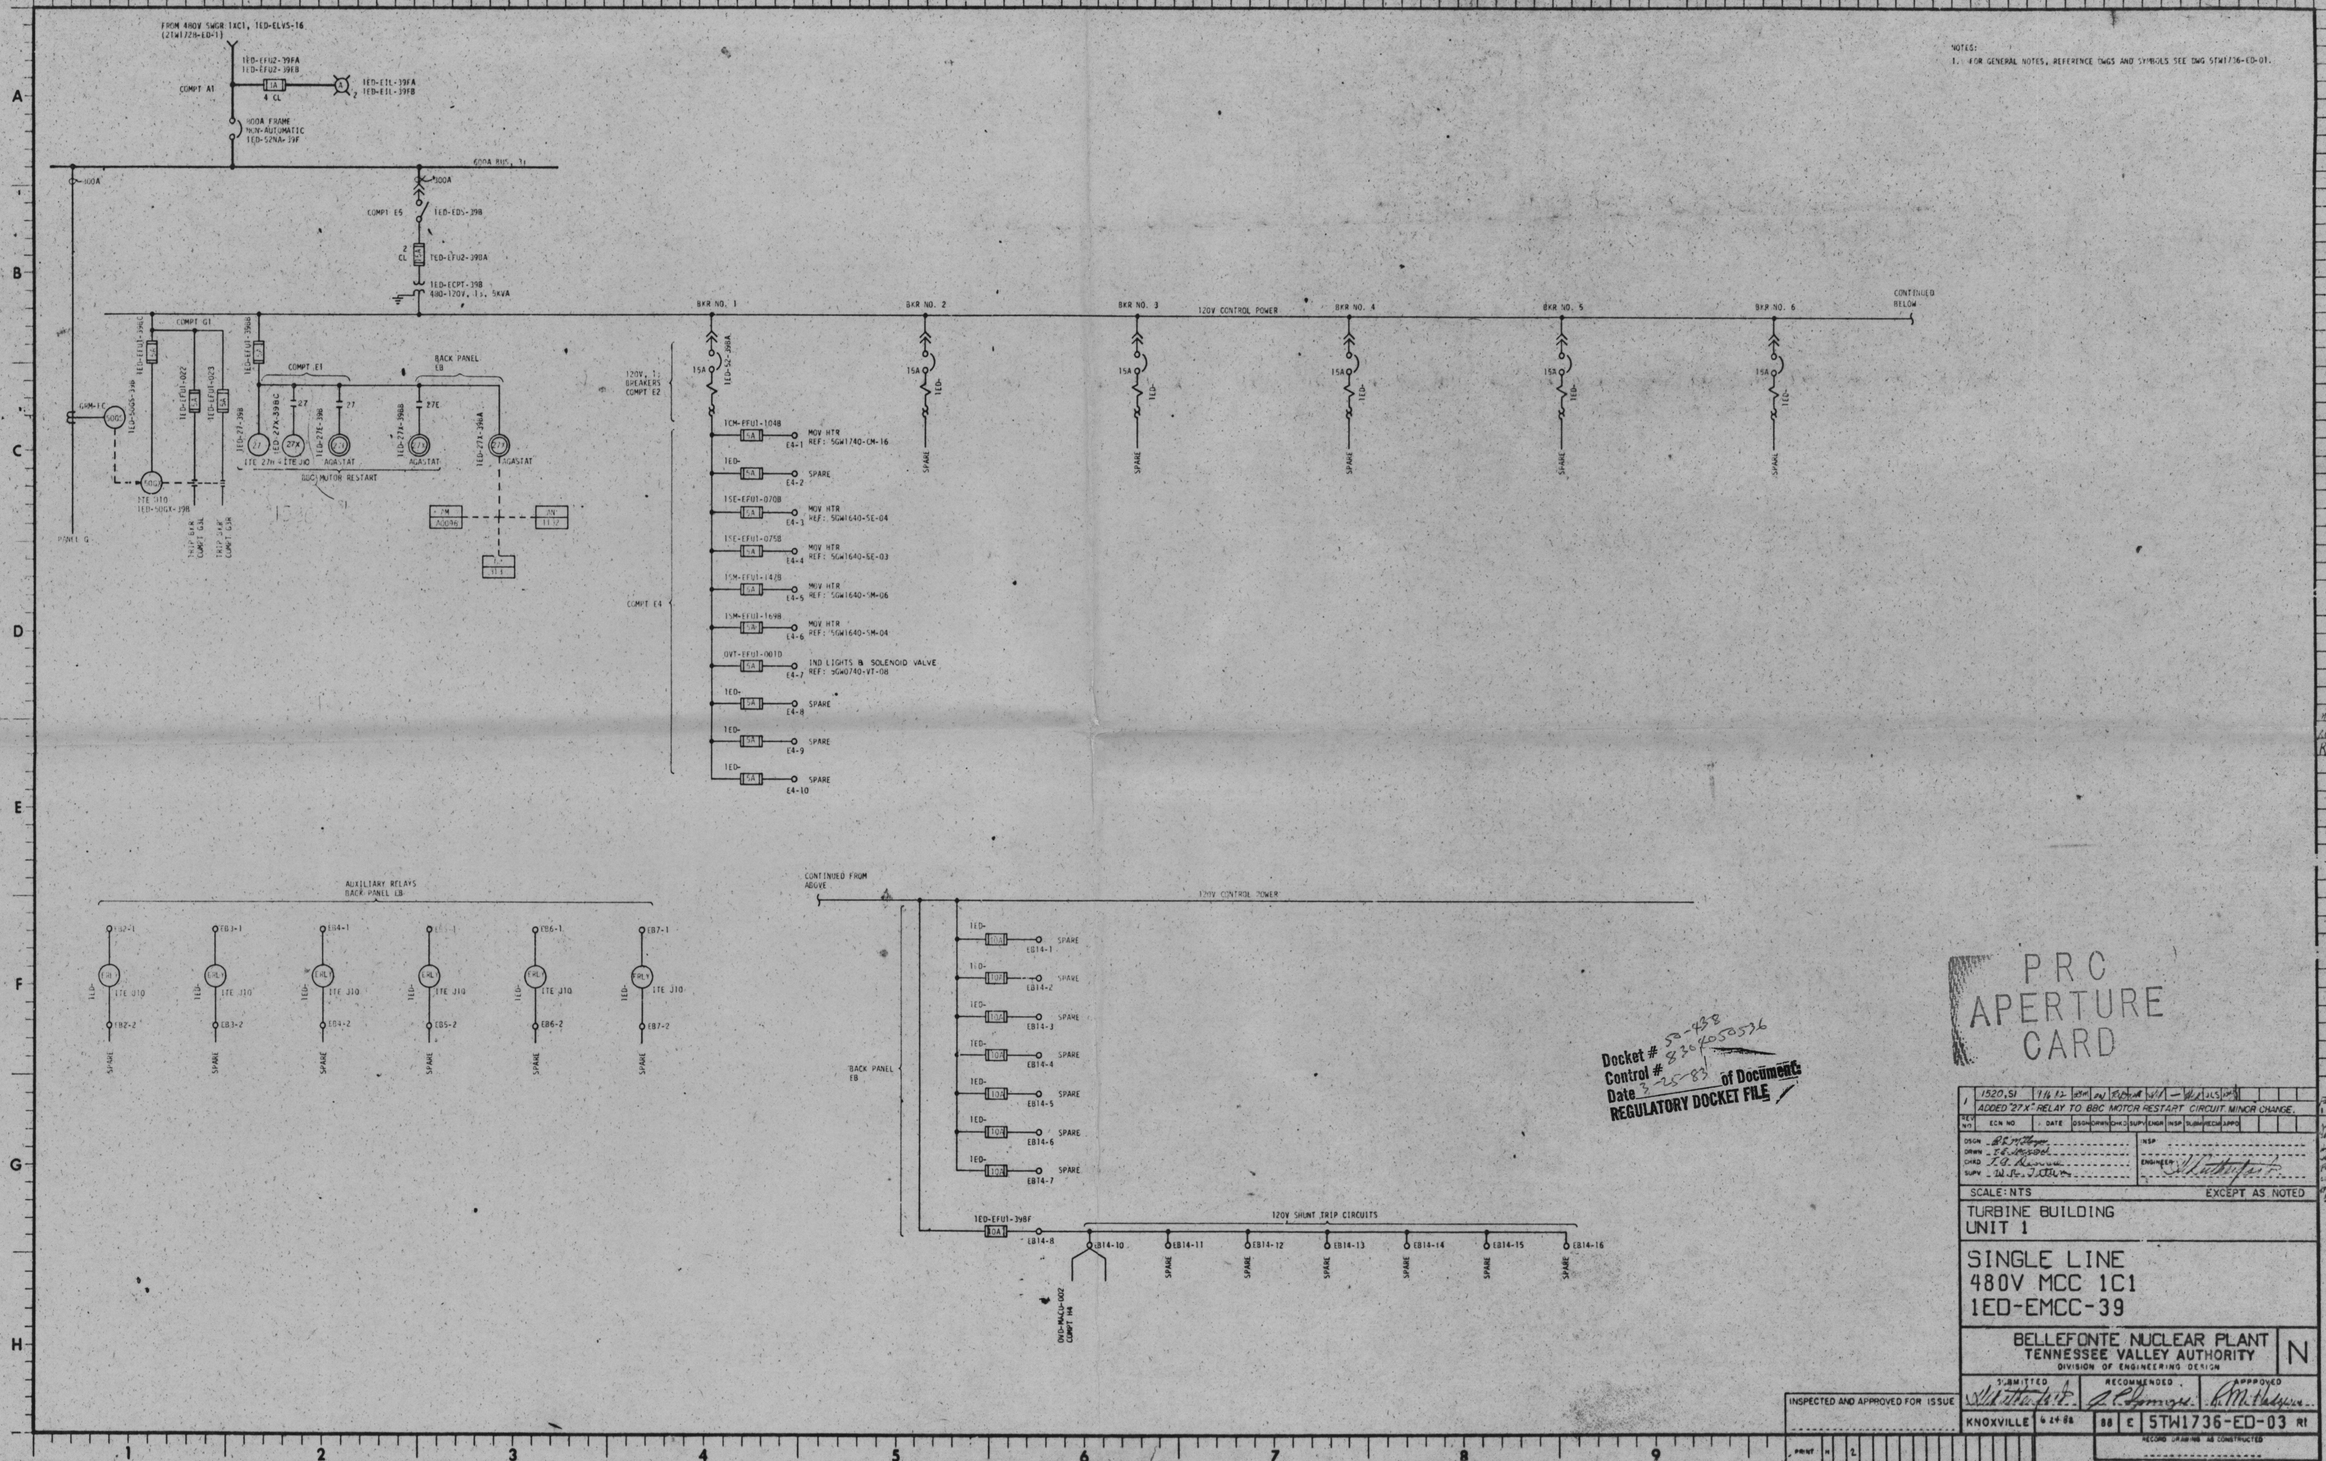

NOTES:
1. FOR GENERAL NOTES, REFERENCE DWGS AND SYMBOLS SEE DWG 5TW1736-ED-01.

Docket # 50-438
Control # 8306050536
Date 3-25-83
of Documents
REGULATORY DOCKET FILE

PRC APERTURE CARD

REV NO	ECN NO	DATE	DSGN	DRWN	CHKD	SUPV	ENGR	INSP	SUBM	RECM	APPD
1	1520.51	7/6/82	DRM	DN	RJ						

ADDED "27X" RELAY TO BBC MOTOR RESTART CIRCUIT MINOR CHANGE.

DSGN
DRWN
CHKD
SUPV
INSP
ENGINEER

SCALE: NTS — EXCEPT AS NOTED

TURBINE BUILDING
UNIT 1

SINGLE LINE
480V MCC 1C1
1ED-EMCC-39

BELLEFONTE NUCLEAR PLANT
TENNESSEE VALLEY AUTHORITY
DIVISION OF ENGINEERING DESIGN

N

SUBMITTED — RECOMMENDED — APPROVED

KNOXVILLE 6-24-82 88 E 5TW1736-ED-03 R1

RECORD DRAWING AS CONSTRUCTED

INSPECTED AND APPROVED FOR ISSUE

PRINT H 2
SIZE F 0

SR OR PROJ ME EE CE AD CD ED MD TP EP LN BL HP TC
PRINTS REQD-R