NOTES:
1. FOR GENERAL NOTES, REFERENCE DWGS AND SYMBOLS SEE DWG STW1737-ED-01.

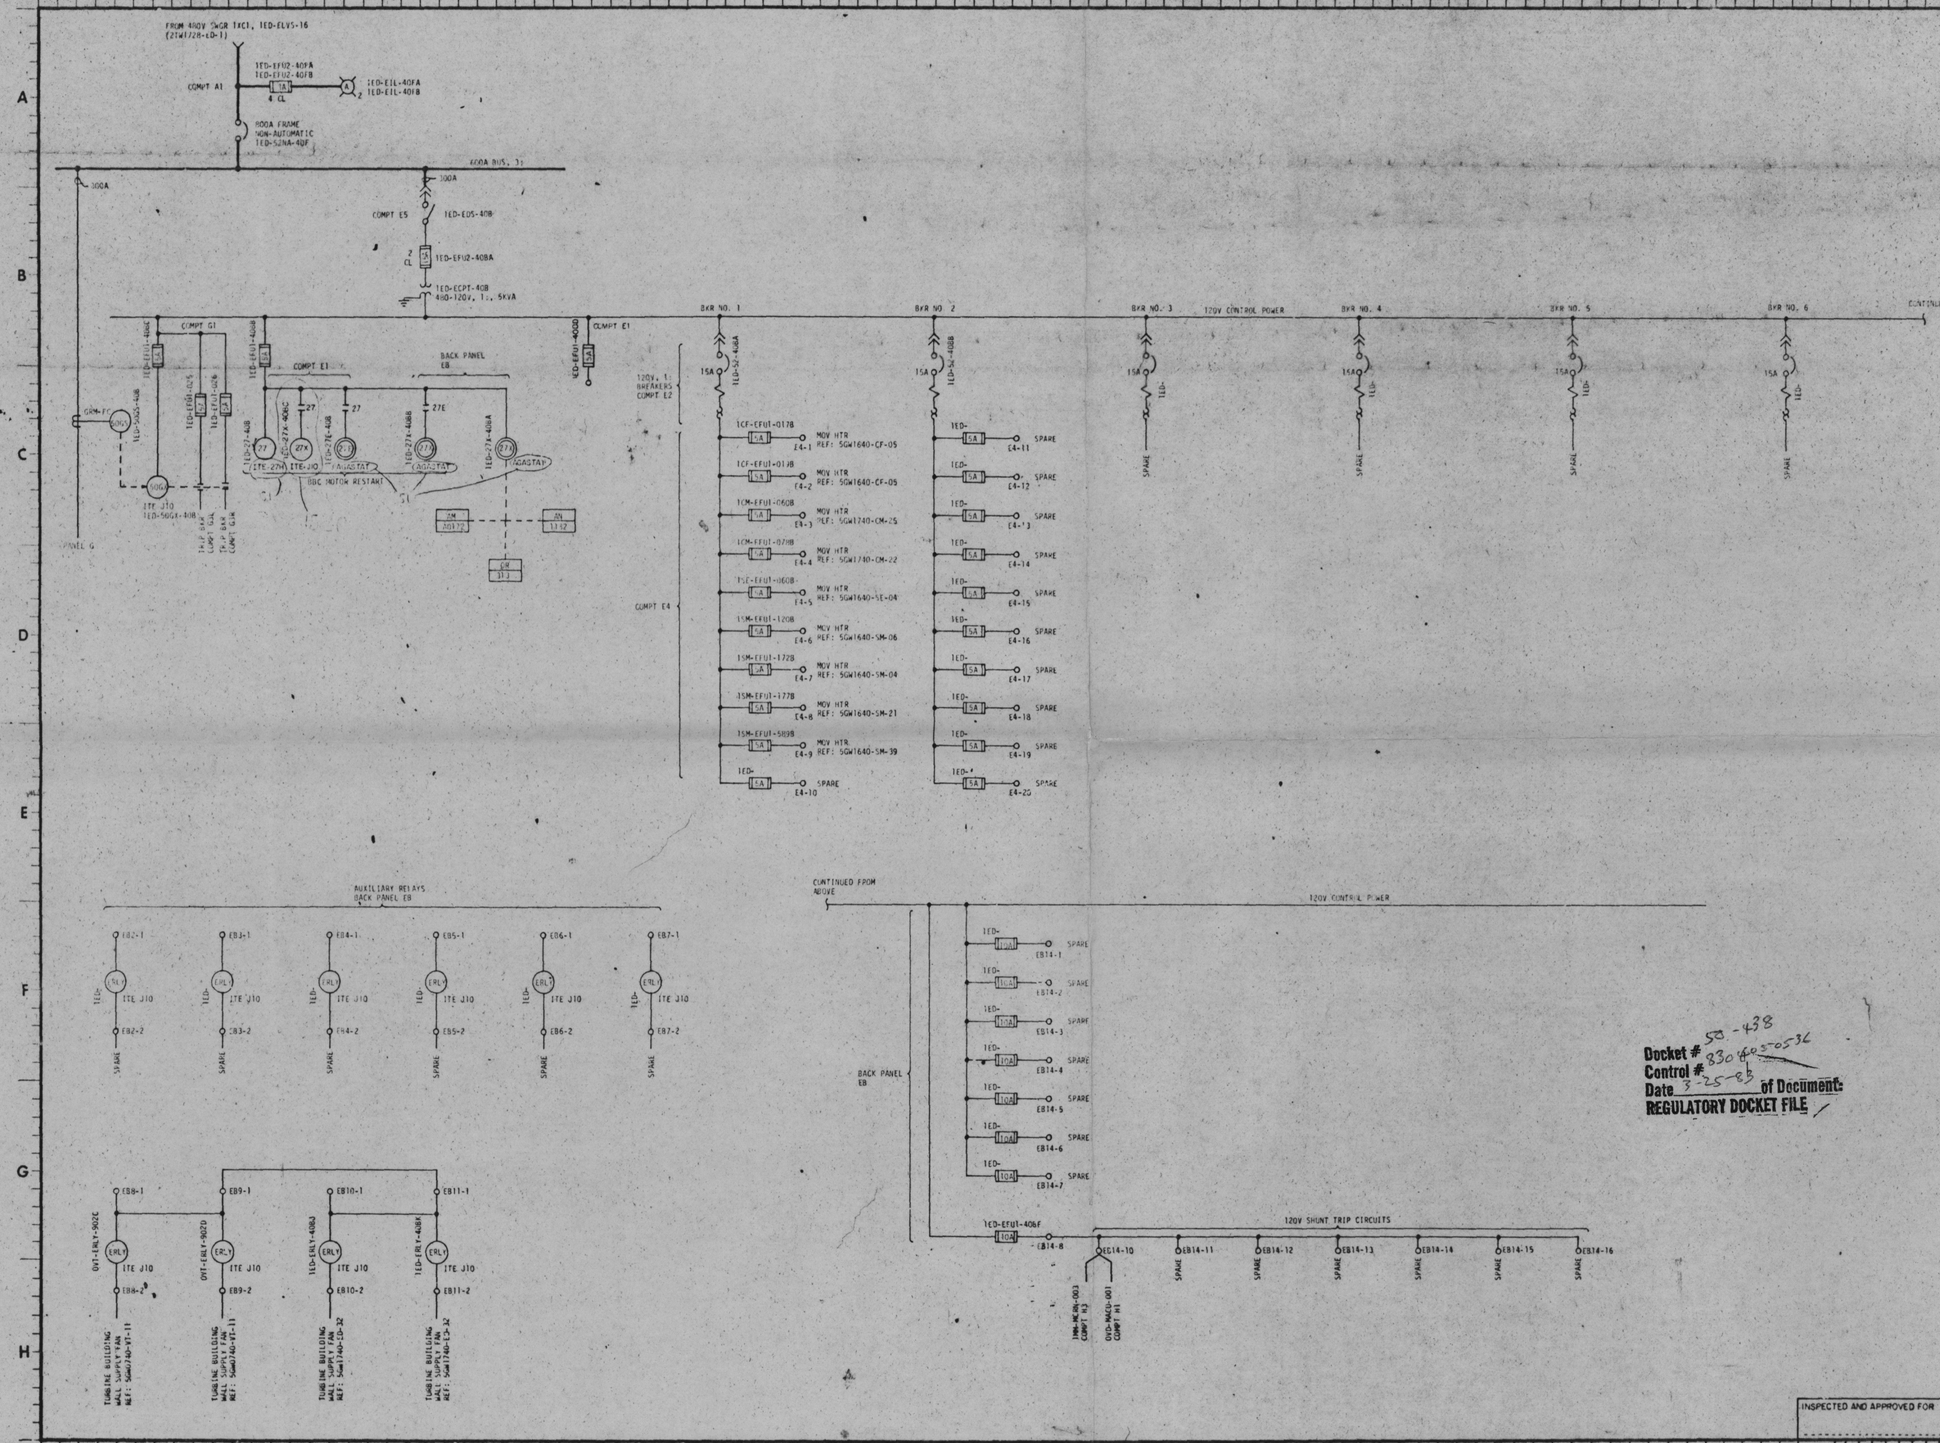

Docket # 50-438
Control # 8306050536
Date 3-25-83 of Document:
REGULATORY DOCKET FILE

PRC APERTURE CARD

REV NO	ECN NO	DATE	DSGN	DRWN	CHKD	SUPV	ENGR	INSP	SUBM	RECM	APPD
1	1520,S1	7-16-82									

ADDED "27X" RELAY TO BBC MOTOR RESTART CIRCUIT. MINOR CHANGES

DSGN
DRWN
CHKD
SUPV
WSP
ENGINEER

SCALE: NTS EXCEPT AS NOTED

TURBINE BUILDING
UNIT 1

SINGLE LINE
480V MCC 1C2
1ED-EMCC-40

BELLEFONTE NUCLEAR PLANT
TENNESSEE VALLEY AUTHORITY
DIVISION OF ENGINEERING DESIGN

N

SUBMITTED / RECOMMENDED / APPROVED

KNOXVILLE 6-24-84 88 E STW1737-ED-03 R1

RECORD DRAWING AS CONSTRUCTED

INSPECTED AND APPROVED FOR ISSUE

PRINT SIZE