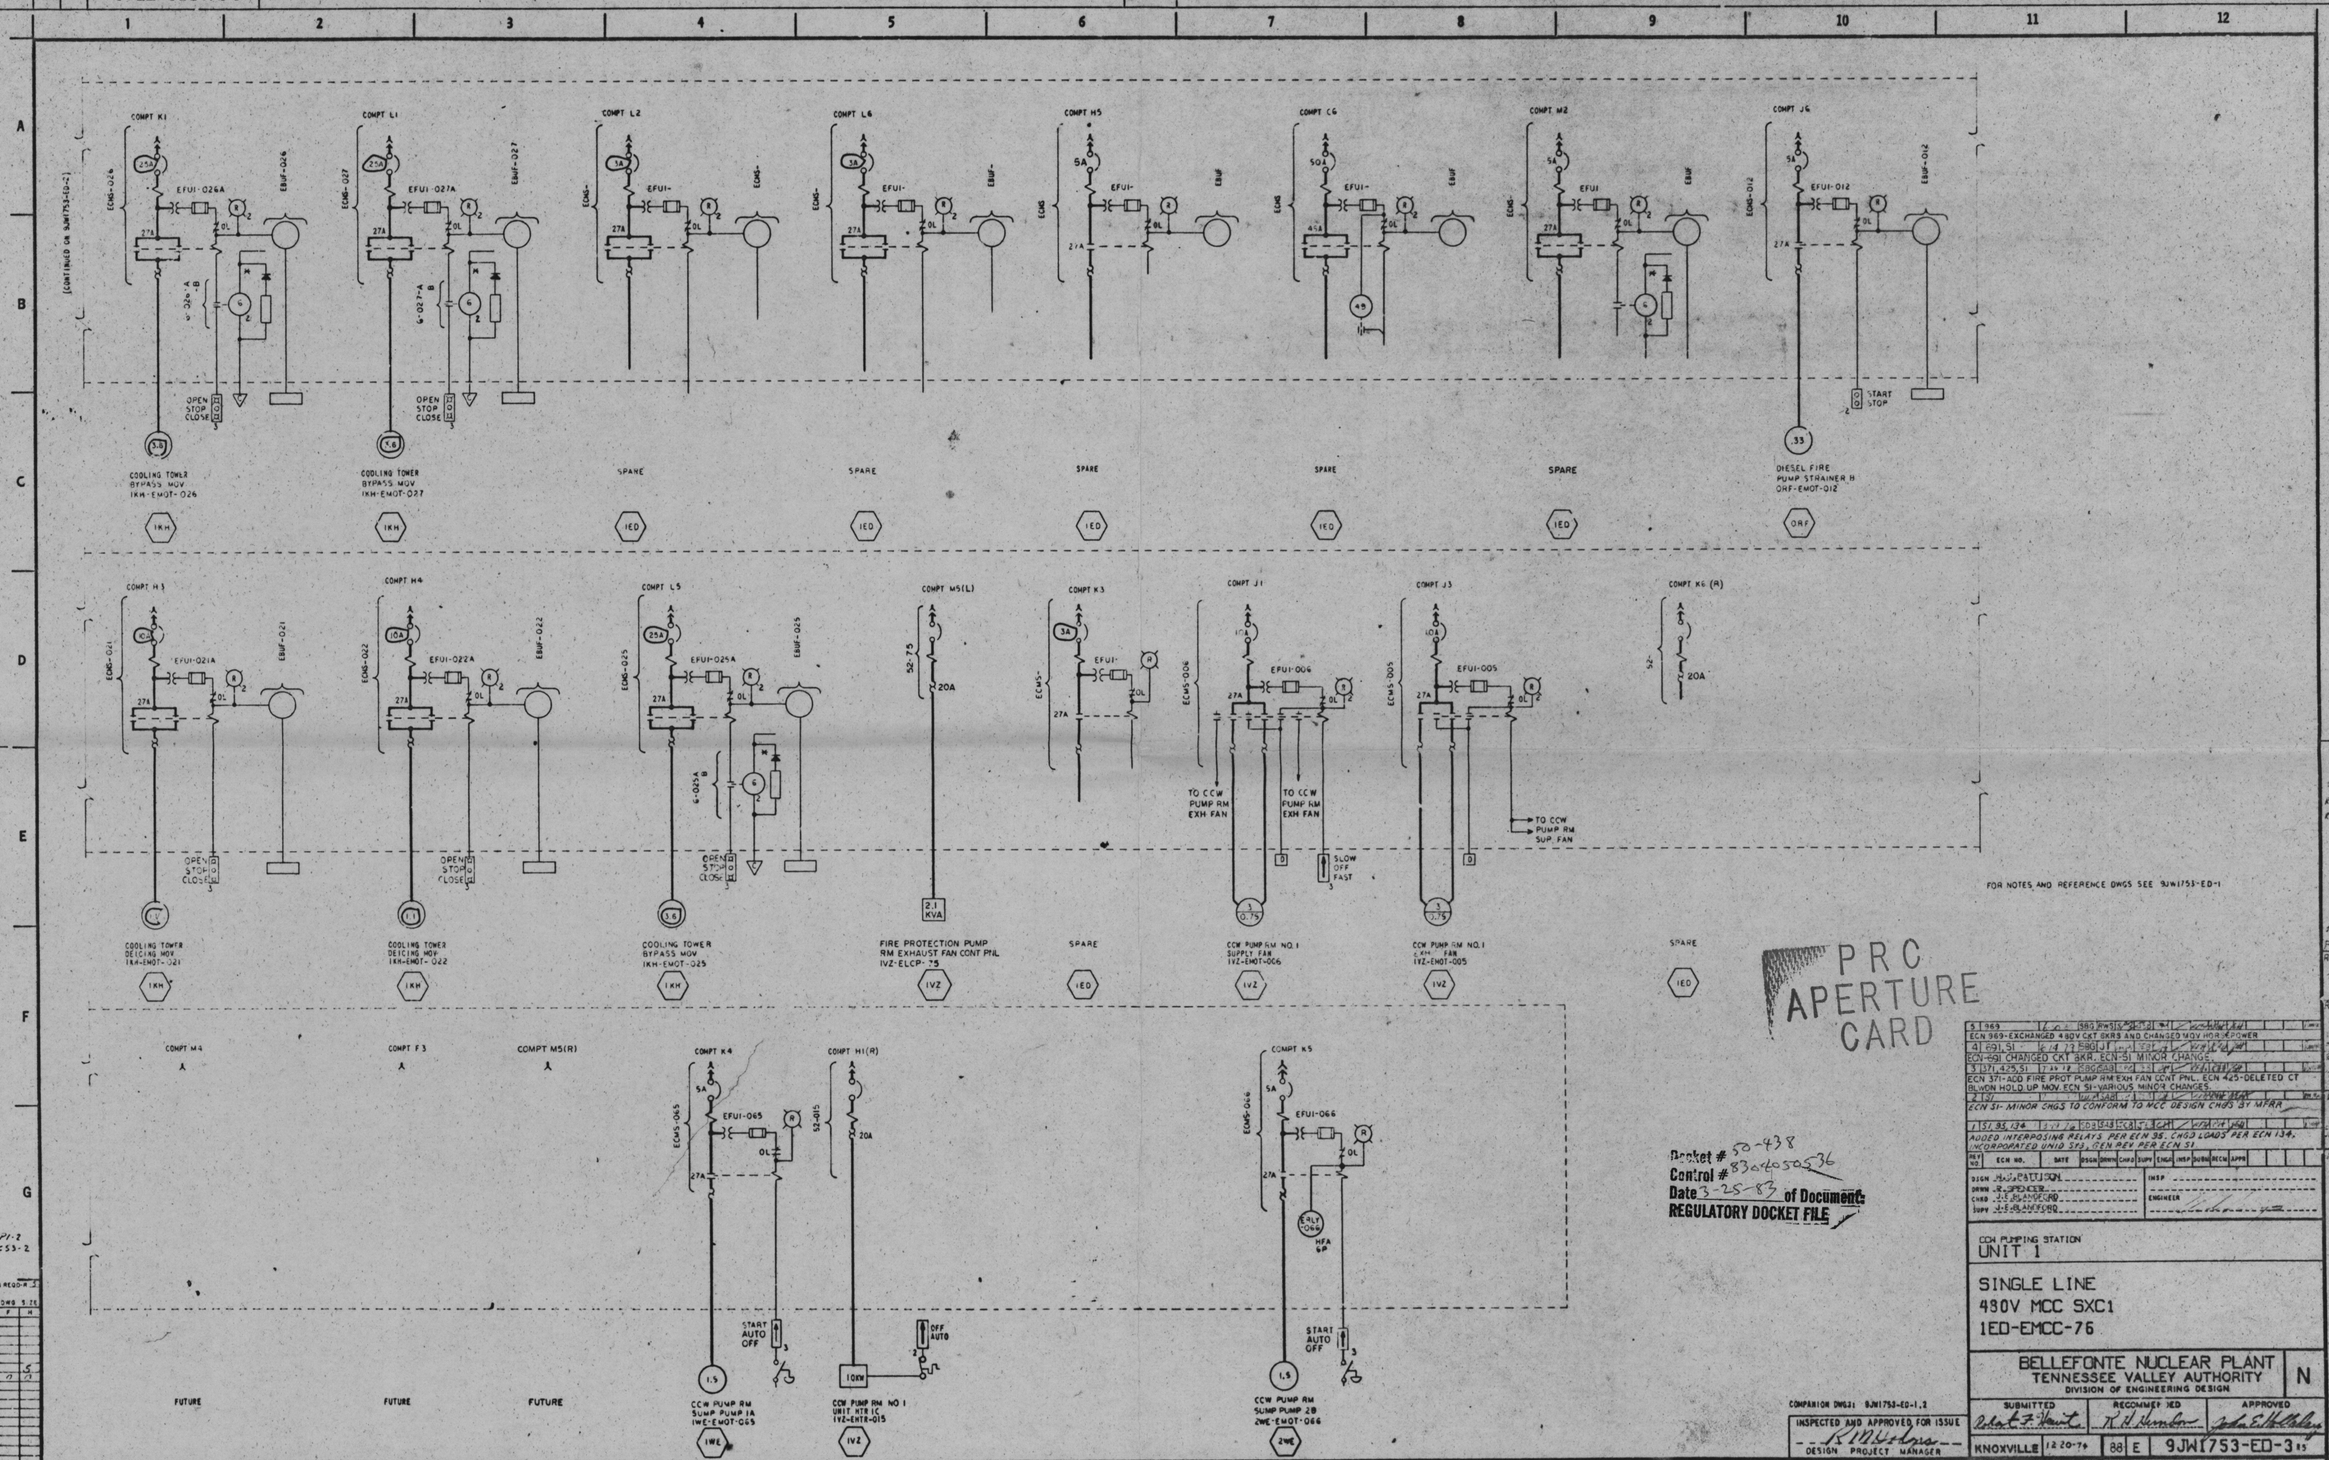

PRC APERTURE CARD

Docket # 50-438
Control # 8304050536
Date 3-25-83 of Document:
REGULATORY DOCKET FILE

REV NO.	ECN NO.	DATE	DSGN	DRWN	CHKD	SUPV	ENGR	INSP	SUBM	RECM	APPR
5	969	6-20-83	SBG	RWS							
4	691, 51	6-14-79	SBG	JT							
3	371, 425, 51	7-24-78	SBG	SAB							
2	51										
1	51, 95, 134	3-17-76	SDB	SAB	CB						

ECN 969-EXCHANGED 480V CKT BKRS AND CHANGED MOV HORSEPOWER
ECN-691 CHANGED CKT BKR. ECN-51 MINOR CHANGE.
ECN 371-ADD FIRE PROT PUMP RM EXH FAN CONT PNL. ECN 425-DELETED CT BLWDN HOLD UP MOV. ECN 51-VARIOUS MINOR CHANGES.
ECN 51- MINOR CHGS TO CONFORM TO MCC DESIGN CHGS BY MFRR
ADDED INTERPOSING RELAYS PER ECN 95. CHGD LOADS PER ECN 134. INCORPORATED UNIT STS. GEN REV PER ECN 51

DSGN H.G. PATTISON
DRWN R. SPENCER
CHKD J.E. BLANDFORD
SUPV J.E. BLANDFORD
INSP
ENGINEER

CCW PUMPING STATION
UNIT 1

SINGLE LINE
480V MCC SXC1
1ED-EMCC-76

BELLEFONTE NUCLEAR PLANT
TENNESSEE VALLEY AUTHORITY
DIVISION OF ENGINEERING DESIGN

N

SUBMITTED: Robert F. Hewitt
RECOMMENDED: R.H. Hendon
APPROVED: John E. Holladay

COMPANION DWGS: 9JW1753-ED-1,2

INSPECTED AND APPROVED FOR ISSUE
R.M. Hodges
DESIGN PROJECT MANAGER

KNOXVILLE 12-20-74 | 88 | E | 9JW1753-ED-3 R5


